


B-213

RECORD OF SURVEY  
FOR RALPH STURDEVANT  
IN THE NE 1/4 OF SEC. 5, T4N, R4W, W.M.  
COLUMBIA COUNTY, OREGON  
SCALE 1"=100' JUNE 2, 1993

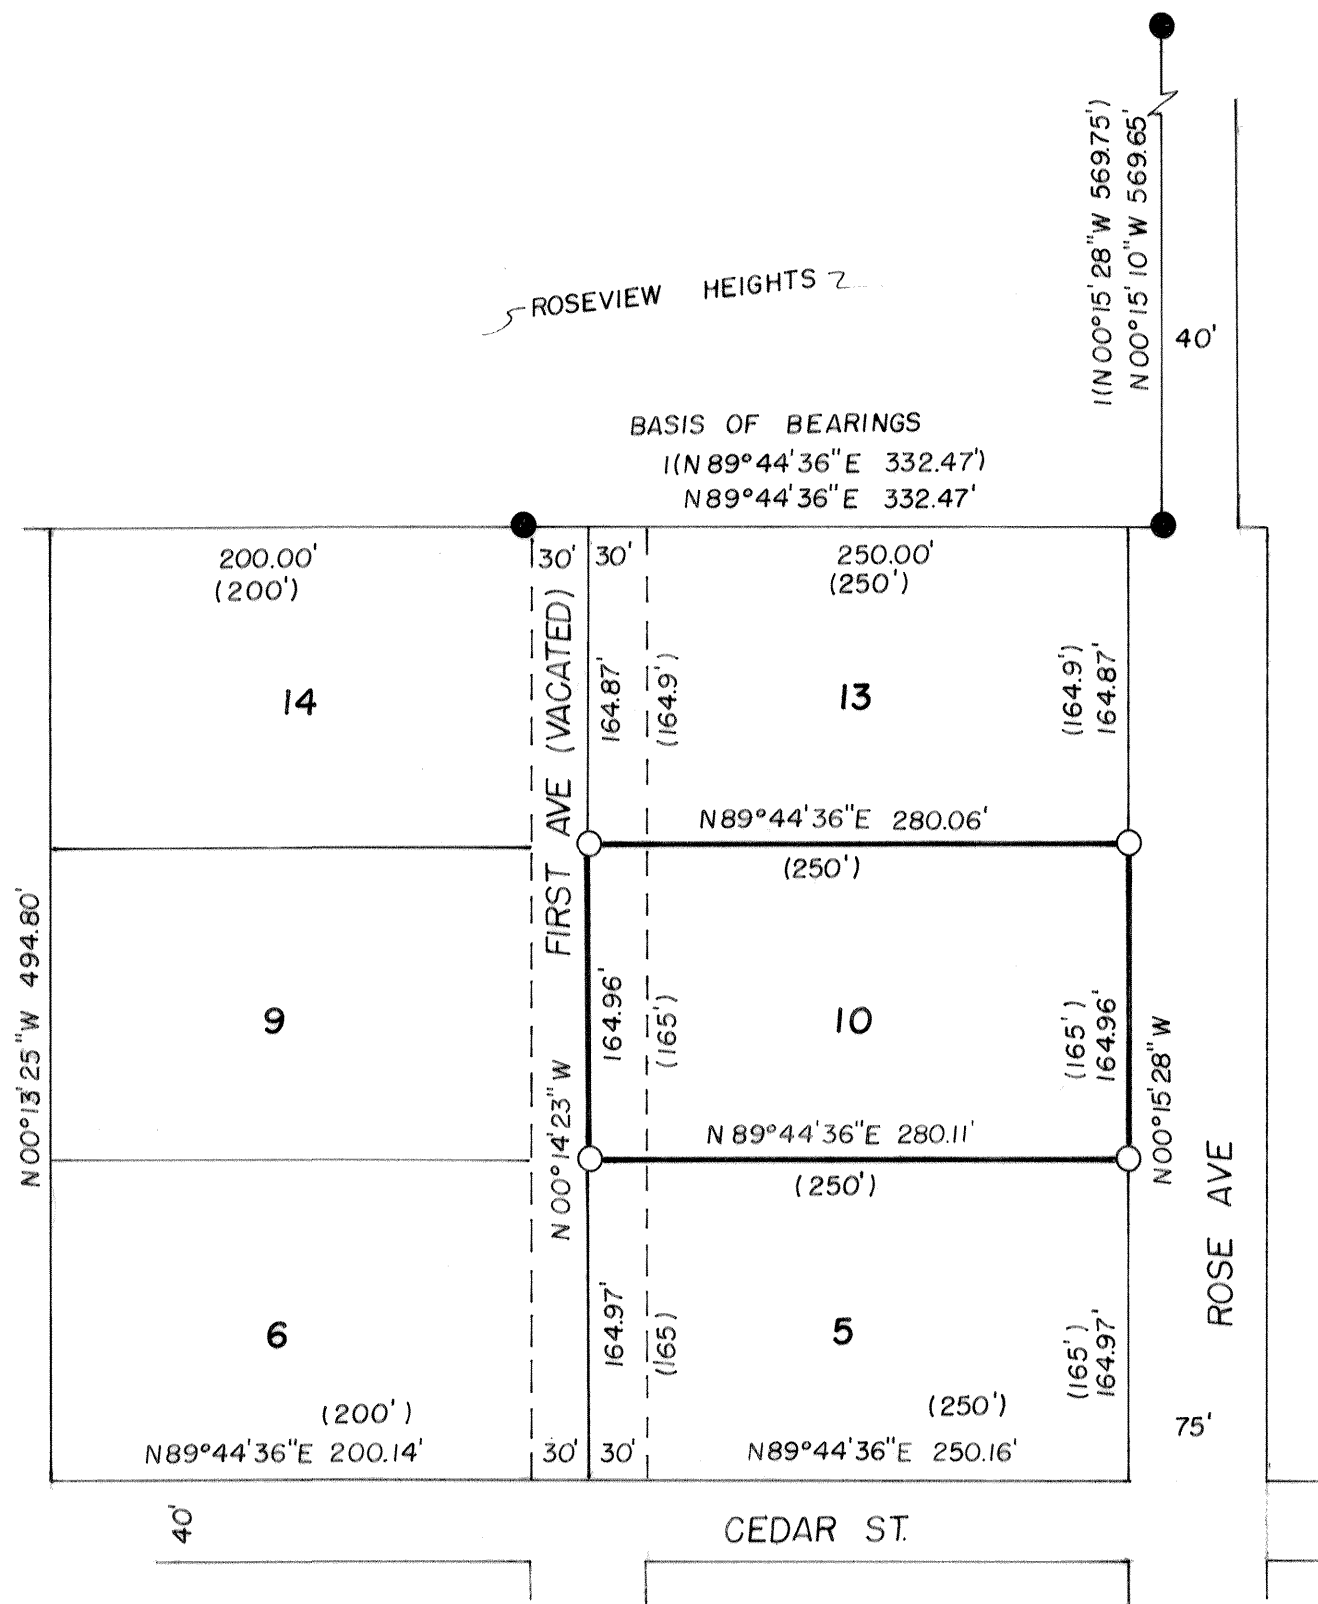

NARRATIVE: FOR CONTROL I TIED TO THE SOUTH AND EAST LINES OF ROSEVIEW HEIGHTS AND HELD THE RECORD BEARINGS AND DISTANCES FROM RS# B-78. THE BASIS OF BEARINGS IS THE SOUTH LINE OF ROSEVIEW HEIGHTS AS SHOWN.

THIS SURVEY WAS ACCOMPLISHED TO IDENTIFY THE BOUNDARIES OF LOT 10 IN EVERGREEN PARK OF VERNONIA, OREGON.

LEGEND

- - FOUND A 5/8" IRON ROD WITH KEENON CAP
- - SET A 5/8" X 30" IRON ROD WITH A YELLOW PLASTIC CAP MARKED "KEENON LS 1080"
- ( ) - RECORD DATA - EVERGREEN PARK 1 = ROSEVIEW HEIGHTS
- RS - RECORD SURVEY #

COUNTY SURVEYOR

RECEIVED

FILED

COUNTY SURVEYOR

RECEIVED 6-7-93

FILED 9-2-93

L JERRY KEENON  
1311 ALDER ST.  
VERNONIA, OREGON 97064  
PH# 429-6115

REGISTERED  
PROFESSIONAL  
LAND SURVEYOR

OREGON  
JULY 30, 1976  
LESLIE G. KEENON  
1080

EXP 12/31/93

DRAWN BY: DON. WALLACE

B-213