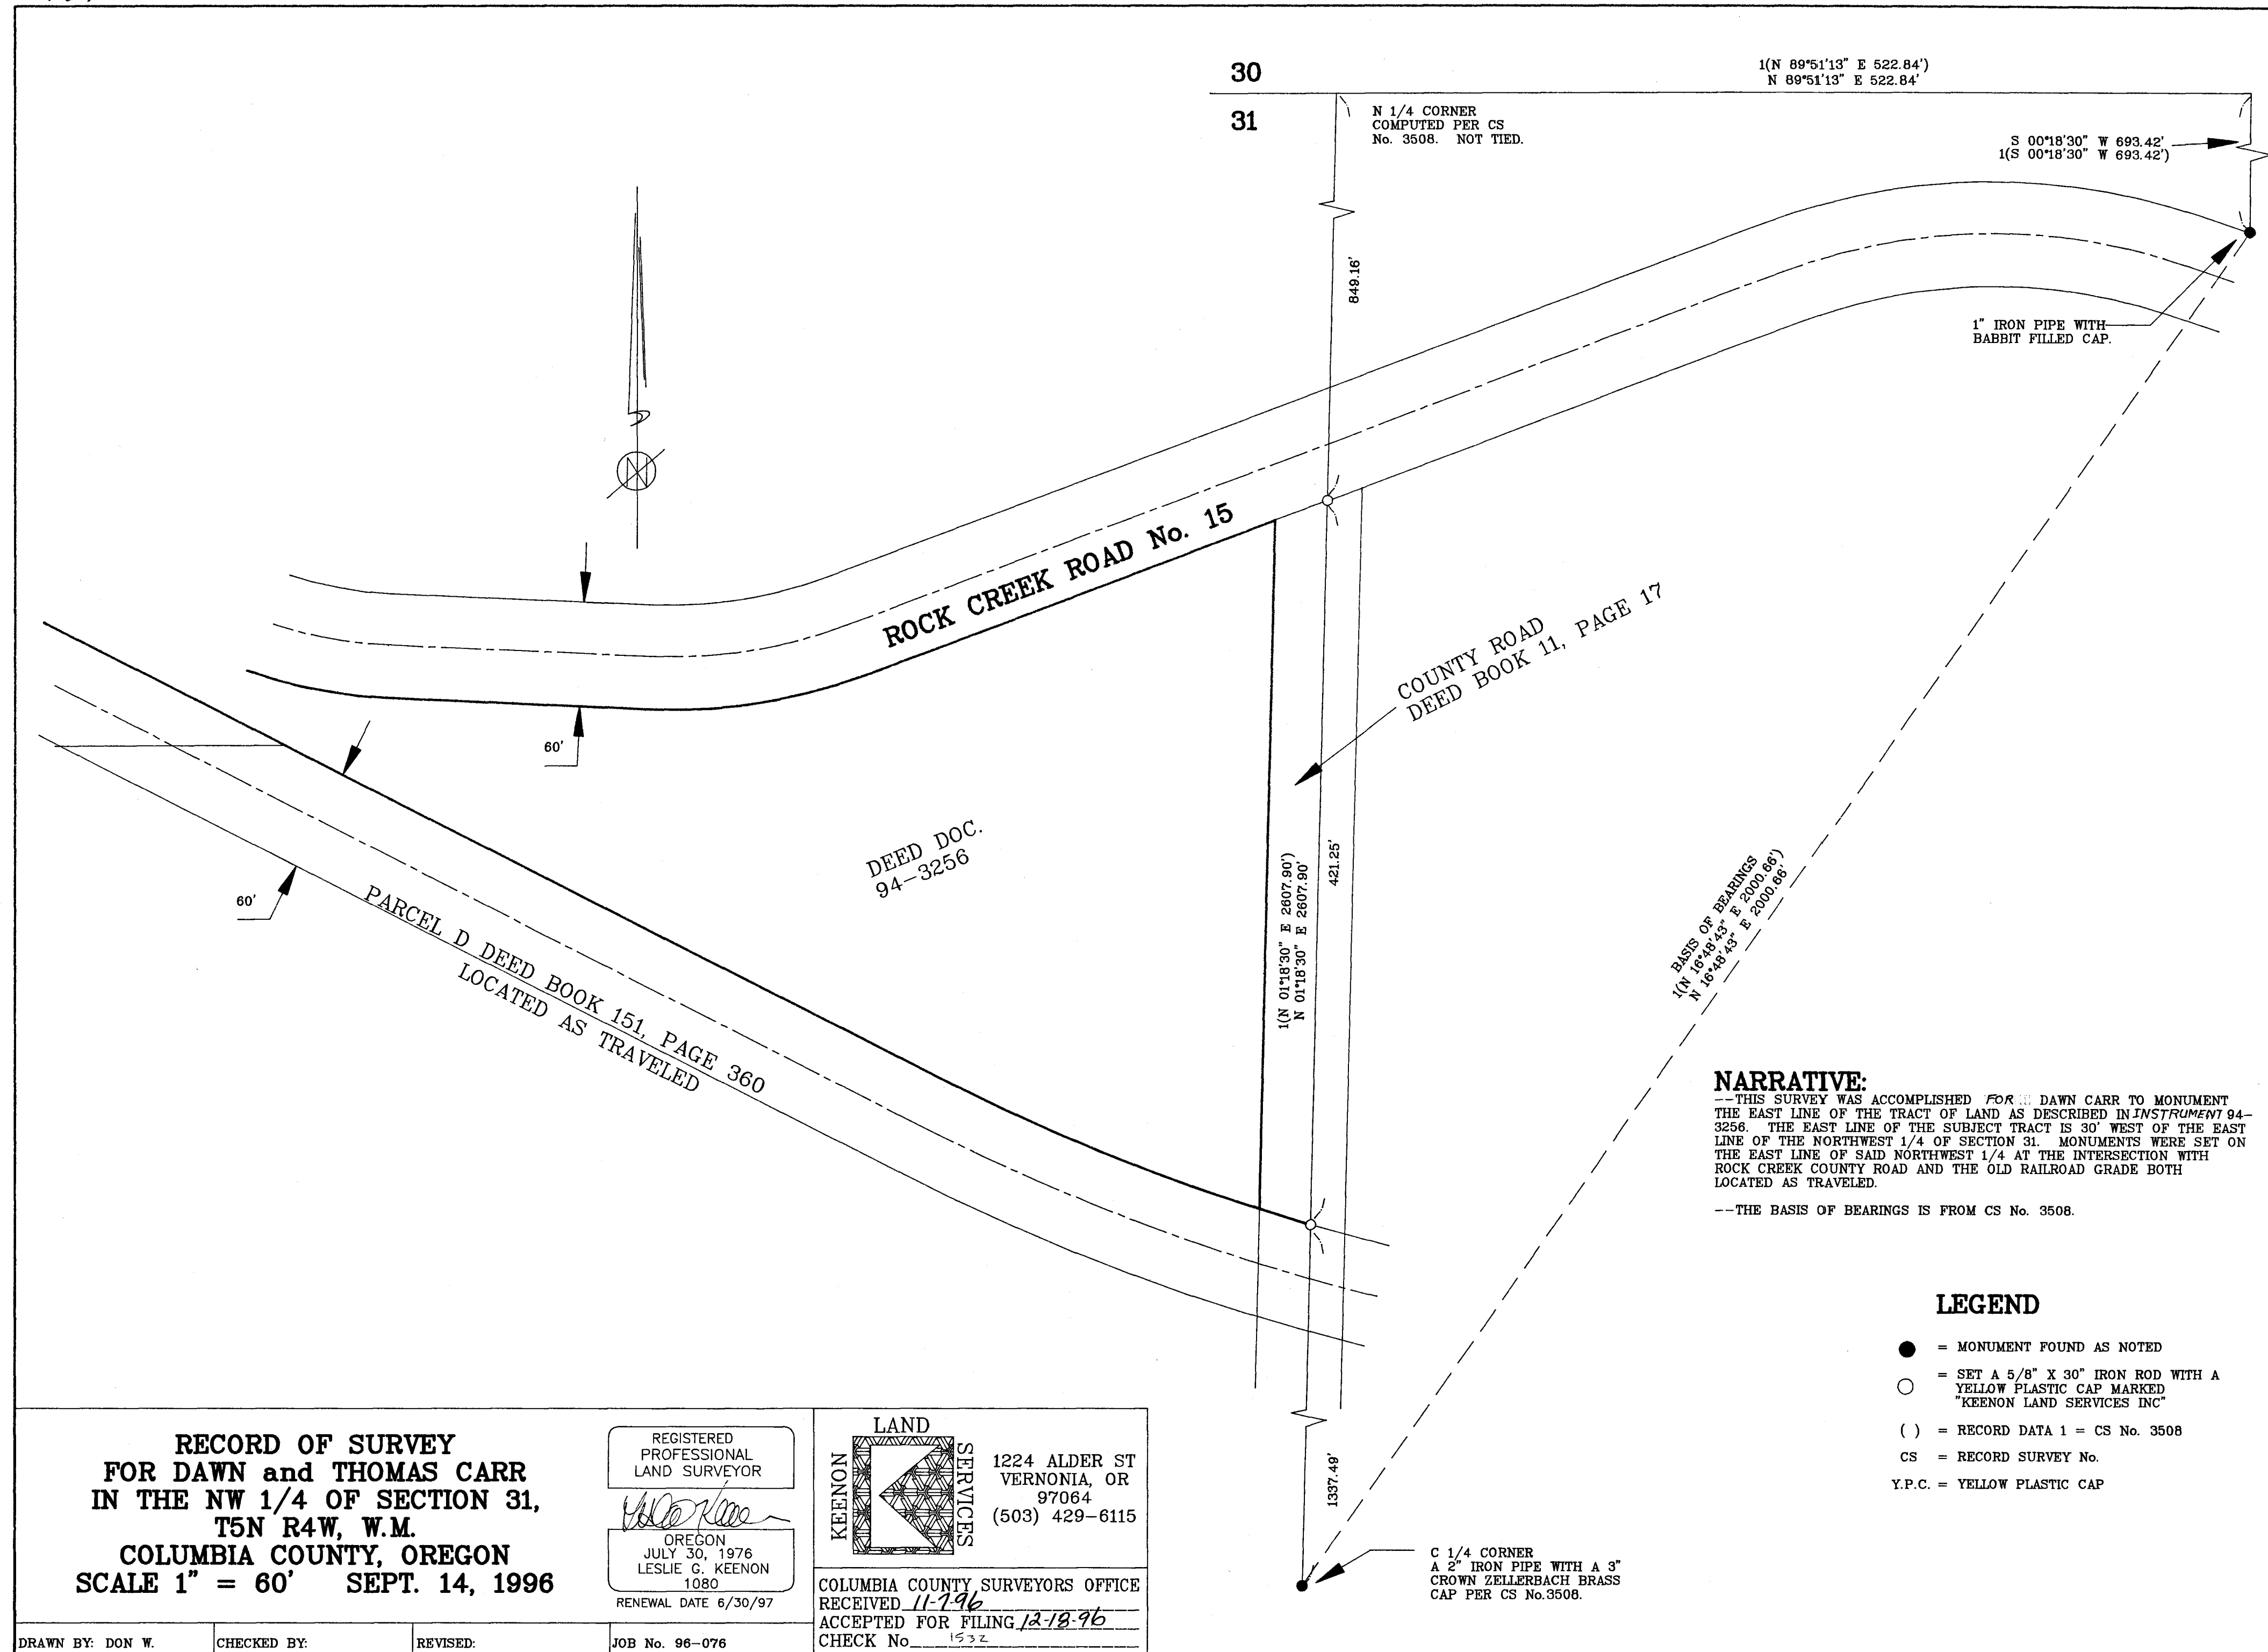


1617

**NARRATIVE:**

--THIS SURVEY WAS ACCOMPLISHED FOR DAWN CARR TO MONUMENT THE EAST LINE OF THE TRACT OF LAND AS DESCRIBED IN INSTRUMENT 94-3256. THE EAST LINE OF THE SUBJECT TRACT IS 30' WEST OF THE EAST LINE OF THE NORTHWEST 1/4 OF SECTION 31. MONUMENTS WERE SET ON THE EAST LINE OF SAID NORTHWEST 1/4 AT THE INTERSECTION WITH ROCK CREEK COUNTY ROAD AND THE OLD RAILROAD GRADE BOTH LOCATED AS TRAVELED.


--THE BASIS OF BEARINGS IS FROM CS No. 3508.

LEGEND

- = MONUMENT FOUND AS NOTED
- = SET A 5/8" X 30" IRON ROD WITH A YELLOW PLASTIC CAP MARKED "KEENON LAND SERVICES INC"
- () = RECORD DATA 1 = CS No. 3508
- CS = RECORD SURVEY No.
- Y.P.C. = YELLOW PLASTIC CAP

RECORD OF SURVEY
FOR DAWN and THOMAS CARR
IN THE NW 1/4 OF SECTION 31,
T5N R4W, W.M.
COLUMBIA COUNTY, OREGON
SCALE 1" = 60' SEPT. 14, 1996

REGISTERED
 PROFESSIONAL
 LAND SURVEYOR
Leslie G. Keenon
 OREGON
 JULY 30, 1976
 LESLIE G. KEENON
 1080
 RENEWAL DATE 6/30/97

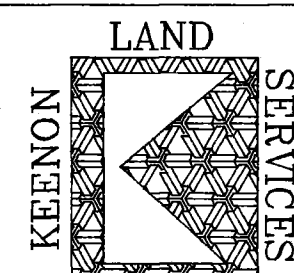

1224 ALDER ST
 VERNONIA, OR
 97064
 (503) 429-6115

COLUMBIA COUNTY SURVEYORS OFFICE
 RECEIVED 11-7-96
 ACCEPTED FOR FILING 12-18-96
 CHECK No. 1532

DRAWN BY: DON W.

CHECKED BY:

REVISED:

JOB No. 96-076