


RECORD OF SURVEY
FOR ED MUELLER
IN LOTS 13-16, BLOCK 6, FIRST ADDITION TO RIVERVIEW LOTS
IN THE NW 1/4 OF SEC 3, T4N, R4W, W.M.
COLUMBIA COUNTY, OREGON
SCALE 1" = 50' SEPT 26, 1994

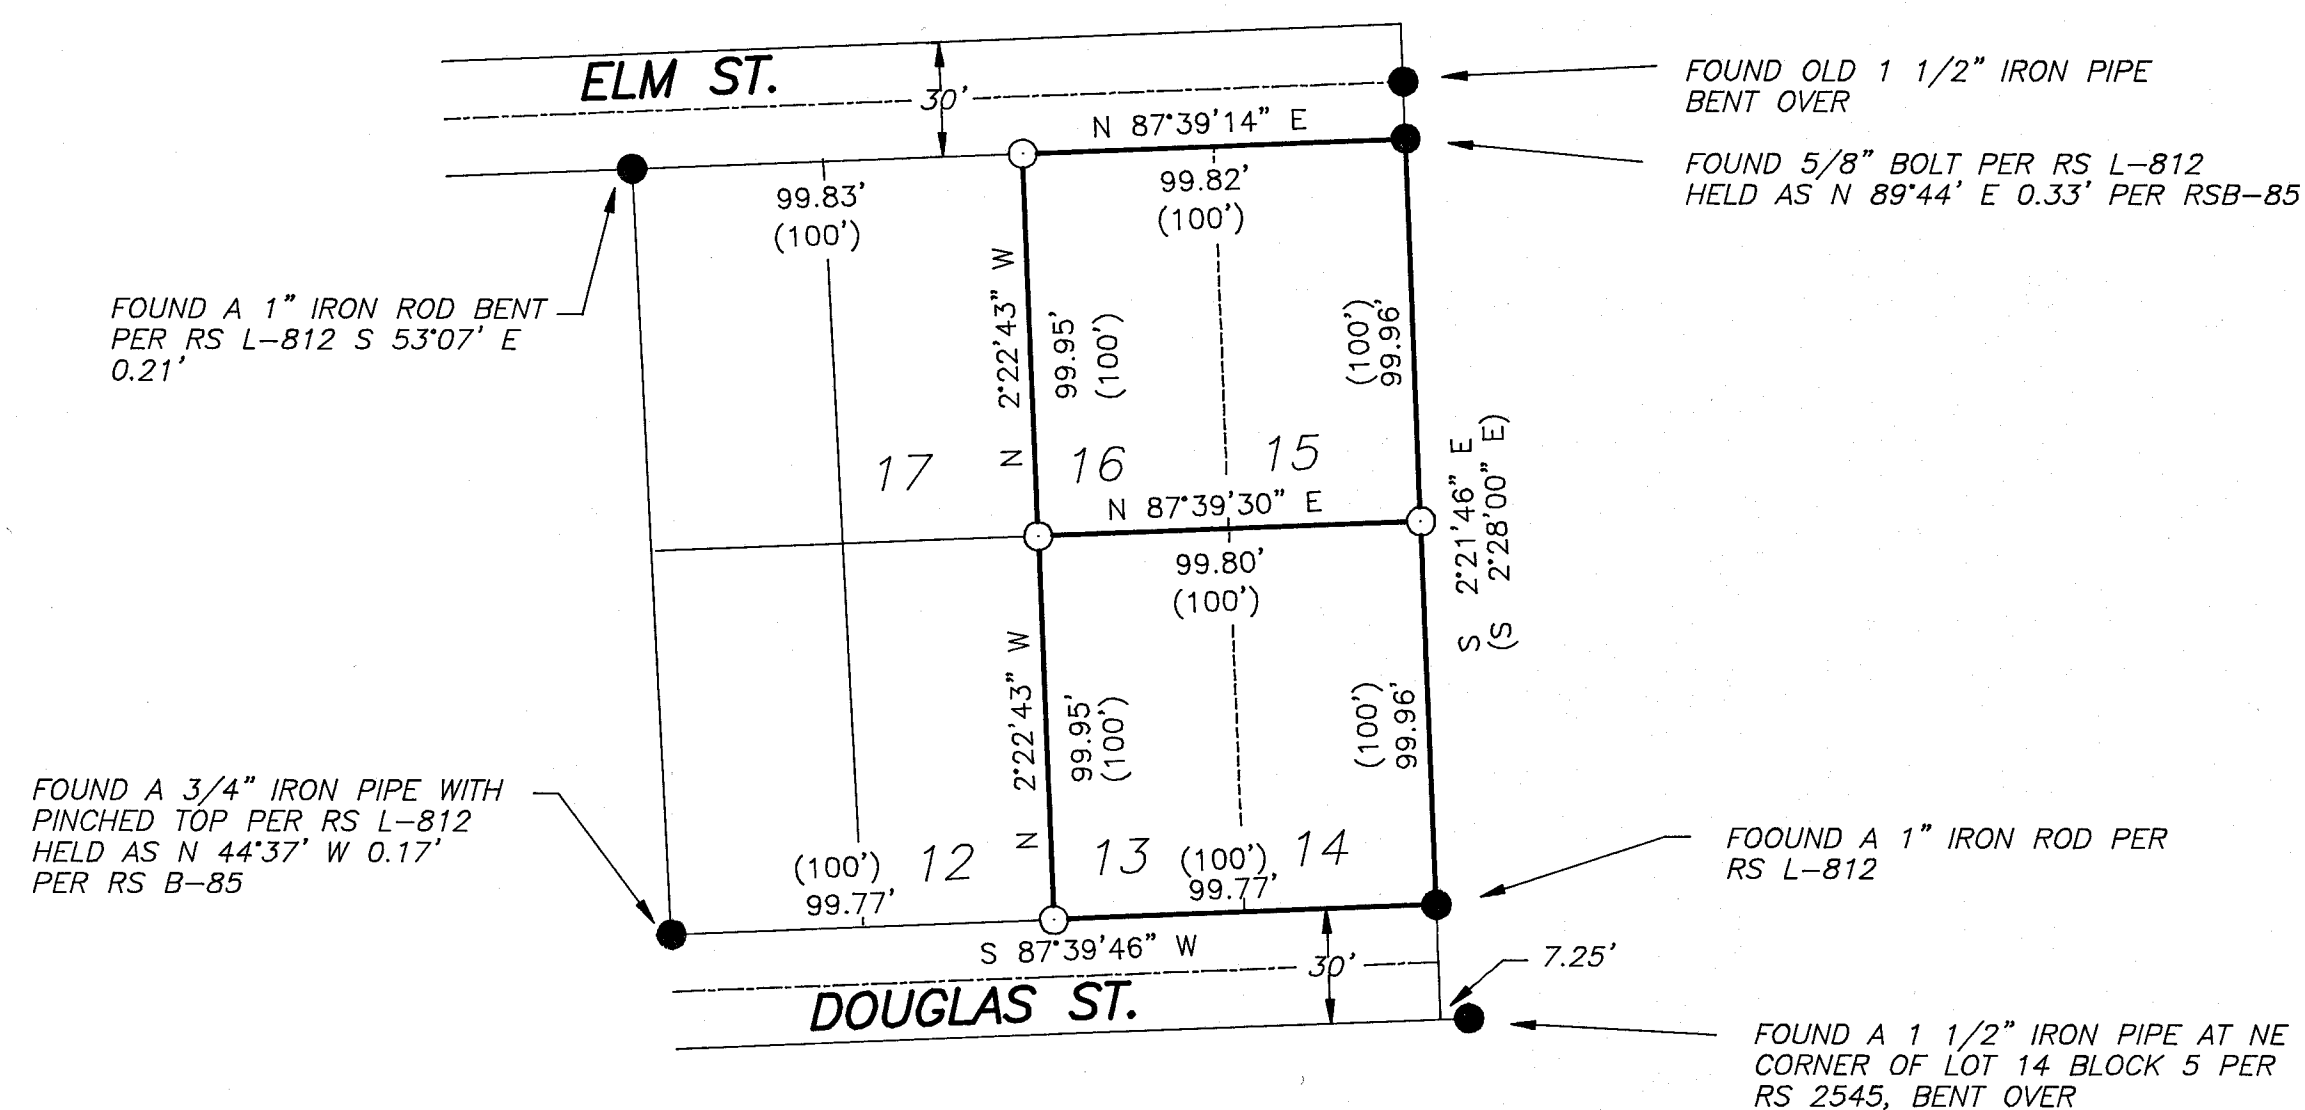

NARRATIVE
THIS SURVEY WAS ACCOMPLISHED AT THE REQUEST OF
ED MUELLER TO MONUMENT LOTS 13-16, BLOCK 6, FIRST
ADDITION TO RIVERVIEW LOTS.
FOR CONTROL I HELD THE LOCATION OF THE MONUMENTS
FOUND AS PER RS B-85.
BEARINGS ARE BASED ON RS B-85.

LEGEND

● = MONUMENT FOUND AS NOTED

○ = SET A 5/8" X 30" IRON ROD WITH A YELLOW PLASTIC CAP MARKED "KEENON LAND SERVICES INC."

() = RECORD DATA, PLAT OF RIVERVIEW LOTS


RS = RECORD SURVEY NO.

REGISTERED
PROFESSIONAL
LAND SURVEYOR

Leslie G. Keenon

OREGON
JULY 30, 1976
LESLIE G. KEENON
1080

RENEWAL DATE 6/30/95

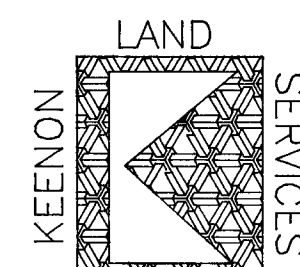

1224 ALDER ST.
VERNONIA, OR
97064
(503) 429-6115

COLUMBIA COUNTY SURVEYORS OFFICE
RECEIVED 10-6-94
ACCEPTED FOR FILING 11-3-94