

**NARRATIVE:**


--THE PURPOSE OF THIS SURVEY IS TO REESTABLISH THE MISSING MONUMENT AT THE NORTHWEST CORNER PARCEL 2 AS NOTED ON CS NO. L-1742, COLUMBIA COUNTY SURVEY RECORDS AT THE REQUEST OF STEVE MEAD. THE LINE SHOWN IN BOLD WAS MARKED WITH LATH AND RED AND WHITE RIBBON.

-- THE BASIS OF BEARING IS COMPUTED FROM CS NO. L 1742 BETWEEN MONUMENT NUMBER 3 & 15.

--FOR CONTROL I HELD THE MONUMENTS IN THE MONUMENT NOTES AND ESTABLISHED THE NORTHWEST CORNER OF PARCEL 2 AS SHOWN ON CS NO. L-1742 BY HOLDING THE RECORD DISTANCES PER CS NO. L-1742 FROM MONUMENT NUMBERS 3 AND 6 AS SHOWN.

**MONUMENT NOTES:**

- 3 FOUND A 1/2" IRON PIPE PER CS NO. L-1742 (HELD)
- 4 FOUND A 1/2" IRON PIPE PER CS NO. L-1742 TOP IS BENT TIED SPIN POINT (HELD)
- 6 FOUND A 3/4" IRON ROD AS SHOWN ON CS NO. L-1742, (HELD)
- 13 FOUND A 1 1/2" IRON PIPE PER CS NO. L-1487.
- 15 FOUND A 3/4" SQUARE IRON BAR, PER CS NO. 3250 (HELD)
- 27 SOUTHEAST CORNER OF PARCEL 3 PARTITION PLAT NO. 2006-009
- FOUND A 5/8" IRON ROD WITH A Y.P.C. MARKED "RUSSELL PLS 707" PER CS NO L-1668.

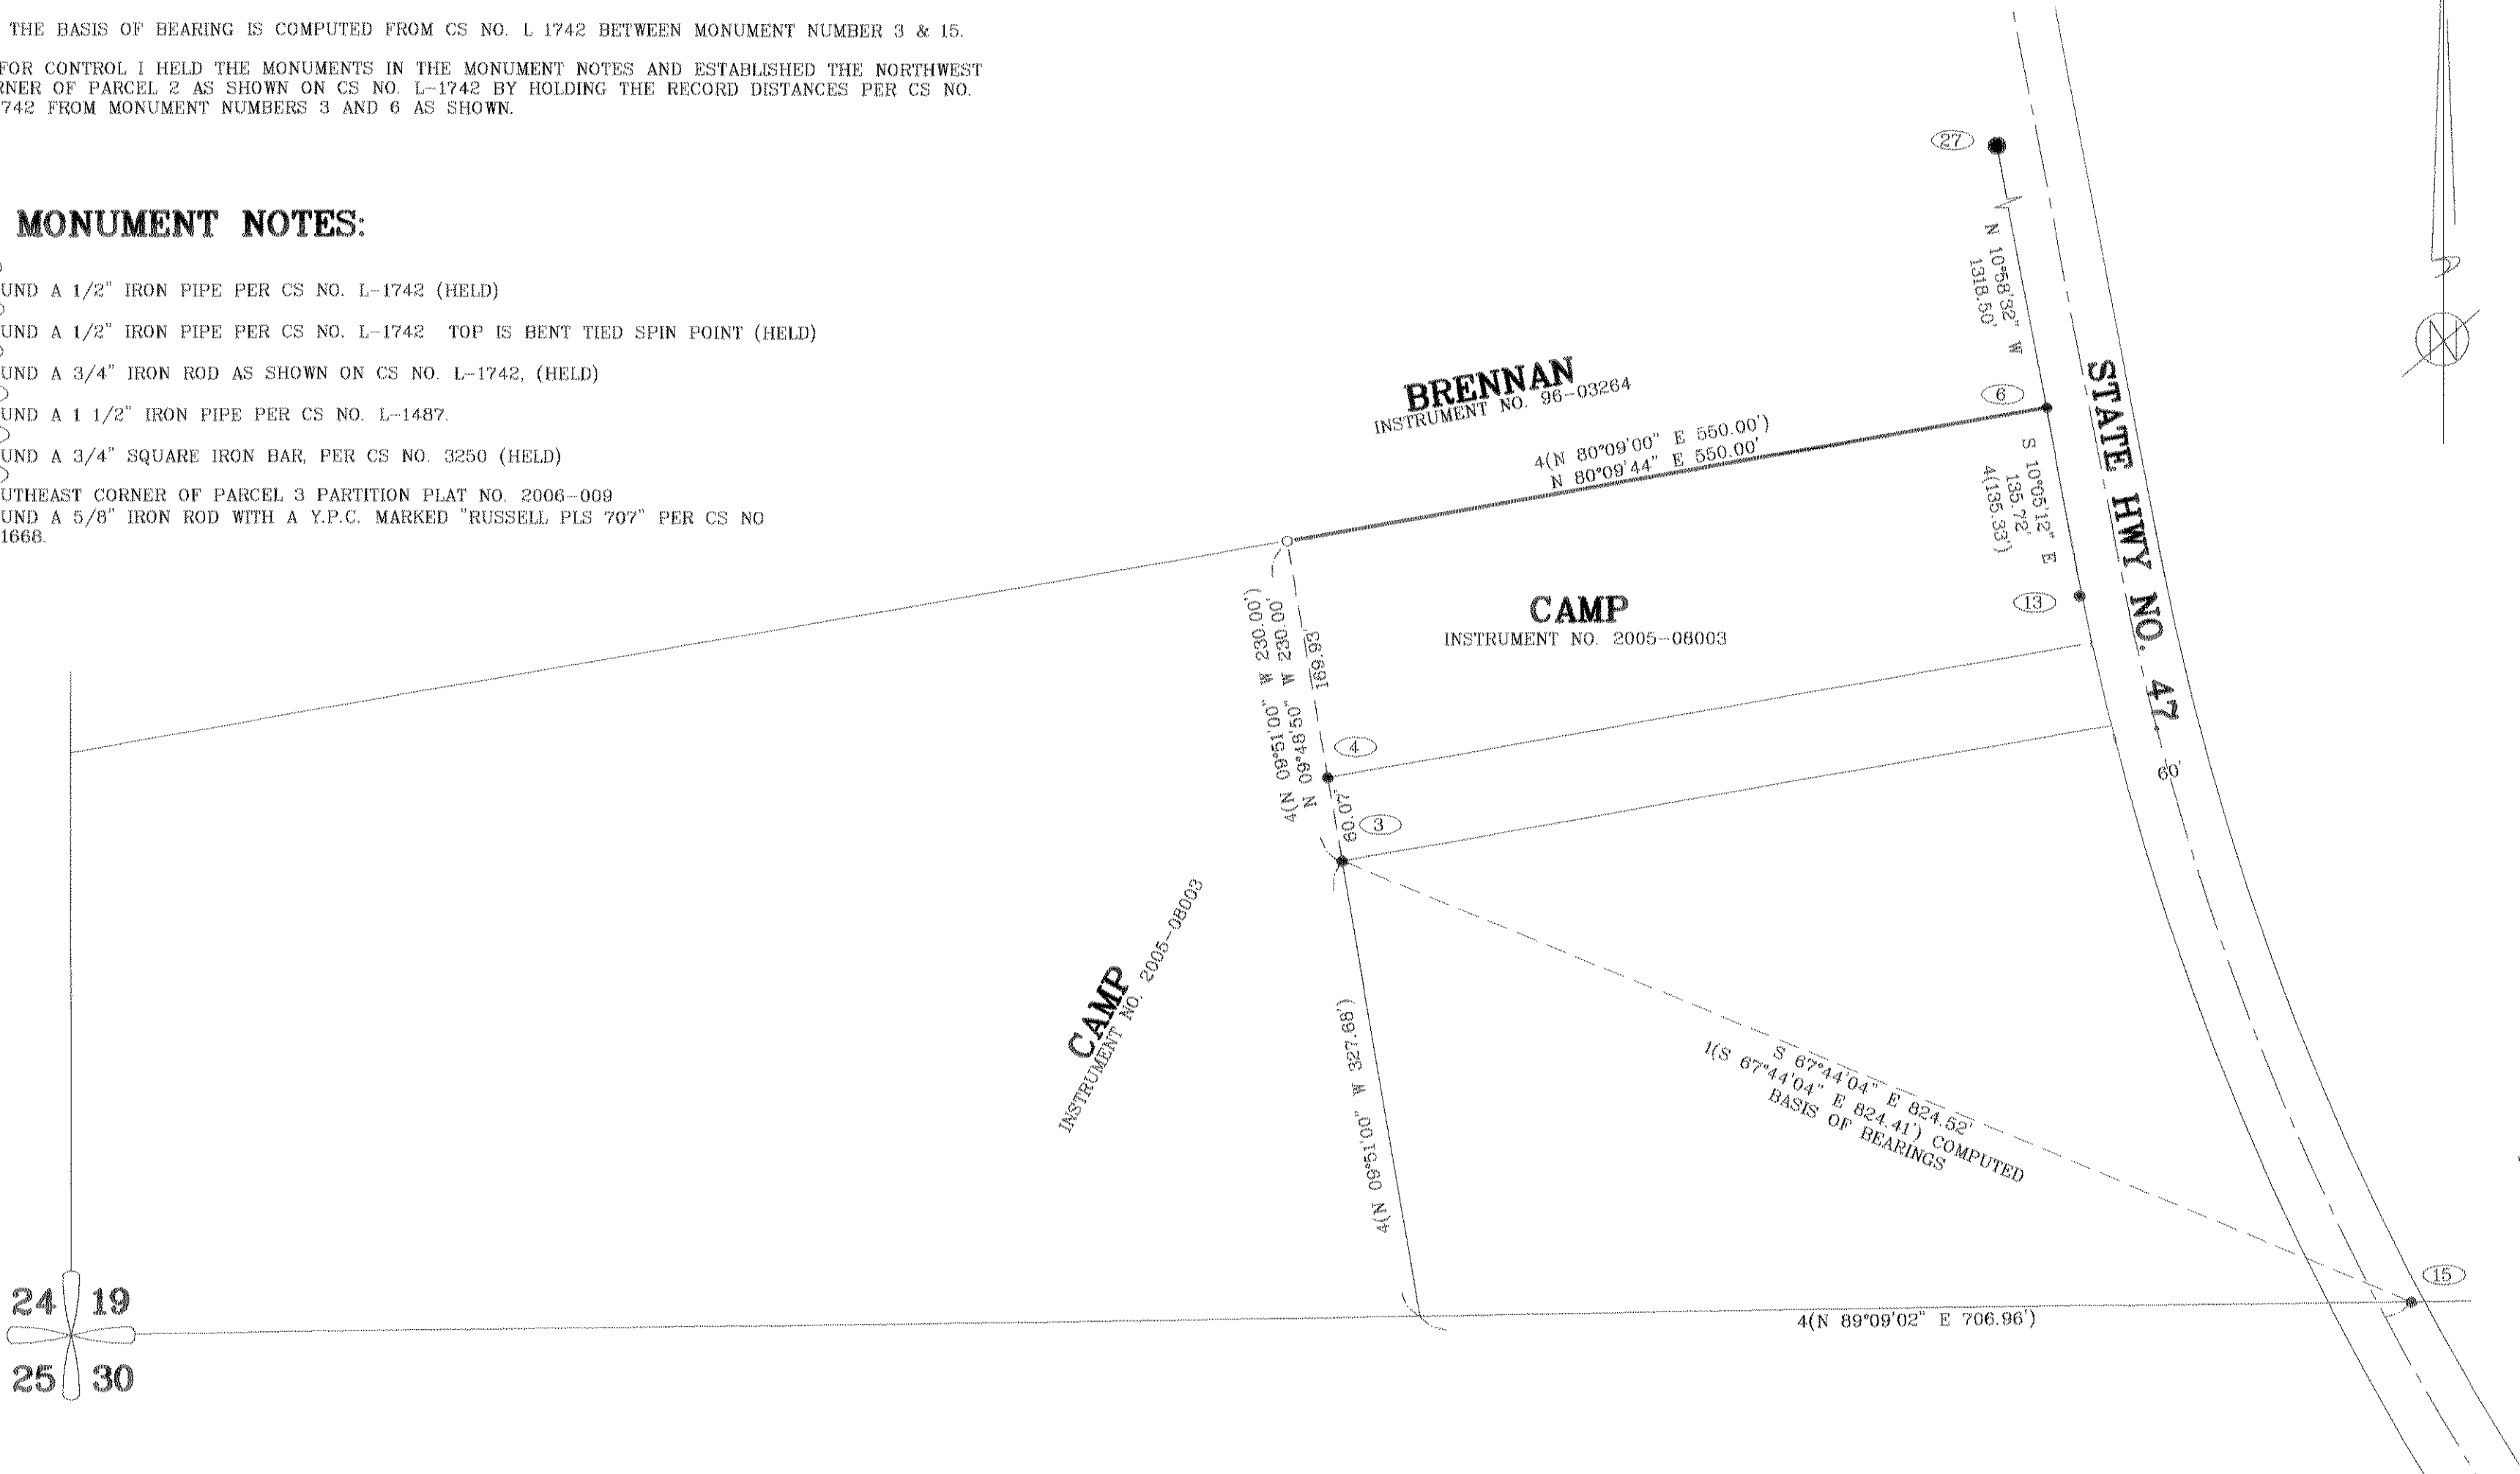

Columbia County Surveyor  
 Received 1/12/07  
 Paid 1/31/07  
 Case 5398

**LEGEND**

- = MONUMENT FOUND AS NOTED
- = SET A 5/8" X 30" IRON ROD WITH A Y.P.C. MARKED "KLS SURVEYING INC."
- ( ) = RECORD SURVEY DATA
- CS NO. = RECORD SURVEY NO.
- Y.P.C. = YELLOW PLASTIC CAP
- = MONUMENT POINT NO. (SEE MONUMENT NOTES)

**REFERENCE SURVEYS**

- 1 = CS NO. 3250
- 2 = CS NO. L-1487
- 3 = CS NO. L-1668
- 4 = CS NO. L-1742
- 5 = PARTITION PLAT 2006-009

REGISTERED PROFESSIONAL LAND SURVEYOR  <i>Donald D. Wallace Jr.</i> OREGON JANUARY 19, 1993 DONALD D. WALLACE JR. 2601 RENEWAL DATE 6/30/08 DRAWN BY: SND	K.L.S. SURVEYING INC.  1224 ALDER ST. VERNONIA, OR 97064 (503) 429-6115 FIELD: GAM/TB	SURVEY FOR  <b>STEVE MEAD</b> <b>IN THE SW 1/4 OF SECTION 19,</b> <b>T4N, R4W, W.M.</b> <b>COLUMBIA COUNTY, OREGON</b> <b>SCALE 1" = 100' JANUARY 10, 2007</b> EQUIPMENT: GTS300/TDS48 JOB No. 07-006 PROJECT No. 07-006	THIS SURVEY WAS PREPARED USING HEWLETT-PACKARD PRODUCT # 4844A ON CONTINENTAL IMAGING # JPC-4M2 POLYESTER FILM.  COLUMBIA COUNTY SURVEYORS OFFICE RECEIVED _____ ACCEPTED _____ REVISED: 1/15/2007 1/27/07
---	--	---	--