



# RECORD OF SURVEY for STIMSON LUMBER CO. and HANSON NATURAL RESOURCES CO. IN SECTION 29, T.4 N., R. 4 W., W.M. COLUMBIA COUNTY, OREGON FEB. 10, 1992 SCALE 1"=400'

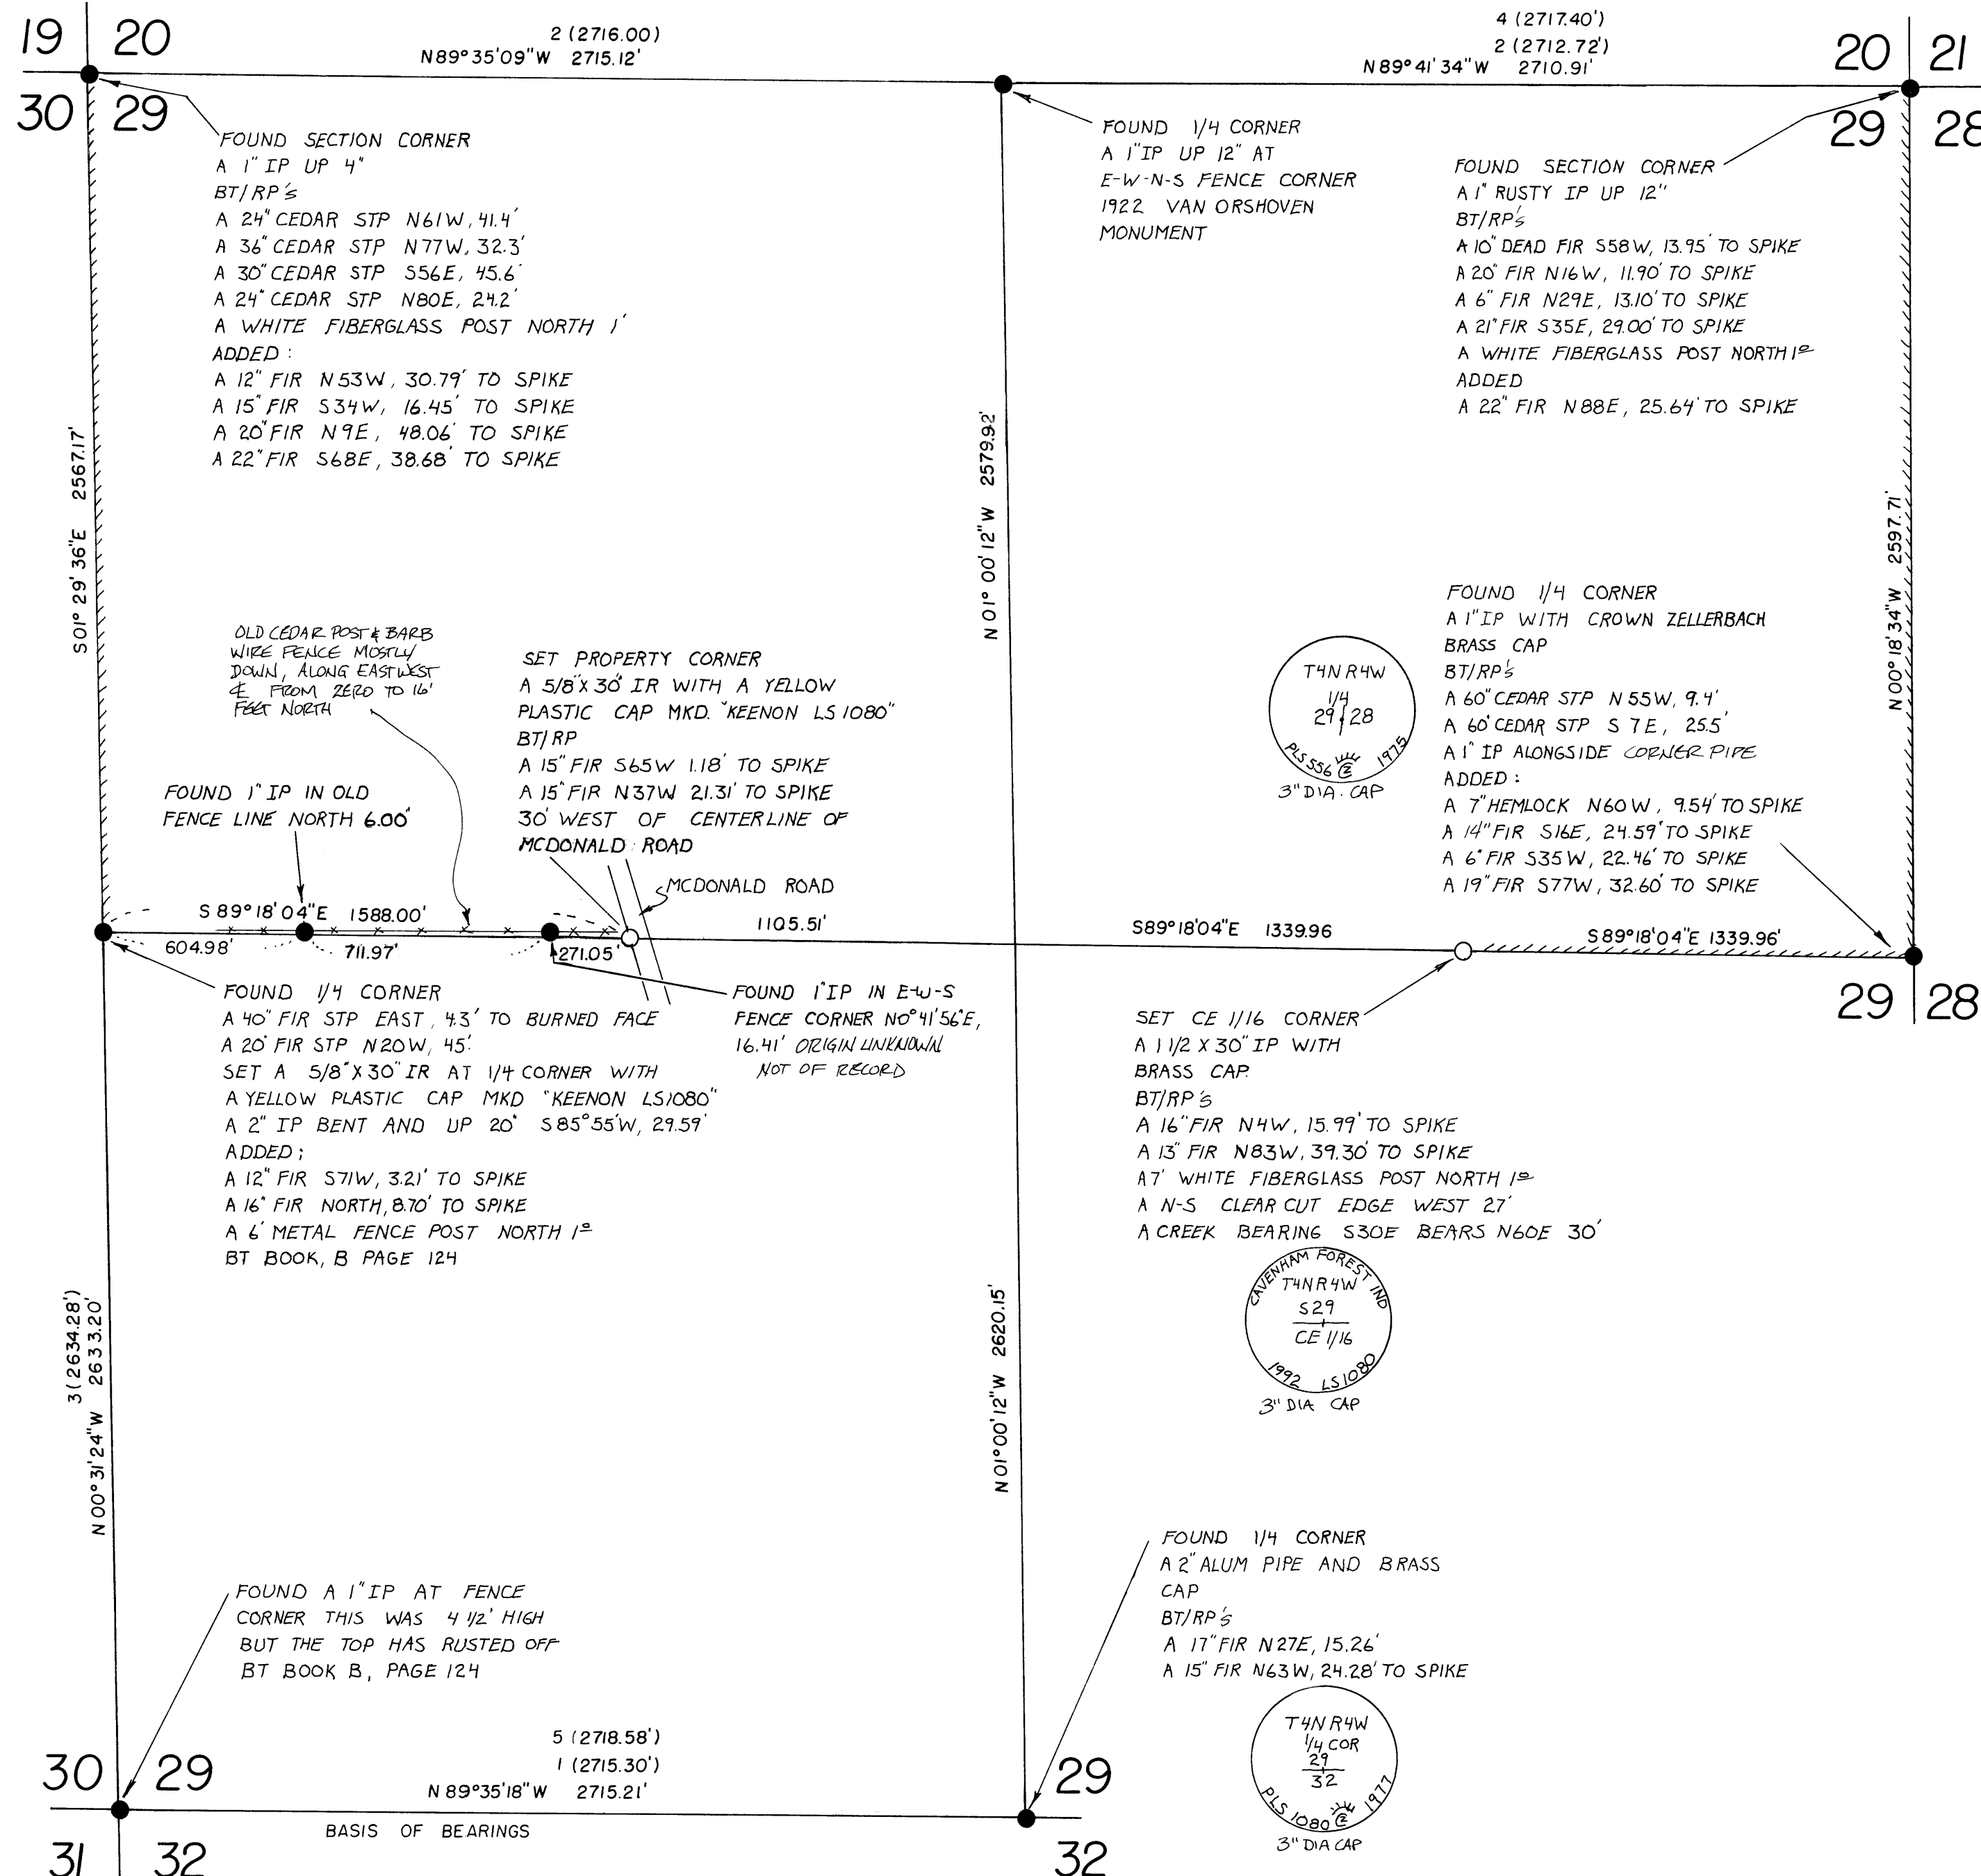

NARRATIVE: THIS SURVEY WAS DONE AT THE REQUEST OF STIMSON LUMBER CO. AND HANSON NATURAL RESOURCES CO. TO MARK AND MONUMENT THE BOUNDARIES AS SHOWN. THE LINES SHOWN WITH HASH MARKS WERE MARKED WITH RED AND WHITE RIBBON, AND PAINTED BLAZES. ALL NEW BT/RP'S ARE MARKED WITH 4 BLAZES UP THE FACE A SPIKE IN THE BASE AND LOCATION TAGS ABOVE BLAZES. THE BASIS OF BEARINGS IS THE SOUTH LINE OF THE SW 1/4 FROM RS #3606 (N 89° 35' 18\" W)

LEGEND  
● - MONUMENT FOUND AS NOTED  
○ - MONUMENT SET AS NOTED  
( ) - RECORD DATA  
1=RS#3606  
2=RS#3563  
3=RS#L-1877  
4=RS#2666  
5=RS#2759  
RS - RECORD SURVEY  
BT/RP - BEARING TREE / REFERENCE POINT

L. JERRY KEENON  
1311 ALDER ST  
VERNONIA, OREGON 97064  
PH. 429-6115

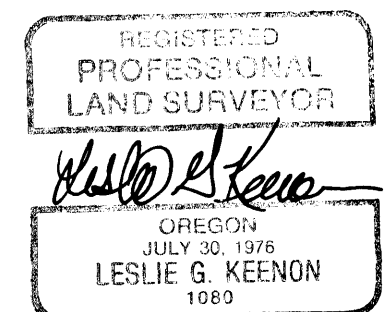

COUNTY SURVEYOR  
RECEIVED 3-19-92  
FILED 3-24-92

DRAWN BY: DON WALLACE