


SURVEY of LOTS 3, 4, 9, & 10
in BLOCK 6 of COREY ADDITION to
Vernonia, Oregon
in the SW 1/4 of NE 1/4 Sec. 5
T4N, R4W, W.B. & M

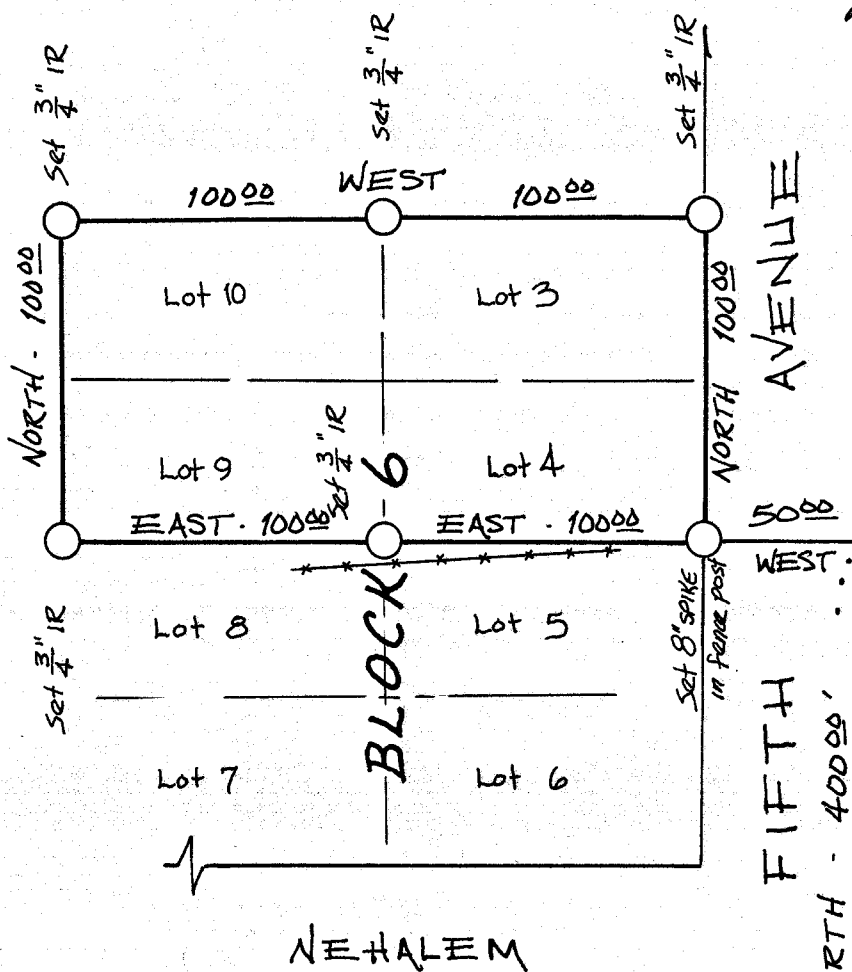

NOTE: SURVEY BASED ON CS# L-1192 &
the PLAT OF COREY ADDITION; JAN. 1923.

REGISTERED
PROFESSIONAL
LAND SURVEYOR

Leslie G. Keenon

OREGON
JULY 30, 1976
LESLIE G. KEENON
P.L.S. 1080

COLUMBIA COUNTY SURVEYOR

DATE RECEIVED 9-27-78

DATE FILED 9-27-78

BY *[Signature]*

EAST - 10000'

fd. as per
record survey
L-1192

L-1217