


L-1928

BOUNDARY SURVEY  
for  
KEN SMEJKAL in  
SE 1/4 NE 1/4, Sec 8,  
T4N, R4W, W.M.  
COLUMBIA, COUNTY, ORE.  
MAY 25, 1987 SCALE 1" = 200'

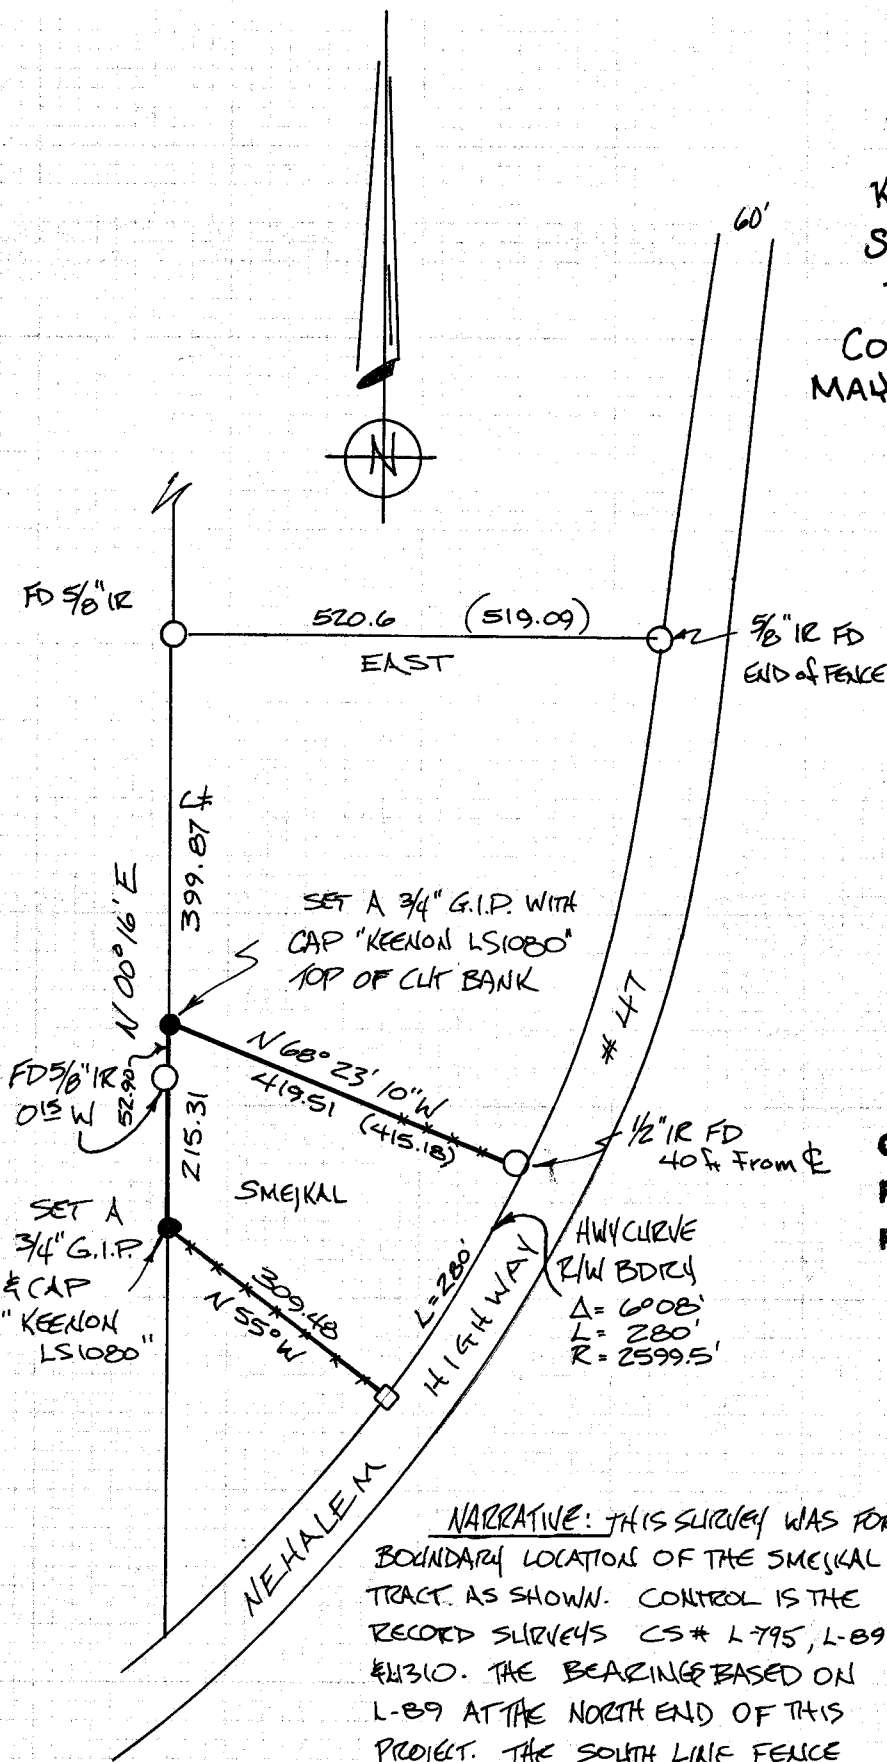

NARRATIVE: THIS SURVEY WAS FOR  
BOUNDARY LOCATION OF THE SMEJKAL  
TRACT AS SHOWN. CONTROL IS THE  
RECORD SURVEYS CS# L-795, L-89  
& L-310. THE BEARING IS BASED ON  
L-89 AT THE NORTH END OF THIS  
PROJECT. THE SOUTH LINE FENCE  
TENDS TO WANDER SLIGHTLY.

COUNTY SURVEYOR  
RECEIVED 6-9-87

FILED 6-26-87 GLO.  
CS# L-1928

FIELD WORK:

H.W. (BLD) WEIGAND  
&  
L. JERRY KEENON  
1311 ALDER  
VERNON, ORE  
97064

REGISTERED  
PROFESSIONAL  
LAND SURVEYOR

*Leslie G. Keenon*

OREGON  
JULY 30, 1976  
LESLIE G. KEENON  
P.L.S. 1080

L-1928