


SCALE 1" = 100'      APRIL 22, 1994

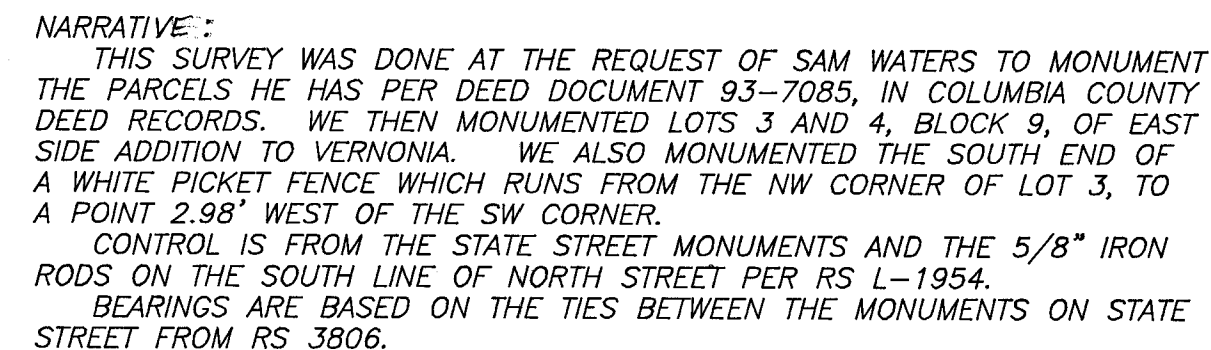


LEGEND

- = MONUMENT FOUND AS NOTED
- = SET A 5/8" X 30" IRON ROD WITH A YELLOW PLASTIC CAP MARKED "KEENON LS 1080"
- ( ) = RECORD DATA, PLAT OF EASTSIDE ADDITION
- RS = RECORD SURVEY NO.

- 1 5/8" IRON ROD  
WITH CAP PER  
RS L-1631  
N 0.22'
- 2 5/8" IRON ROD  
WITH CAP PER  
RS L-1631  
N 0.12'
- 3 5/8" IRON ROD  
ORIGIN UNKNOWN
- 4 1/2" IRON PIPE  
PER RS L-1332
- 5 5/8" IRON ROD  
WITH CAP PER  
RS L-1954
- 6 5/8" IRON ROD  
WITH CAP PER  
RS L-1954

LINE	BEARING		DISTANCE
1	N	89°58'07"	E 100.00'
2	N	0°03'19"	E 100.00'
3	N	0°03'19"	E 100.00'
4	N	01°45'44"	E 100.05'
5	N	0°03'19"	E 115.00'
6	S	89°57'23"	W 100.00'
7	S	0°19'01"	W 29.00'
8	N	89°57'23"	E 50.00'
9	S	0°19'01"	W 100.00'
10	S	89°58'07"	W 50.00'
11	S	89°58'07"	W 52.98'
12	N	89°58'07"	E 50.00'
13	N	89°58'07"	E 50.00'
14	S	89°57'23"	W 50.00'
15	S	89°57'23"	E 50.02'
16	S	0°34'34"	E 15.28'
17	N	89°57'23"	W 50.03'

DETAIL  
1" = 50'

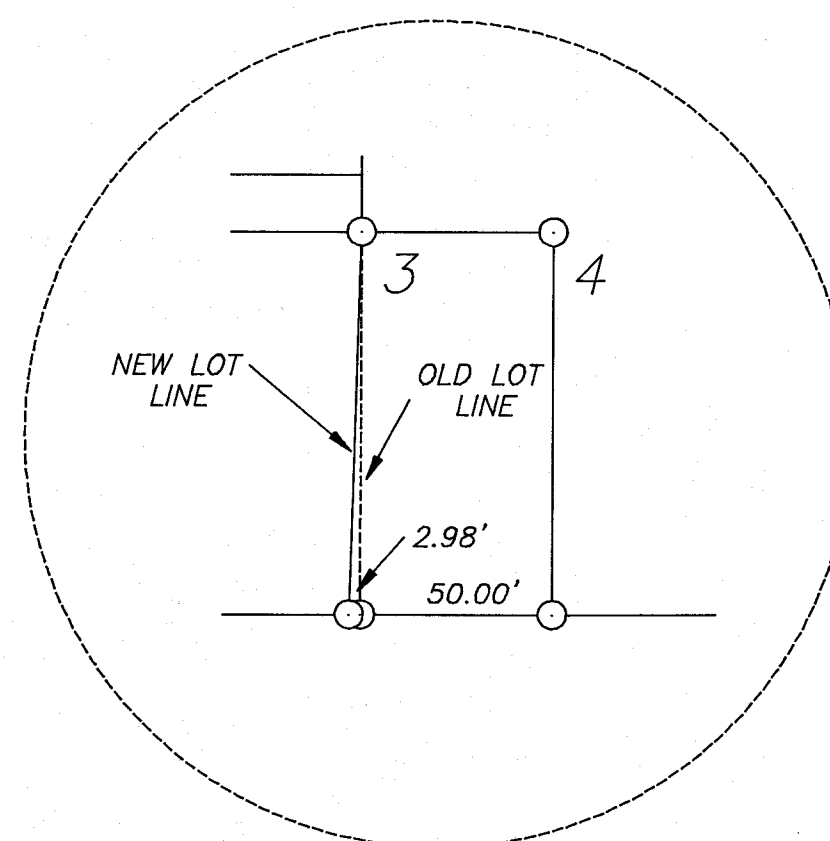

REGISTERED  
PROFESSIONAL  
LAND SURVEYOR

*Leslie G. Keenon*

OREGON  
JULY 30, 1976  
LESLIE G. KEENON  
1080

RENEWAL DATE 6/30/95

1224 ALDER ST.  
VERNONIA, OR  
97064  
(503) 429-6115

COLUMBIA COUNTY SURVEYORS OFFICE  
RECIEVED 5-20-94  
ACCEPTED FOR FILING 11-3-94