


RECORD OF SURVEY
FOR DICK TITUS
IN THE SE 1/4 OF SEC, 14, T4N, R5W, W.M.
COLUMBIA COUNTY, OREGON
SCALE 1" = 100' JUNE 2, 1994

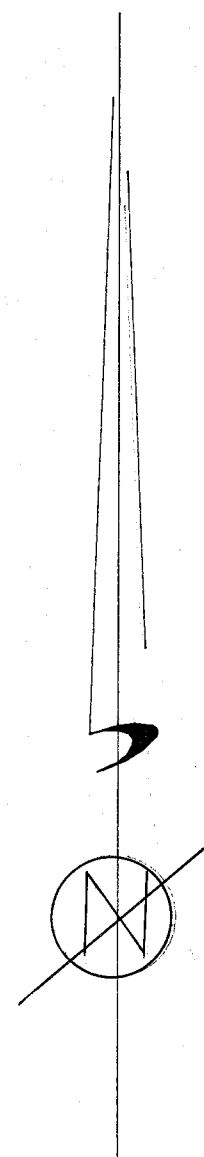


1/4 CORNER
A 1/2" IRON PIPE WITH A 3/4"
GUARD PIPE 18" HIGH ALONGSIDE
BT/RP
A 26" FIR N61W 4.01' TO SPIKE
A 19" FIR S10W 21.12' TO SPIKE
A 27" FIR N33E 17.40' TO HEALED FACE
A 28" FIR S67W 16.9' TO HEALED FACE

SET A 5/8" X 30" IRON ROD WITH A
YELLOW PLASTIC CAP MARKED
"KEENON LAND SERVICES" ON THE
SOUTH LINE OF NEHALEM HIGHWAY
AS DETERMINED FROM THE TRAVELED
CENTERLINE

1/16 CORNER
A 3/4" IRON PIPE DOWN 24" AND 75'
NORTH OF THE CENTER OF THE NEHALEM
RIVER, SET IN AN UNRECORDED SURVEY
BY LONGVIEW FIBRE COMPANY IN 1956.

SECTION CORNER
A 2" IRON PIPE UP 18" PER
LONGVIEW FIBRE BT BOOK
PAGE 51

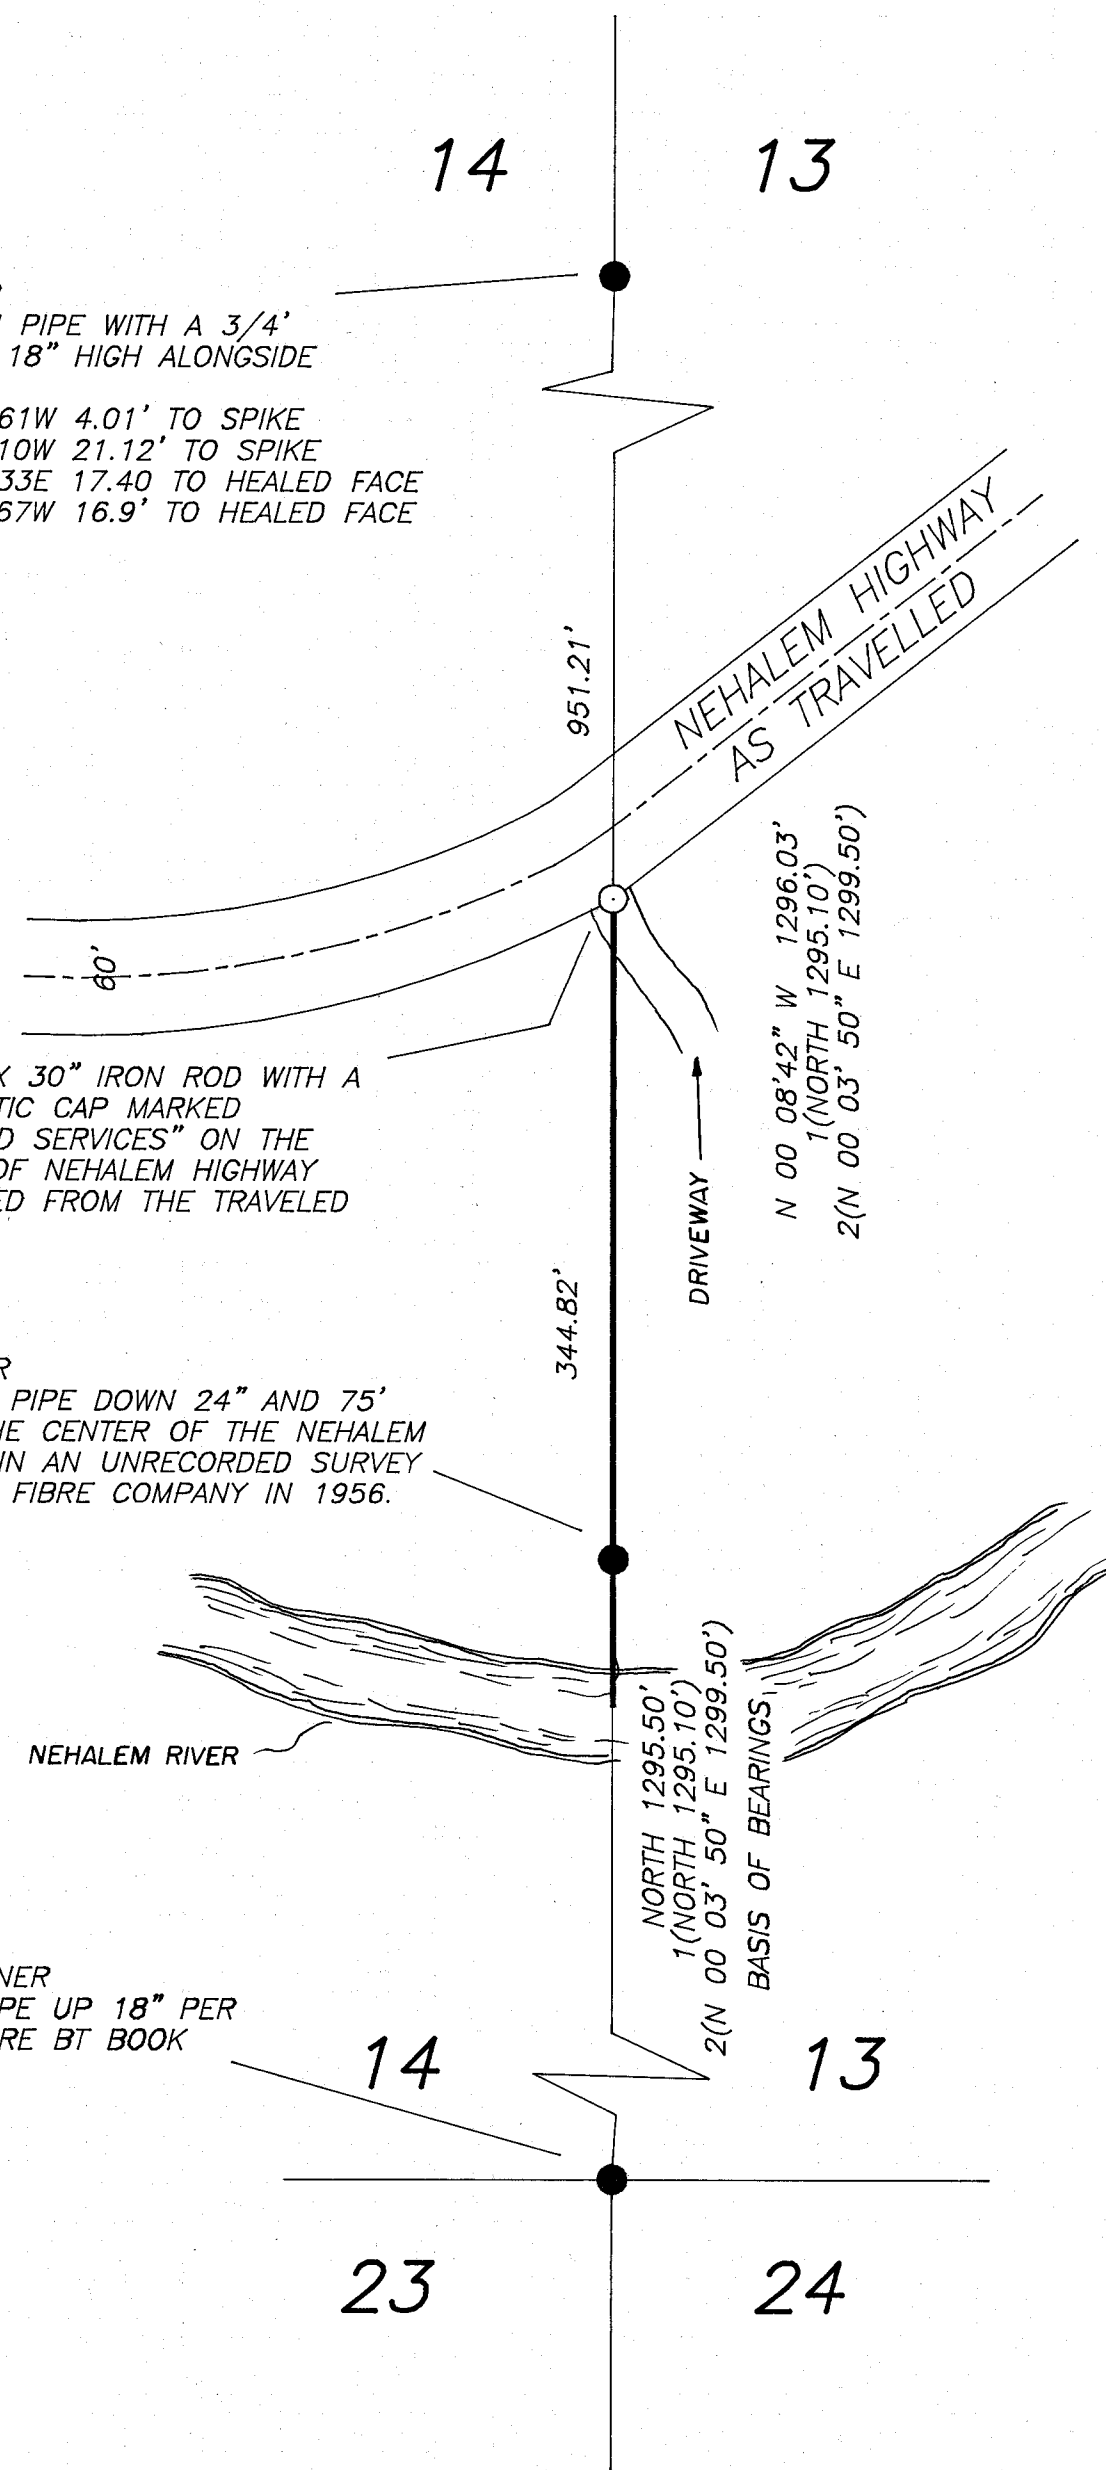

NARRATIVE:


THIS SURVEY WAS DONE AT THE REQUEST OF DICK
TITUS TO MARK AND MONUMENT THE LINE AS SHOWN.
THE BASIS OF BEARINGS IS THE EAST LINE OF THE
SE 1/4 OF THE SE 1/4 OF SECTION 14 FROM RS 1025.
I HELD THE FOUND MONUMENTS AS SHOWN AND
SET A MONUMENT ON THE SOUTH LINE OF NEHALEM
HIGHWAY 30' FROM THE TRAVELED CENTERLINE.

LEGEND

- = MONUMENT FOUND AS NOTED
- = SET A 5/8" X 30" IRON ROD WITH A YELLOW PLASTIC
CAP MARKED "KEENON LAND SERVICES"
- () = RECORD DATA 1 = RS 1025
2 = UNRECORDED LONGVIEW FIBRE
CO. SURVEY.
- RS = RECORD SURVEY NO.

REGISTERED
PROFESSIONAL
LAND SURVEYOR

Donald D. Wallace, Jr.
OREGON
JANUARY 19, 1993
DONALD D. WALLACE, JR.
2601
RENEWAL DATE 12/31/95

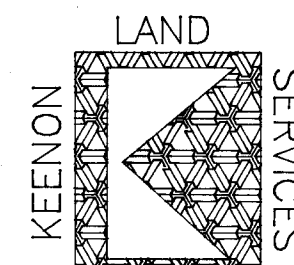

1224 ALDER ST.
VERNONIA, OR
97064
(503) 429-6115

COLUMBIA COUNTY SURVEYORS OFFICE
RECIEVED 6-29-94
ACCEPTED FOR FILING 8-17-94