


0887

1280

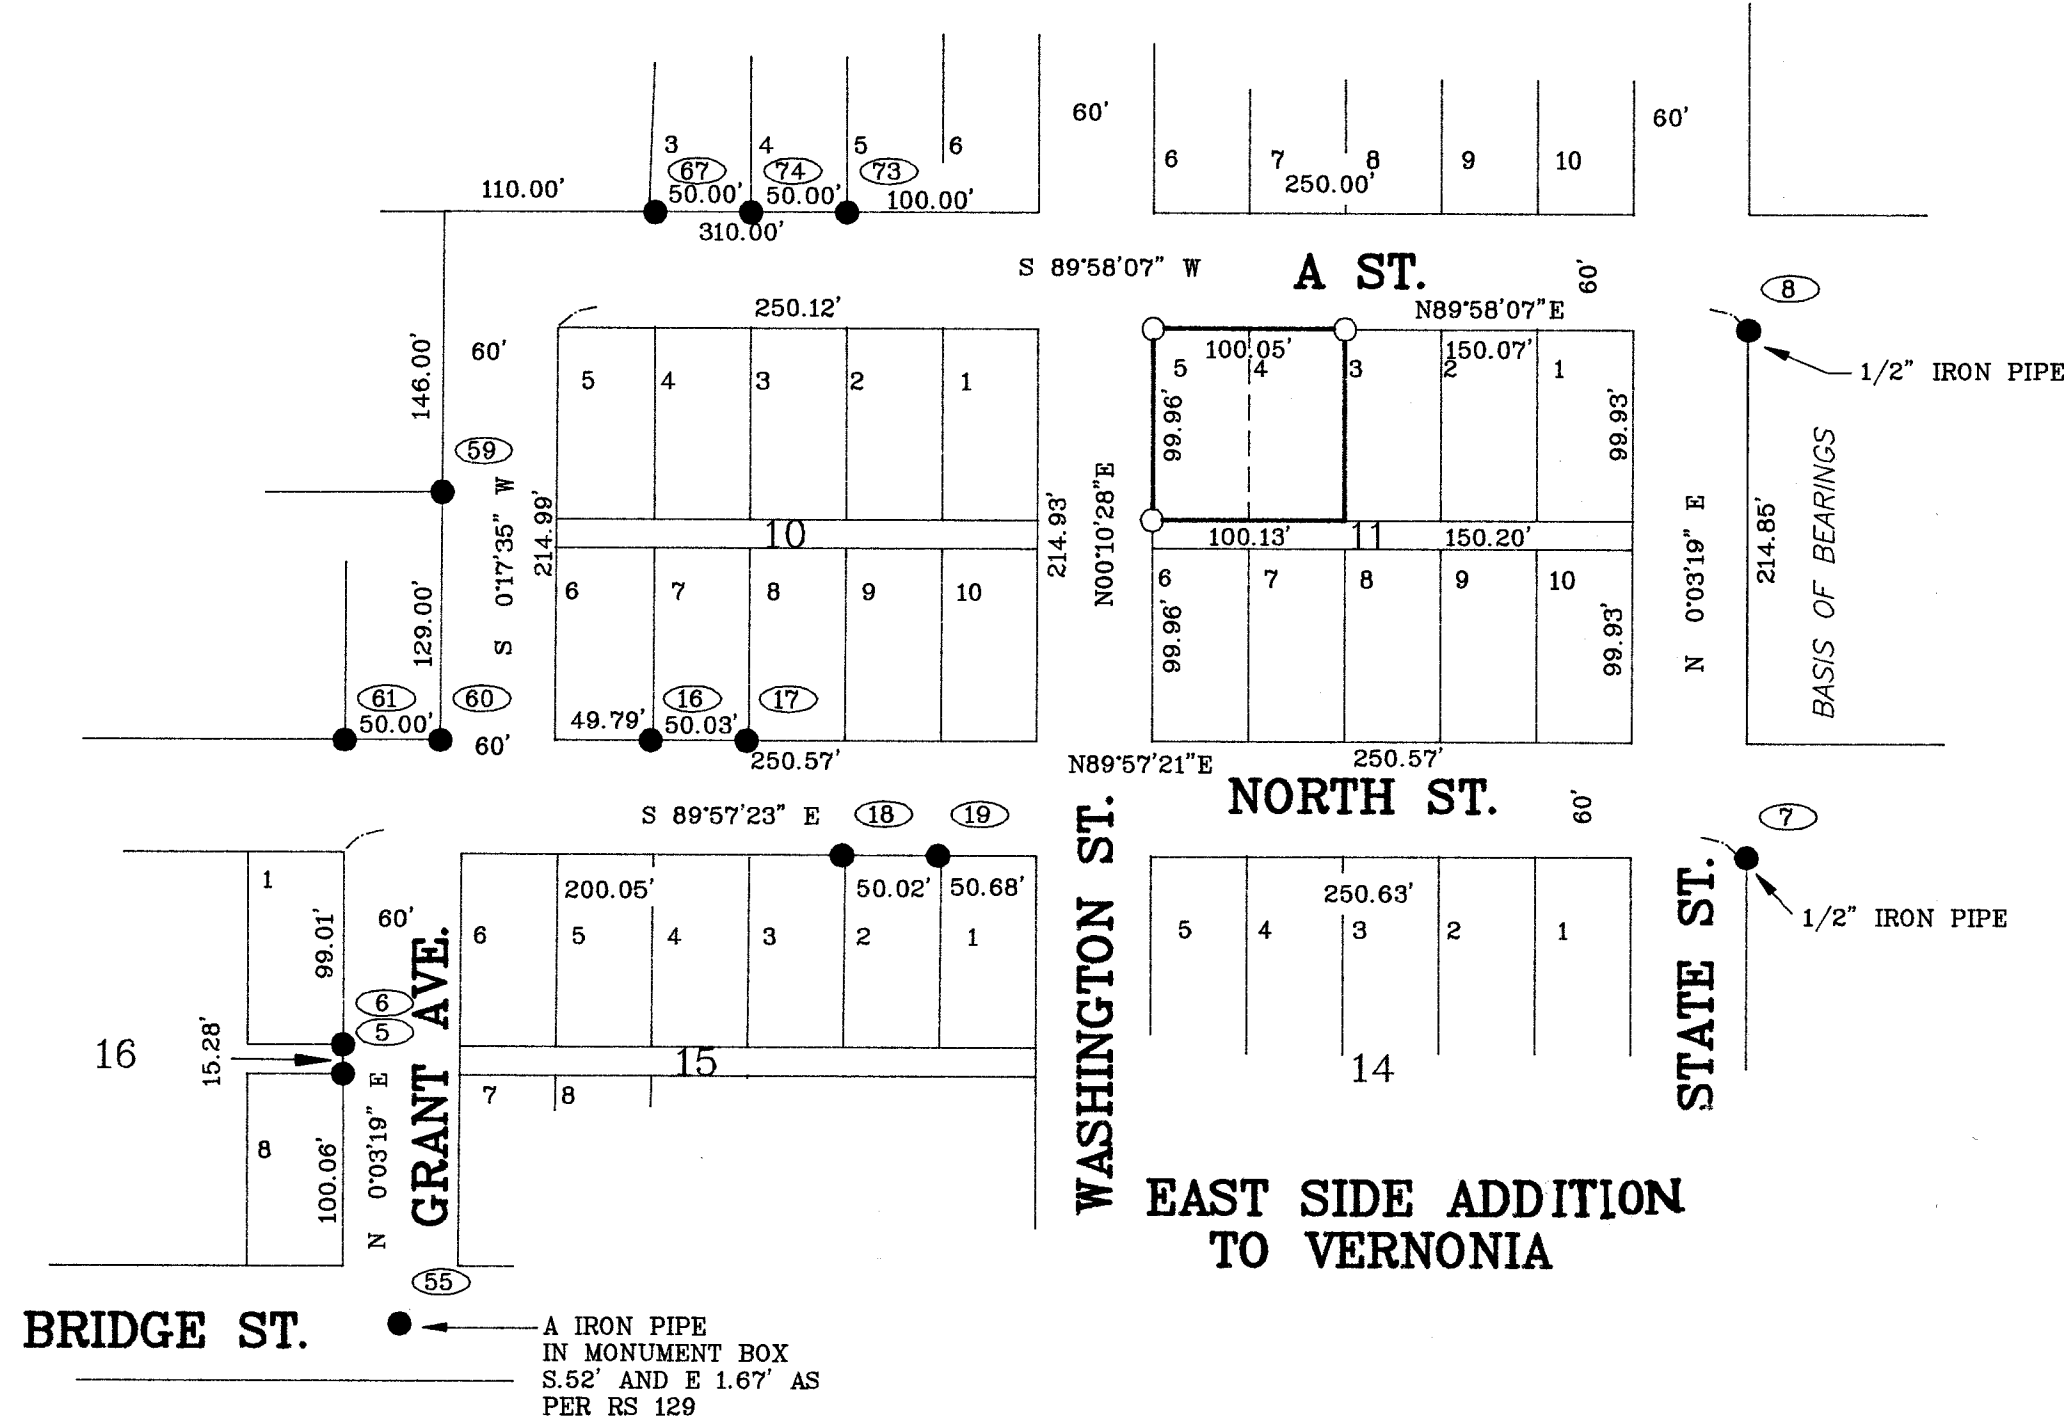

NARRATIVE:

--THIS SURVEY WAS ACCOMPLISHED AT THE REQUEST OF THE BAPTIST CHURCH TO MONUMENT LOTS 4 AND 5 OF BLOCK 11, EAST SIDE ADDITION TO VERNONIA.
--THE BEARINGS ARE BASED ON THE TIES BETWEEN THE MONUMENTS ON STATE STREET FROM CS No. 3806.
--FOR CONTROL 1 HELD CS No. 3988 AND THE MONUMENTS NOTED THEREIN


LEGEND

- = MONUMENT FOUND AS NOTED
- = SET A 5/8" x 30" IRON ROD WITH A Y.P.C. MARKED "KEENON LAND SERVICES INC."
- () = RECORD SURVEY DATA
- [] = RECORD DEED DATA
- CS No. = RECORD SURVEY No.
- Y.P.C. = YELLOW PLASTIC CAP
- = CONTROL POINT No.

MONUMENT NOTES

- ⑤ 1/2" IRON PIPE PER RS L-1332
- ⑥ 5/8" IRON ROD ORIGIN UNKNOWN
- ⑬ 5/8" IRON ROD WITH CAP PER RS L-1631 N 0.22'
- ⑰ 5/8" IRON ROD WITH CAP PER RS L-1631 N 0.12'
- ⑱ 5/8" IRON ROD WITH CAP PER RS L-1954
- ⑲ 5/8" IRON ROD WITH CAP PER RS L-1954
- ⑤⑨ 5/8" IRON ROD WITH A Y.P.C. MARKED "KEENON LAND SERVICES INC." PER CS No. 3988
- ⑥⑩ 5/8" IRON ROD WITH A Y.P.C. MARKED "KEENON LAND SERVICES INC." PER CS No. 3988
- ⑥⑪ 5/8" IRON ROD WITH A Y.P.C. MARKED "KEENON LAND SERVICES INC." PER CS No. 3988
- ⑥⑰ 5/8" IRON ROD WITH A Y.P.C. MARKED "KEENON LAND SERVICES INC." PER CS No. 3988
- ⑦③ 5/8" IRON ROD WITH A Y.P.C. MARKED "KEENON LAND SERVICES INC." PER CS No. 3988
- ⑦④ 5/8" IRON ROD WITH A Y.P.C. MARKED "KEENON LAND SERVICES INC." PER CS No. 3988

**DETAIL OF BLOCK 11
SCALE 1" = 50'**

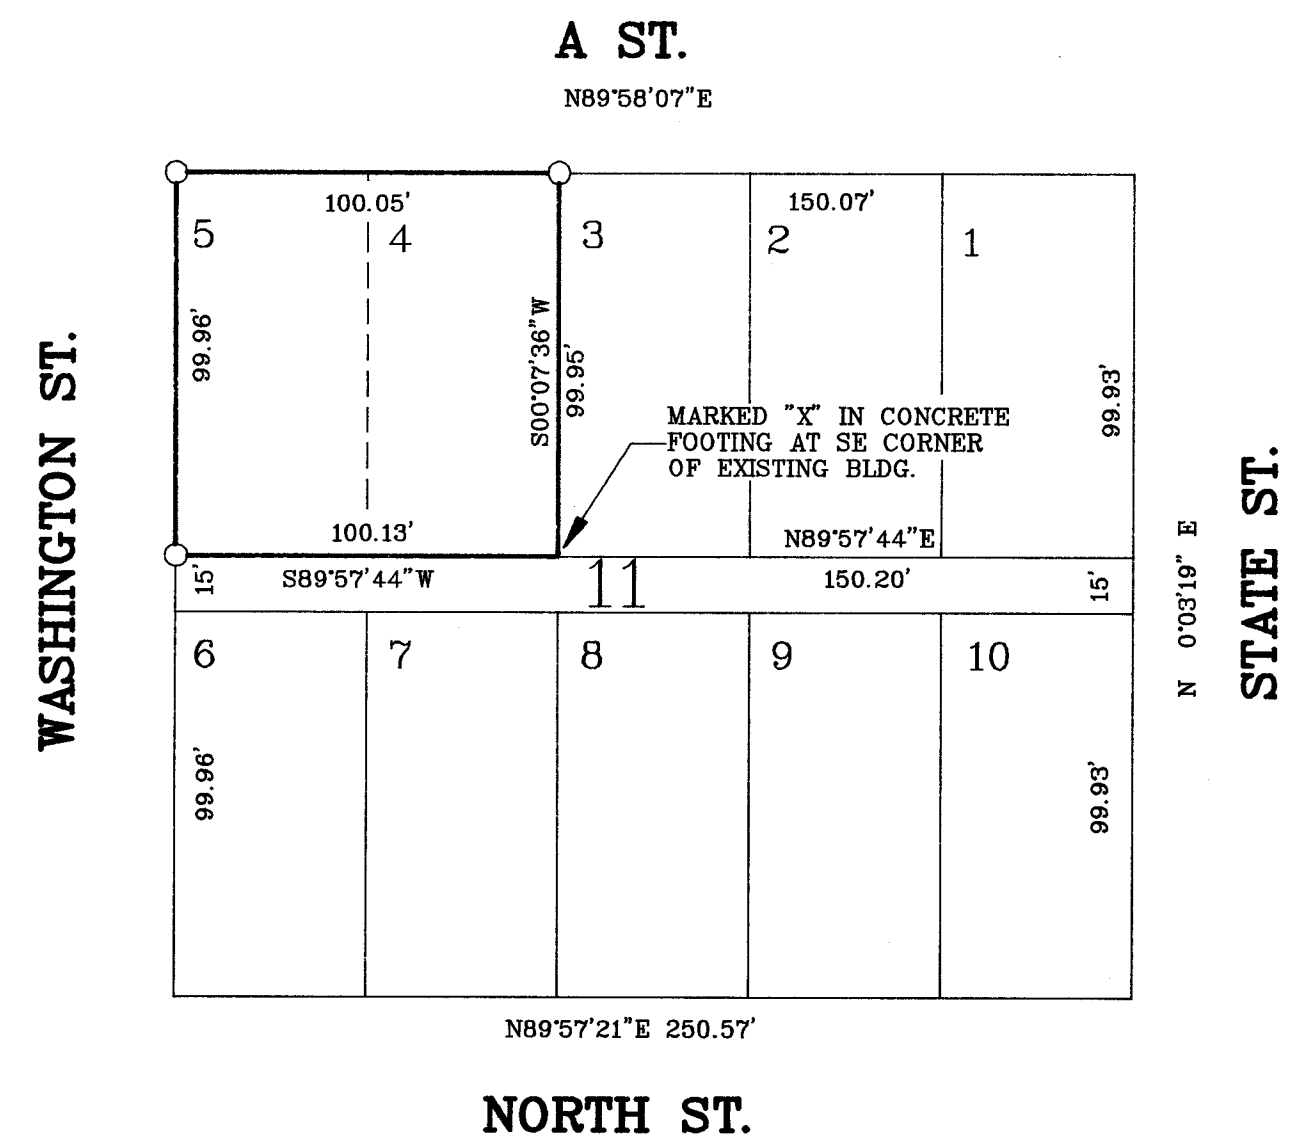

<p>REGISTERED PROFESSIONAL LAND SURVEYOR</p> <p><i>Leslie G. Keenon</i></p> <p>OREGON JULY 30, 1976 LESLIE G. KEENON 1080 RENEWAL DATE 6/30/97</p>	<p>KEENON LAND SERVICES</p> <p>1224 ALDER ST. VERNONIA, OR 97064 (503) 429-6115</p>	<p>SURVEY FOR BAPTIST CHURCH IN EAST SIDE ADDITION TO VERNONIA AND IN THE NW 1/4 OF SECTION 4, T4N, R4W, W.M. COLUMBIA COUNTY, OREGON SCALE 1" = 100 MARCH 4, 1997</p>		<p>COLUMBIA COUNTY SURVEYORS OFFICE RECEIVED <u>4-23-97</u> ACCEPTED <u>5-16-97</u> CHECK # <u>160</u></p>
		<p>DRAWN BY: DDW</p>	<p>EQUIPMENT: GTS300/TDS48</p>	<p>PROJECT No. 97-026</p>

0887

4280