


B-203

RECORD OF SURVEY FOR JOHN JUNGWORTH IN THE SE 1/4 OF SEC 12, T4N, R5W, W.M. COLUMBIA COUNTY, OREGON SCALE 1"=200' APRIL 21, 1993

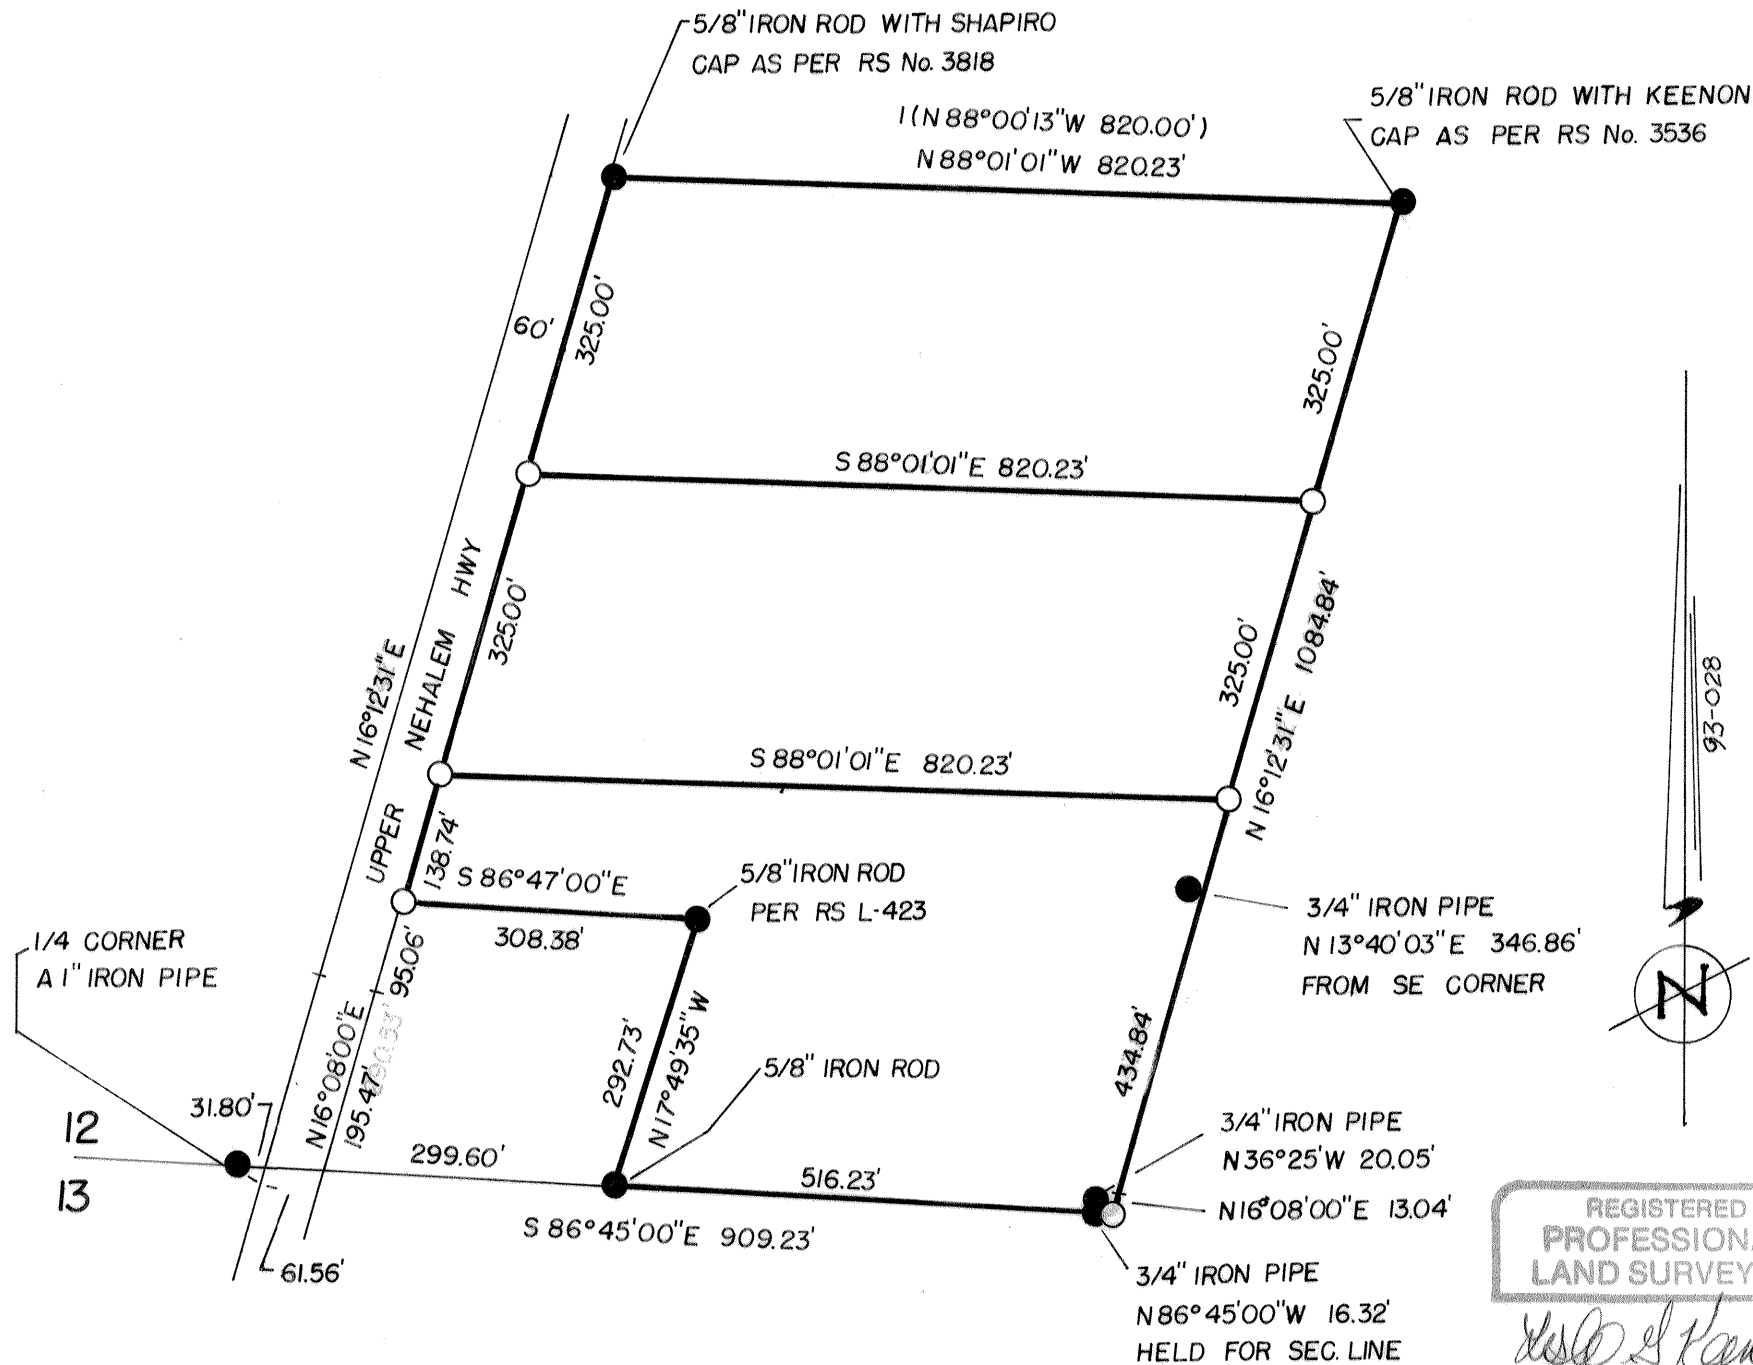

NARRATIVE: THIS SURVEY WAS ACCOMPLISHED AT THE REQUEST OF JOHN JUNGWORTH TO MARK AND MONUMENT THE PROPERTY AS DESCRIBED IN DEED BOOK 253 PAGES 648-650, COLUMBIA COUNTY RECORDS. THE BASIS OF BEARINGS IS THE SOUTH LINE OF THE SECTION FROM RS No. 3818 AND L-1232.

PROCEDURE

1. I HELD THE 5/8" IRON ROD AT THE NW CORNER PER RS No. 3818, THE 5/8" IRON ROD AT THE NE CORNER AS PER RS No. 3536, AND THE 5/8" IRON RODS ON EAST LINE OF THE 2 AC TRACT AS PER RS No. L-423.
2. I ESTABLISHED THE EAST LINE OF THE TRACTS PARALLEL TO THE NEHALEM HWY AS PER DEED. I DID NOT ACCEPT THE 3/4" IRON PIPES AT THE SE CORNER AS SET IN RS No. L-1232 AS THEY WERE SET AT INCORRECT LOCATIONS.
3. I ESTABLISHED THE SW CORNER AT THE DEEDED BEARING (N 86°47'W) FROM THE NE CORNER OF THE 2 AC TRACT AND ON THE EAST LINE OF NEHALEM HWY.

LEGEND

- - MONUMENT FOUND AS NOTED
- - SET A 5/8" X 30" IRON ROD WITH A YELLOW PLASTIC CAP MARKED "KEENON LS 1080"
- () - RECORD DATA I= RS No. 3536
- RS - RECORD SURVEY No.

REGISTERED
PROFESSIONAL
LAND SURVEYOR

Leslie G. Keenon

OREGON
JULY 30, 1976
LESLIE G. KEENON
1080

EXP 12/31/13

L JERRY KEENON
1311 ALDER ST.
VERNONIA, OREGON 97064
PH # 429-6115

COUNTY SURVEYOR
RECEIVED 6-7-93
FILED 6-28-93

B-203