


PROPERTY LINE ADJUSTMENT SURVEY FOR  
ANTHONY KRIEGER  
A PORTION OF PARCELS 2 & 3, PARTITION PLAT NO. 2008-6,  
IN THE NE 1/4 OF SECTION 5, T4N, R5W, W.M.  
CITY OF VERNONIA, COLUMBIA COUNTY, OREGON  
SCALE 1" = 20' AUGUST 11, 2017

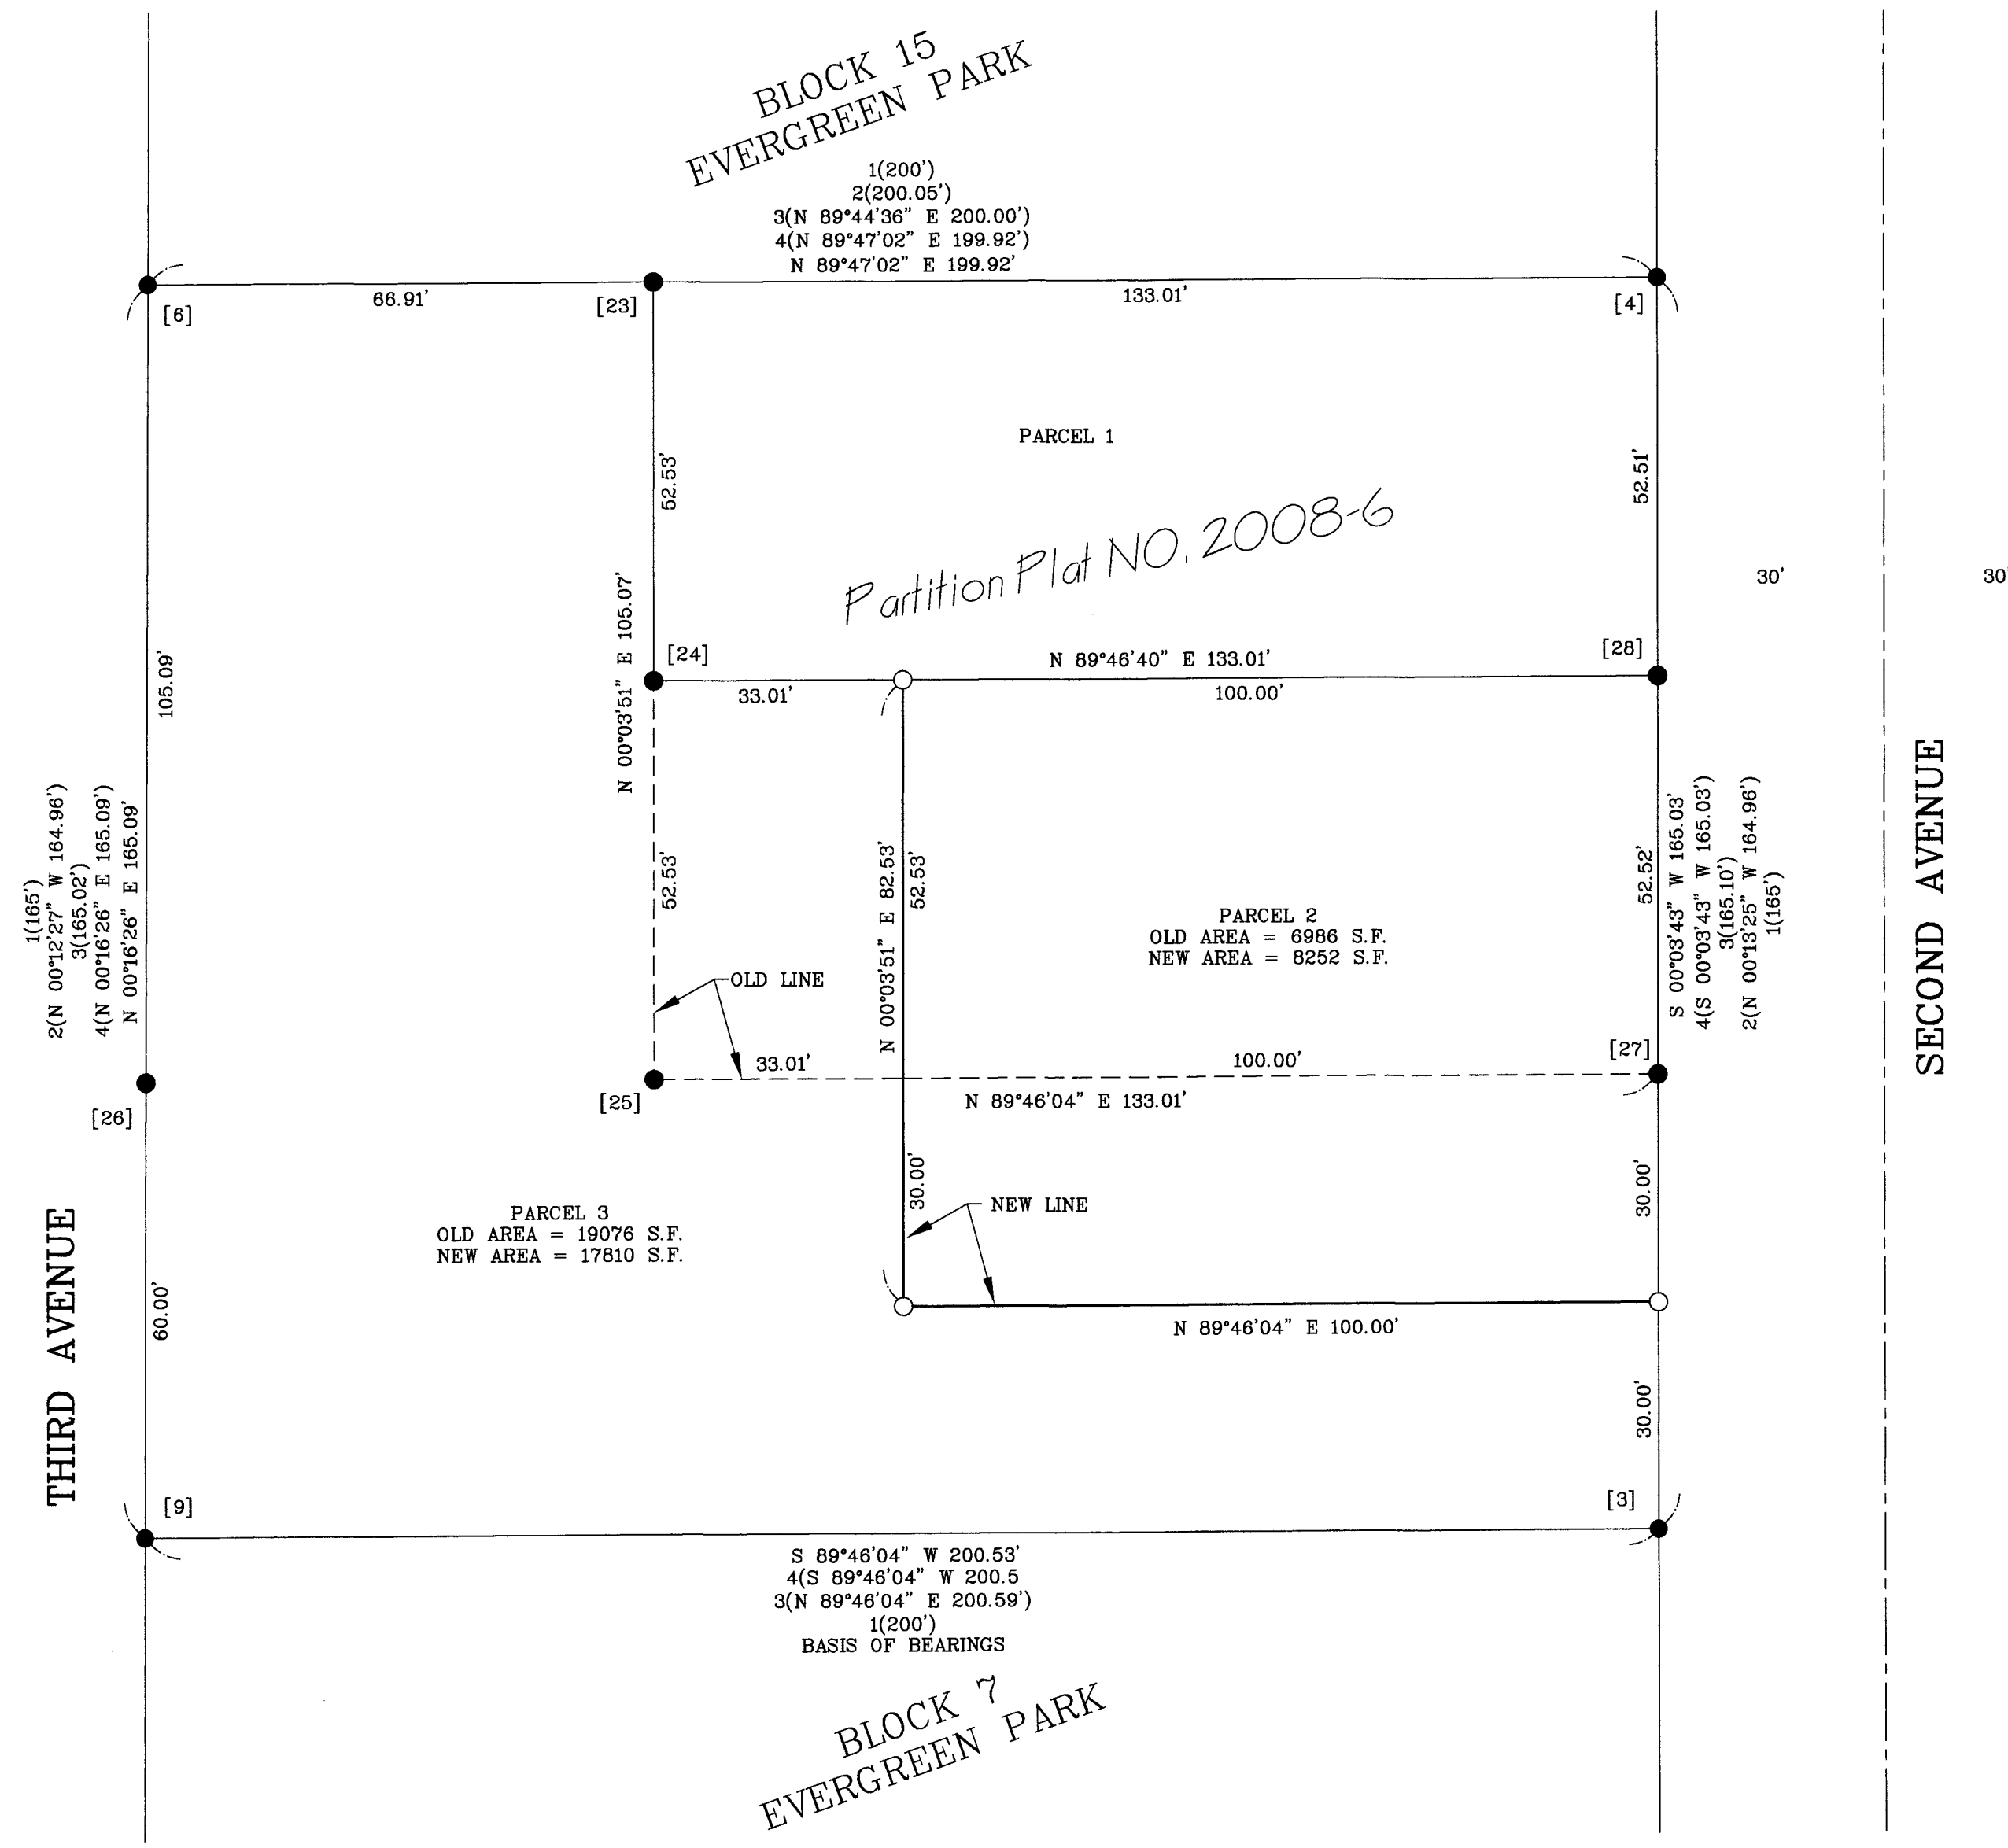

MONUMENT NOTES:

- [3] FOUND A 5/8" IRON ROD WITH A Y.P.C. MARKED "KEENON PLS 1080" PER CS NO. 3960, (HELD).
- [4] FOUND A 5/8" IRON ROD WITH A Y.P.C. MARKED "KEENON PLS 1080" PER CS NO. B-78, (HELD).
- [6] FOUND A 5/8" IRON ROD WITH A Y.P.C. MARKED "KEENON PLS 1080" PER CS NO. B-78, (HELD).
- [9] FOUND A 5/8" IRON ROD WITH A Y.P.C. MARKED "KEENON PLS 1080" PER CS NO. 3960, (HELD).
- [23] FOUND A 5/8" IRON ROD WITH A Y.P.C. MARKED "KLS SURVEYING INC" PER PARTITION PLAT 2008-6, (HELD).
- [24] FOUND A 5/8" IRON ROD WITH A Y.P.C. MARKED "KLS SURVEYING INC" PER PARTITION PLAT 2008-6, (HELD).
- [25] FOUND A 5/8" IRON ROD WITH A Y.P.C. MARKED "KLS SURVEYING INC" PER PARTITION PLAT 2008-6, (HELD).
- [26] FOUND A 5/8" IRON ROD WITH A Y.P.C. MARKED "KLS SURVEYING INC" PER PARTITION PLAT 2008-6, (HELD).
- [27] FOUND A 5/8" IRON ROD WITH A Y.P.C. MARKED "KLS SURVEYING INC" PER PARTITION PLAT 2008-6, (HELD).
- [28] FOUND A 5/8" IRON ROD WITH A Y.P.C. MARKED "KLS SURVEYING INC" PER PARTITION PLAT 2008-6, (HELD).

LEGEND:

- = MONUMENT FOUND AS NOTED
- = SET 5/8" X 30" IRON ROD WITH A Y.P.C. MARKED "K.L.S. SURVEYING INC"
- ( ) = RECORD SURVEY DATA
- CS NO.= RECORD SURVEY NUMBER
- Y.P.C. = YELLOW PLASTIC CAP
- [X] = MONUMENT POINT NUMBER (SEE MONUMENT NOTES)


NARRATIVE:

--THE PURPOSE OF THIS SURVEY IS TO ADJUST THE PROPERTY LINE BETWEEN PARCELS 2 & 3 OF PARTITION PLAT 2008-6 AT THE REQUEST OF ANTHONY KRIEGER

--BASIS OF BEARINGS IS THE SOUTH LINE OF PARTITION PLAT NO. 2008-06 BETWEEN MONUMENT NUMBERS 3 & 9.

--I HELD THE MONUMENTS AND RECORD PLAT DATA PER PARTITION PLAT 2008-6.

REFERENCE SURVEYS:  
1 = EVERGREEN PARK  
2 = CS NO. B-78  
3 = CS NO. 3960  
4 = PARTITION PLAT 2008-6

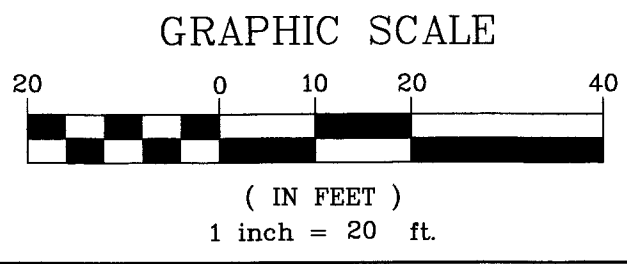

REGISTERED PROFESSIONAL LAND SURVEYOR  DONALD D WALLACE JR OREGON JANUARY 19, 1993 2601 RENEWAL DATE 6/30/18	 K.L.S. SURVEYING INC. 1224 ALDER STREET VERNONIA, OR 97064 (503)429-6115	SHEET 1 OF 1  JOB No. 17-266 PROJECT No. 7-100 DRAWN BY: SWM FIELD: SWMJR/THZ EQUIPMENT: GTS300/RANGER REVISED: 08/14/17
--	---	---