

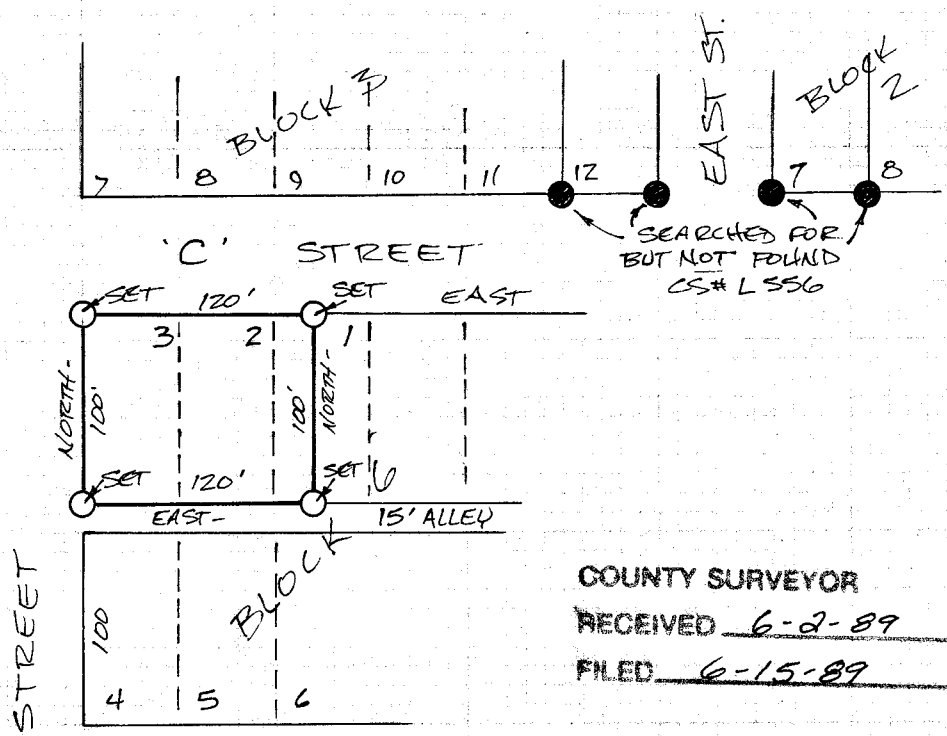


L-2118

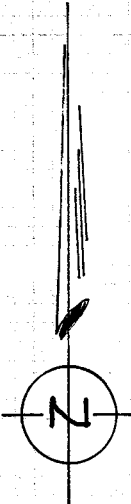

COUNTY SURVEYOR
RECEIVED 6-2-89
FILED 6-15-89

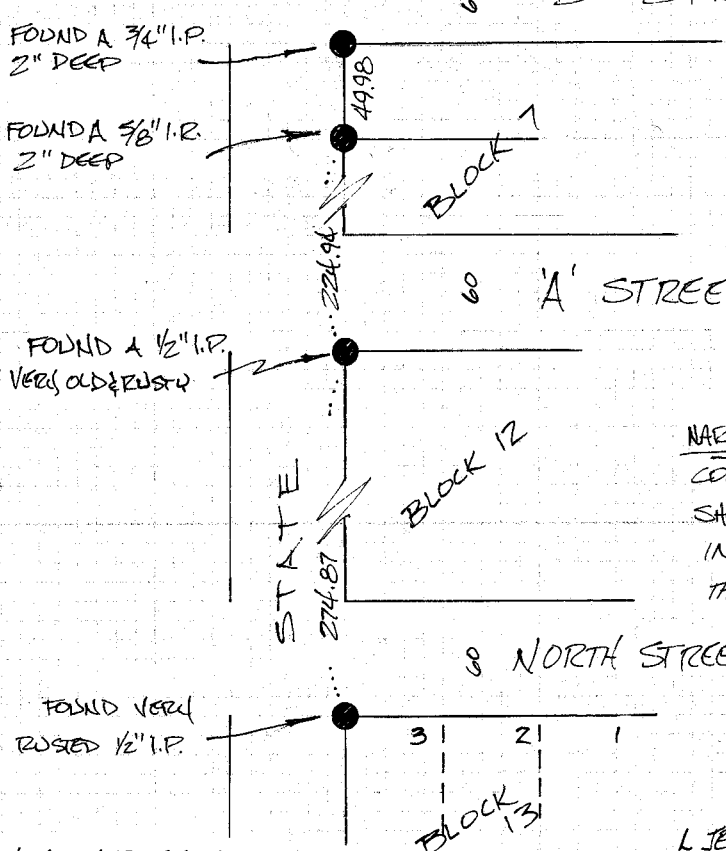

LOT SURVEY
for MR & MRS GARY DAVIS
in LOTS 1-2 & 3, BLOCK 6
EAST SIDE ADDITION TO
VERNONIA
IN THE SE 1/4 NW 1/4, SECTION 4
TWP 4N, RGE 4W, W.M.
COLUMBIA COUNTY, ORE.
SCALE 1"=100' MAY 8, 1989

NARRATIVE: THIS SURVEY IS BASED ON
CONTROL FROM THE RECOVERED MONUMENTS
SHOWN. ALL OF THE IRONS FOUND APPEAR
IN RECORD SURVEYS OF FIELD NOTES IN
THE COUNTY SURVEYORS OFFICE (PB 14 PB 13)
BASIS OF BRGS CS# L-556

NOTE: EACH CORNER SET IS
MONUMENTED WITH A 5/8"x30" I.R. DRIVEN
FLUSH, WITH A YELLOW PLASTIC SURVEYORS
CAP FIXED ON TOP MARKED "KEENON
LS 1080"

L JERRY KEENON
1311 ALDER ST
VERNONIA, ORE 97064
PH 429-6115

REGISTERED
PROFESSIONAL
LAND SURVEYOR

OREGON
JULY 30, 1976
LESLIE G. KEENON
P.L.S. 1080

L-2118