


0187

4870

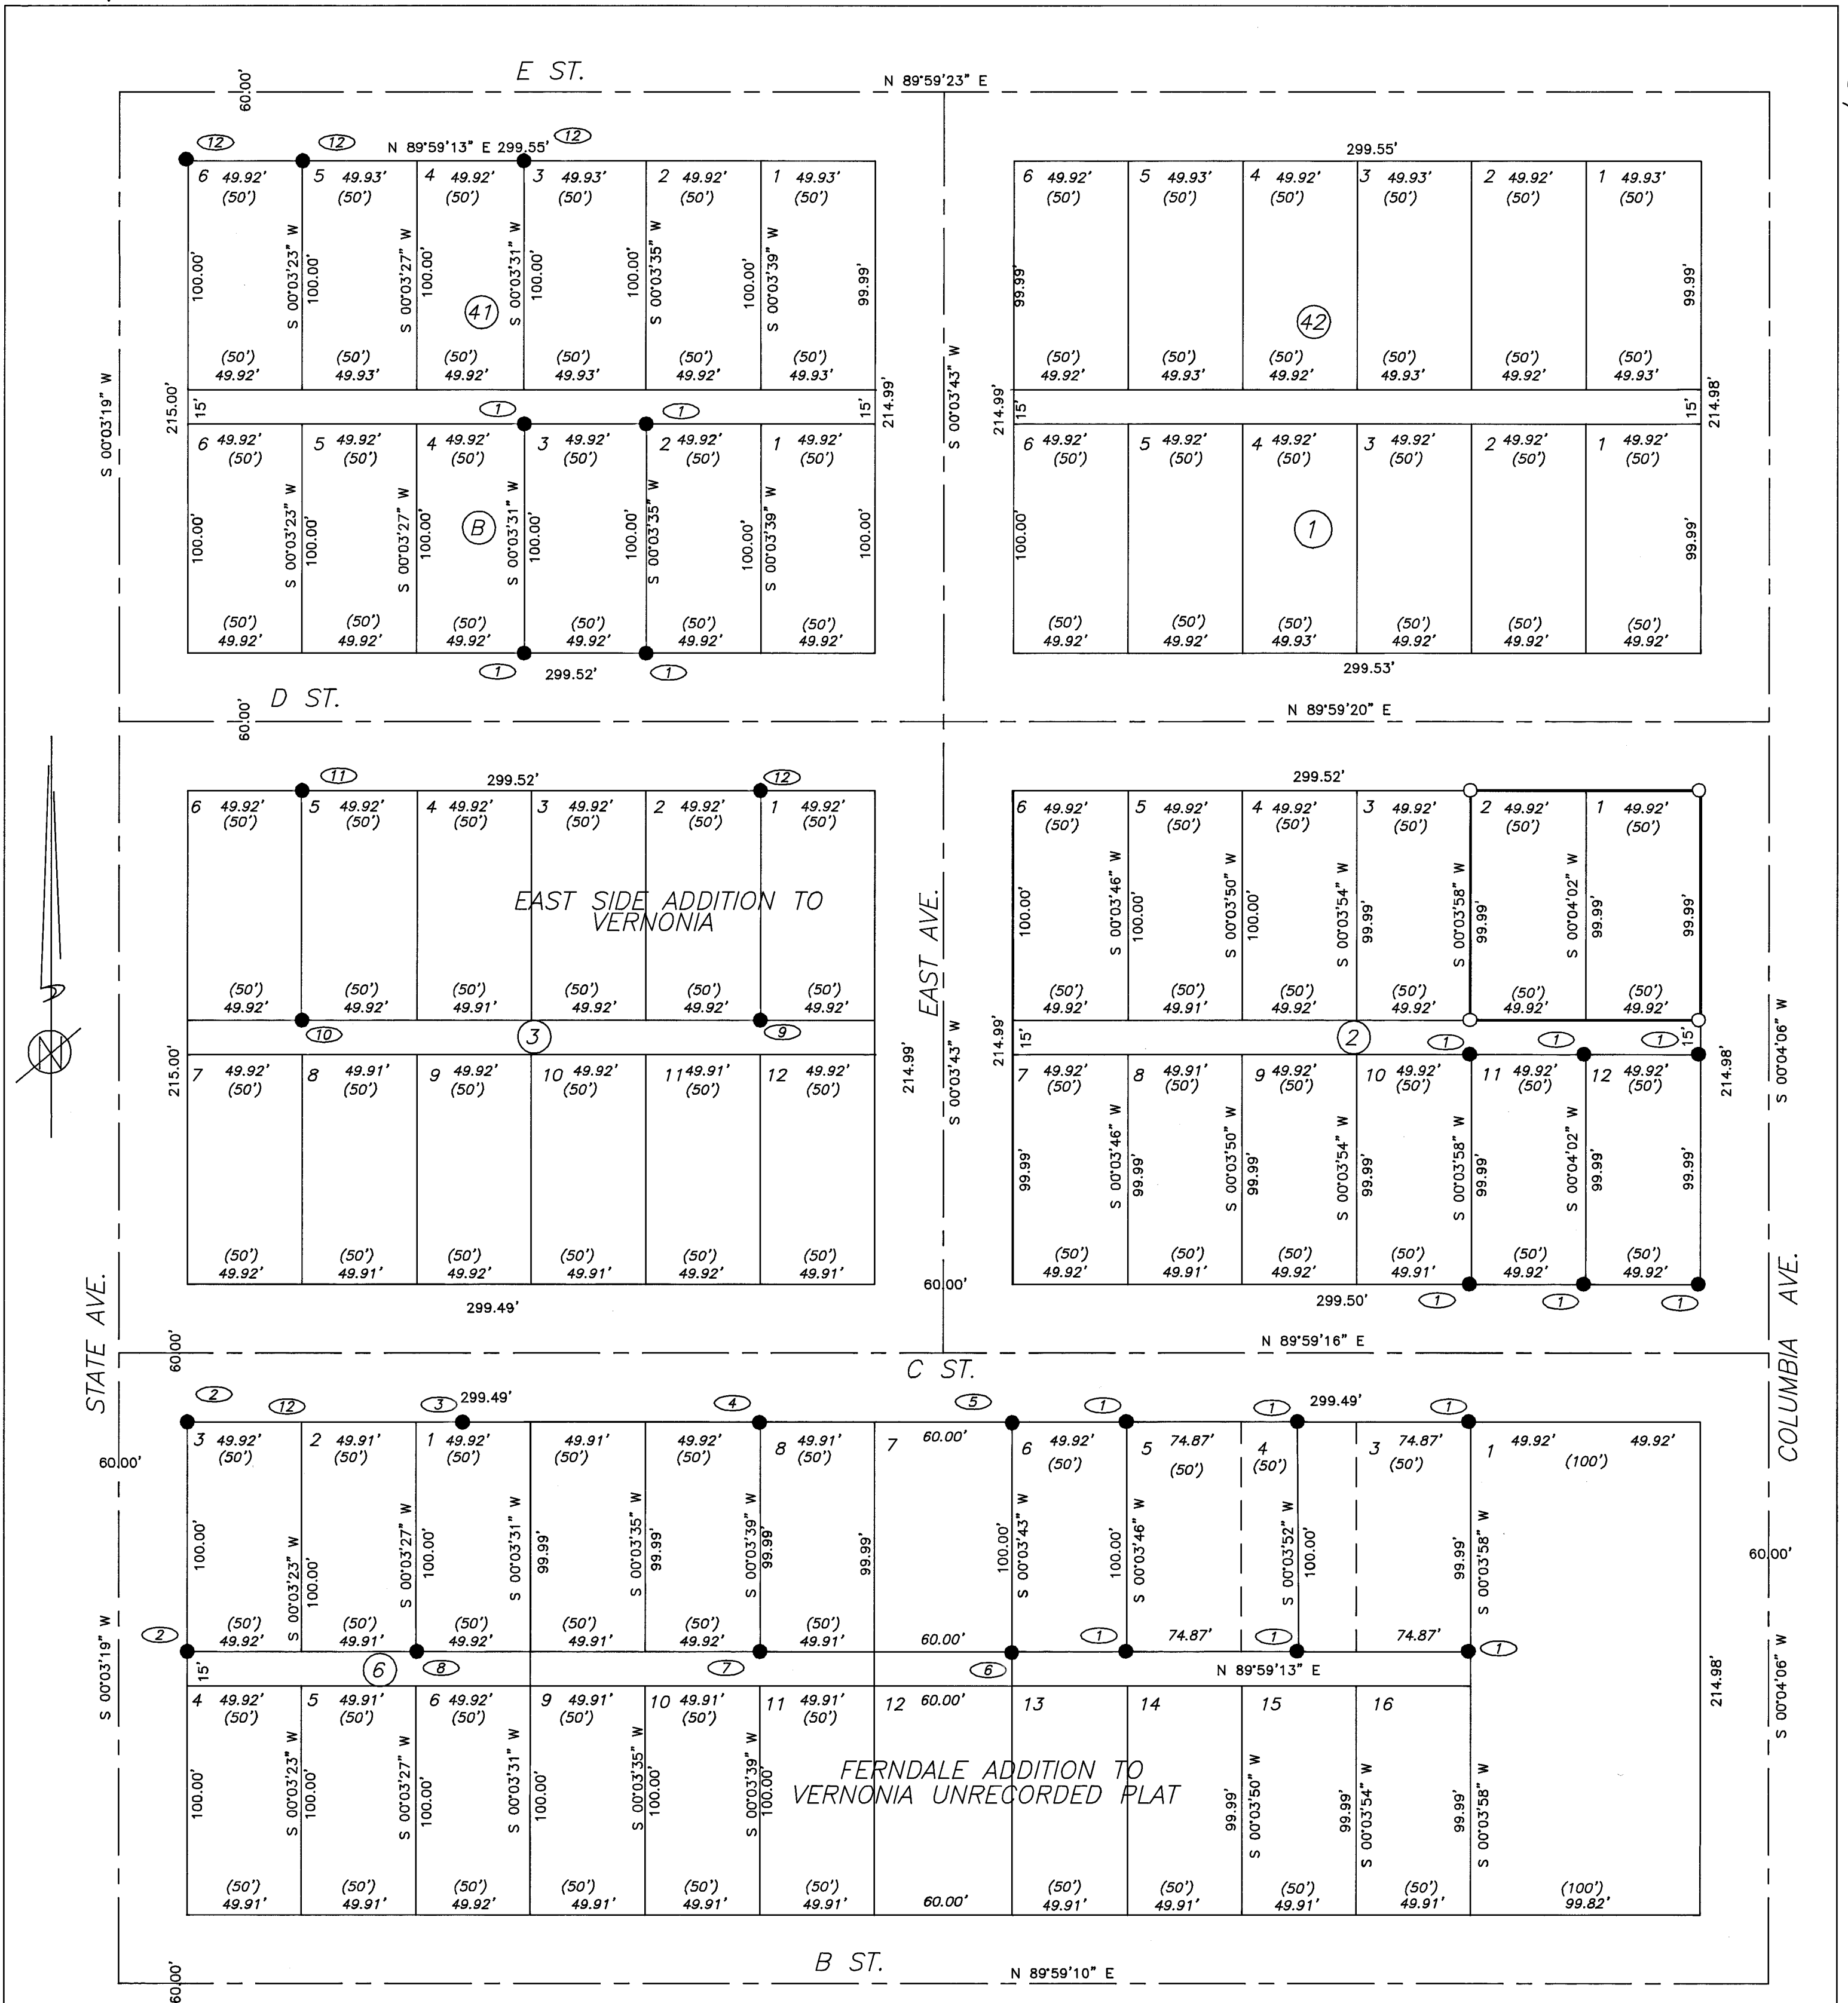

NARRATIVE:

--THIS SURVEY WAS ACCOMPLISHED AT THE REQUEST OF JON STEWART TO MONUMENT LOTS 1 & 2, BLOCK 2 IN EASTSIDE ADDITION TO VERNONIA.

--THE BASIS OF BEARINGS IS FROM CS No. 4094.

--FOR CONTROL I HELD THE RESOLUTION PER CS No. 3908, 4094 & 4322, ALL BEING SURVEYS IN EASTSIDE ADDITION TO VERNONIA.

LEGEND

● = MONUMENT FOUND AS NOTED

○ = SET A 5/8" x 30" IRON ROD WITH A Y.P.C. MARKED "KEENON LAND SERVICES INC."

() = RECORD SURVEY DATA

CS = RECORD SURVEY No.

Y.P.C. = YELLOW PLASTIC CAP

○ = CONTROL POINT No.

MONUMENT NOTES:

- ① 5/8" IRON ROD WITH A Y.P.C. MARKED "KEENON LAND SERVICES INC." PER CS No. 4094.
- ② 5/8" IRON ROD WITH A Y.P.C. MARKED "KEENON LS 1080" PER CS No. L-2118.
- ③ 5/8" IRON ROD WITH A Y.P.C. MARKED "KEENON LS 1080" PER CS No. L-2118. S 0.21' E 0.20'
- ④ 1/2" IRON ROD ORIGIN UNKNOWN S 0.34' W 0.18'
- ⑤ 5/8" IRON ROD WITH A Y.P.C. MARKED "KEENON LS 1080" PER CS No. B-82. S 0.49' E 0.53'
- ⑥ 5/8" IRON ROD WITH A Y.P.C. MARKED "KEENON LS 1080" PER CS No. B-82. S 0.55' E 0.52'
- ⑦ 5/8" IRON ROD WITH A Y.P.C. MARKED "KEENON LS 1080" PER CS No. B-82. S 0.36' E 0.41'
- ⑧ 5/8" IRON ROD WITH A Y.P.C. MARKED "KEENON LS 1080" PER CS No. L-2118. S 0.19' E 0.17'
- ⑨ 5/8" IRON ROD WITH A Y.P.C. MARKED "KEENON LS 1080" PER CS No. 3908. E 0.40' S 0.06'
- ⑩ 5/8" IRON ROD WITH A Y.P.C. MARKED "KEENON LS 1080" PER CS No. 3908. E 0.04'
- ⑪ 5/8" IRON ROD WITH A Y.P.C. MARKED "KEENON LS 1080" PER CS No. 3908.
- ⑫ 5/8" IRON ROD PER CS No. L-556. S 0.20' E 0.46'

REGISTERED
PROFESSIONAL
LAND SURVEYOR

Leslie G. Keenon

OREGON
JULY 30, 1976
LESLIE G. KEENON
1080
RENEWAL DATE 6/30/01

LAND
SERVICES

KEENON

1224 ALDER ST.
VERNONIA, OR 97064
(503) 429-6115

SURVEY FOR
JON STEWART
LOTS 1 & 2, BLOCK 2, EAST SIDE ADDITION
TO VERNONIA, IN THE NW 1/4 OF
SECTION 4, T4N, R4W, W.M.
COLUMBIA COUNTY, OREGON
SCALE 1" = 50' OCT. 19, 2000

COLUMBIA COUNTY
SURVEYORS OFFICE

RECEIVED _____
ACCEPTED _____
CHECK # 555

DRAWN BY: DDW

FIELD: MWM/JDB

EQUIPMENT: GTS300/TDS48

JOB No. 00-175

PROJECT No. VERNONIA

REVISED: 3/28/01

4870

4870