


9817

CS 1/16 CORNER
3" BRASS CAP
PER C.S. 3099

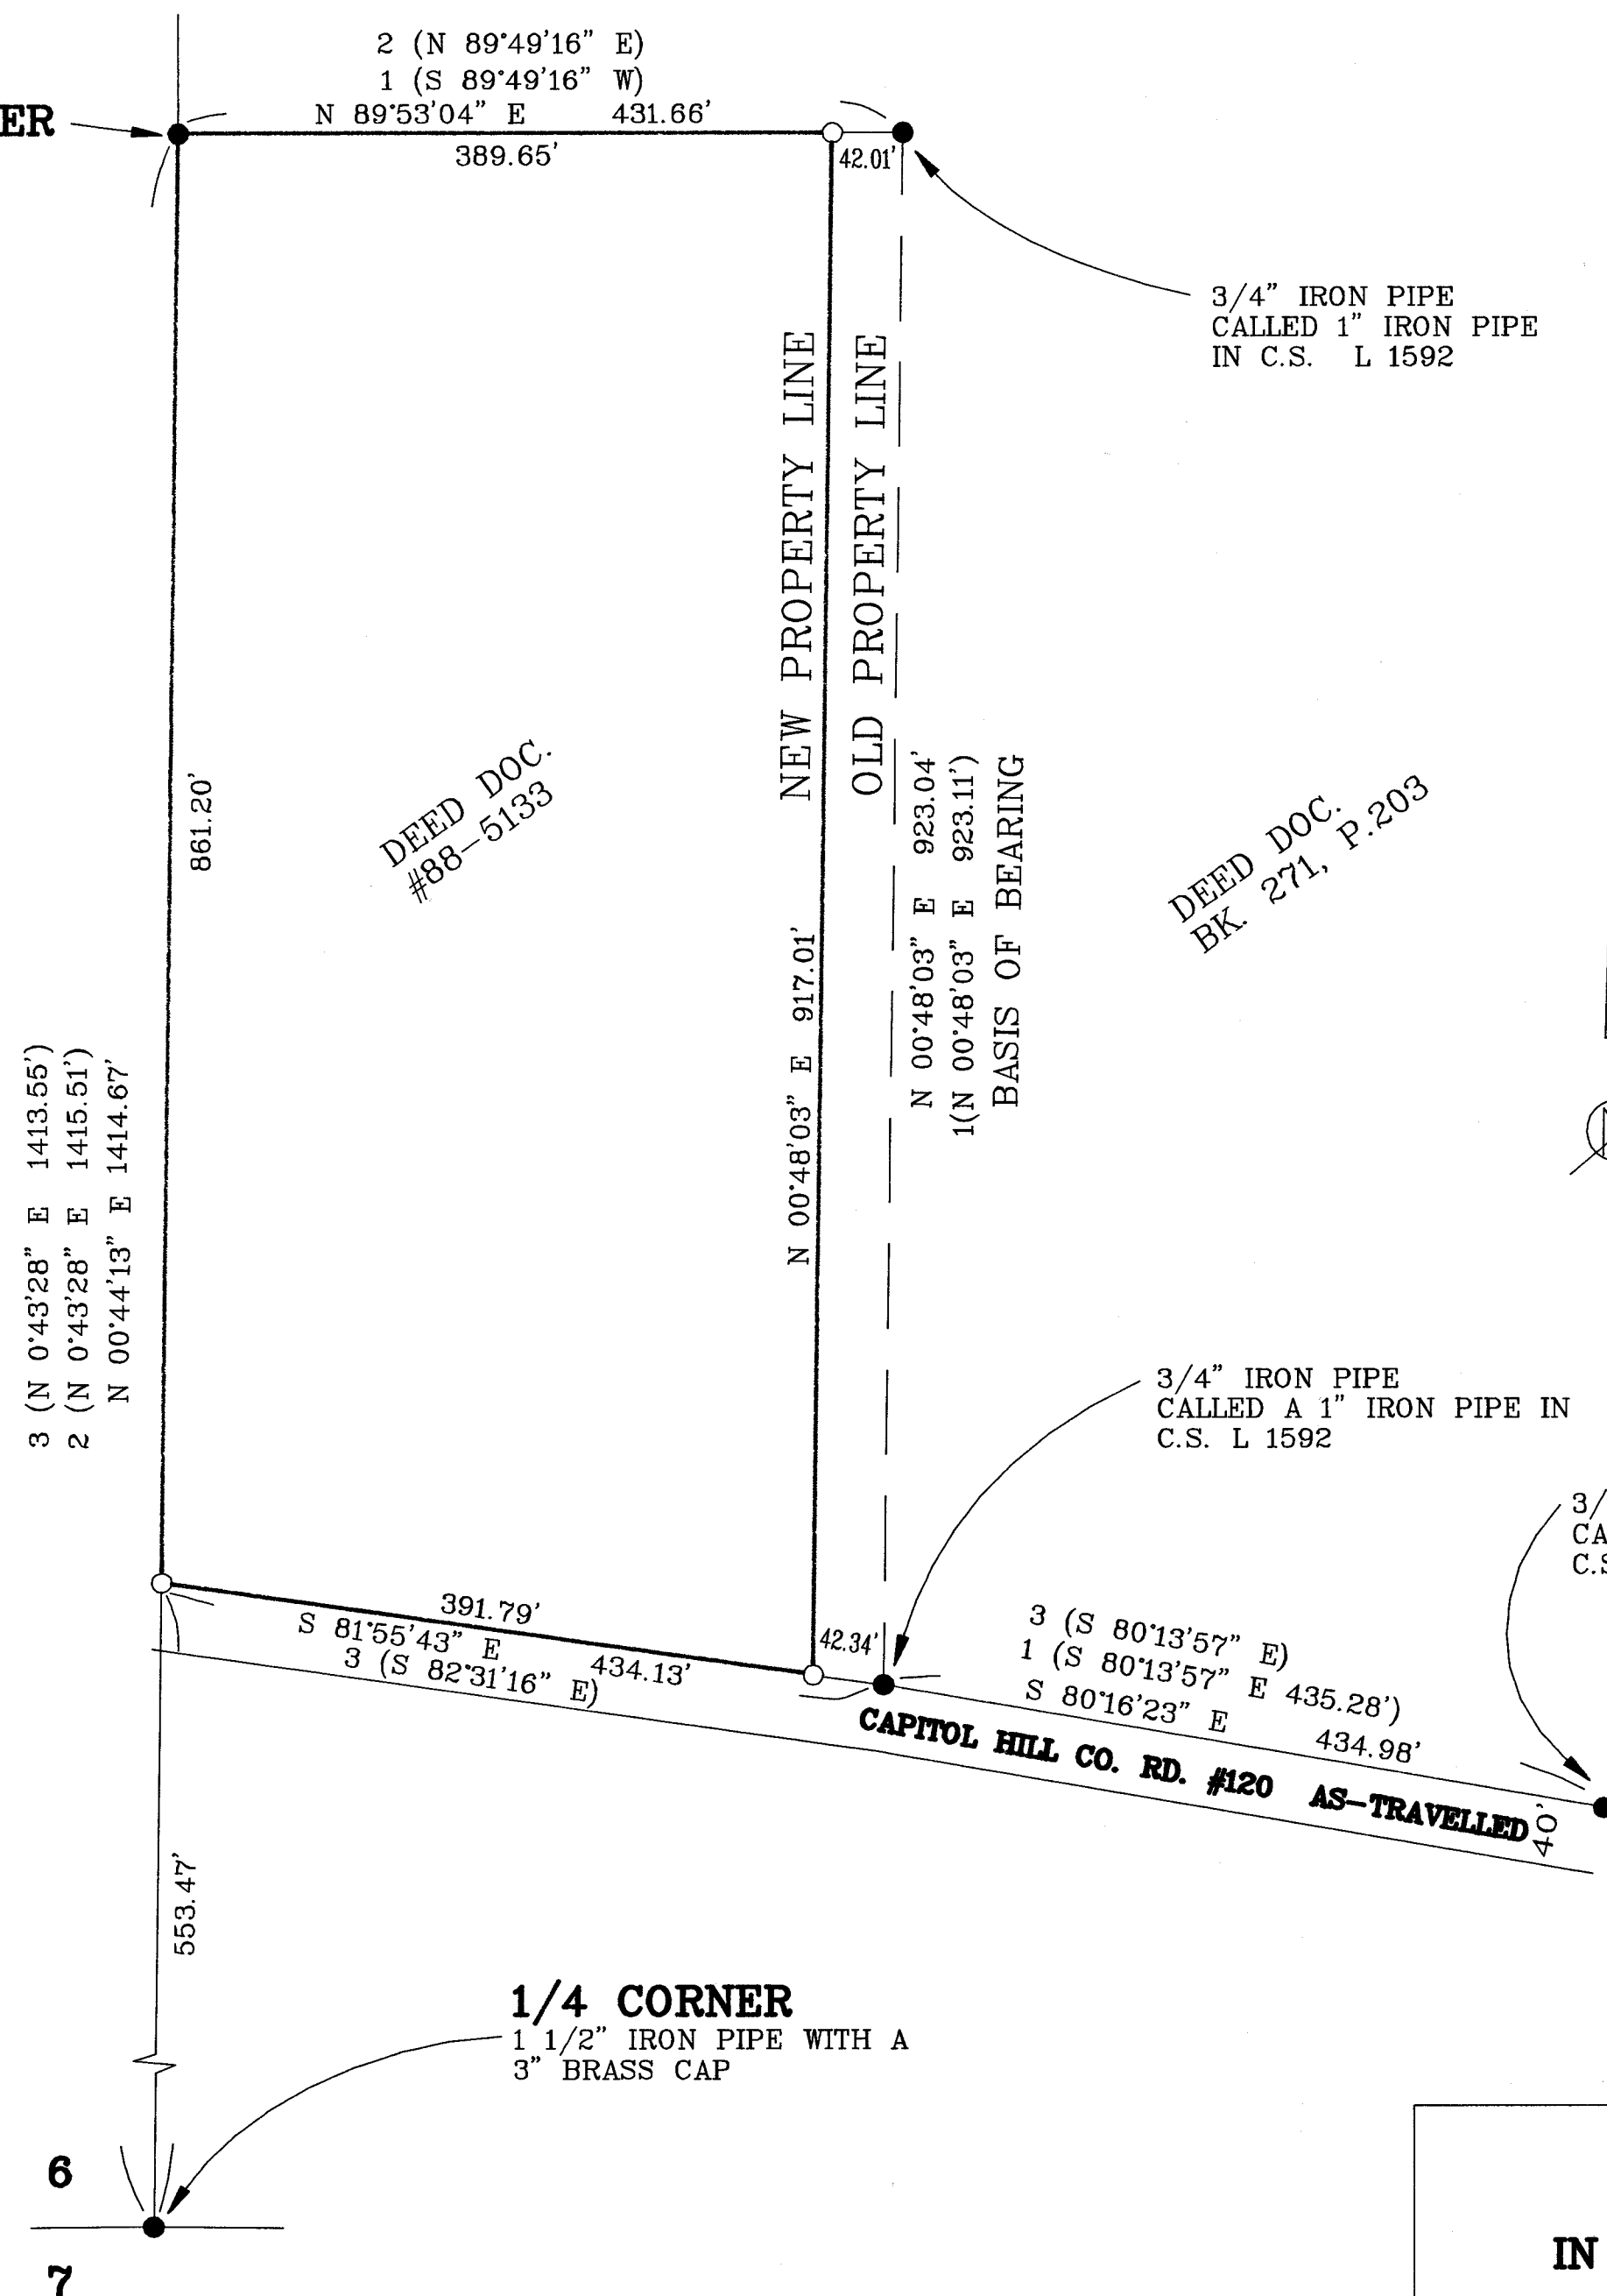

NARRATIVE:

--THIS SURVEY WAS ACCOMPLISHED AT THE REQUEST OF HOWARD ELLIS TO MONUMENT A PROPERTY LINE ADJUSTMENT OF THE COMMON BOUNDARY BETWEEN DEED BOOK 271 PAGE 203, AND DEED DOCUMENT No. 88-5133.
--FOR CONTROL I HELD THE MONUMENTS OF RECORD AS SHOWN.
--BASIS OF BEARING IS FROM CS L-1592.


LEGEND

- = MONUMENT FOUND AS NOTED
- = SET A 5/8" X 30" IRON ROD WITH A YELLOW PLASTIC CAP MARKED "KEENON LAND SERVICES INC"
- () = RECORD DATA 1 = CS No. L 1592
2 = CS No. 3099
3 = CS No. 3218
- CS = RECORD SURVEY No.
- Y.P.C. = YELLOW PLASTIC CAP

**RECORD OF SURVEY
FOR HOWARD ELLIS
IN THE SE 1/4 OF SECTION 6,
T4N, R4W, W.M.
COLUMBIA COUNTY, OREGON
SCALE 1" = 100' AUGUST 15, 1996**

REGISTERED
PROFESSIONAL
LAND SURVEYOR

OREGON
JULY 30, 1976
LESLIE G. KEENON
1080
RENEWAL DATE 6/30/97

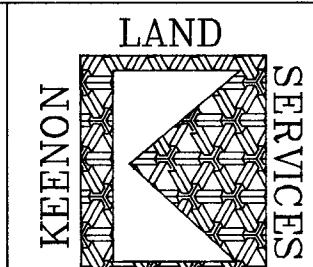

1224 ALDER ST
VERNONIA, OR
97064
(503) 429-6225

COLUMBIA COUNTY SURVEYORS OFFICE
RECEIVED 11-18-96
ACCEPTED FOR FILING 12-18-96
CHECK No. 23

DRAWN BY: MATT M. CHECKED BY: DDW REVISED: JOB No. 96-072

4186