

#### NARRATIVE:

--THIS SURVEY WAS ACCOMPLISHED AT THE REQUEST OF WEYERHAEUSER COMPANY TO MARK AND MONUMENT THE BOUNDARY LINES SHOWN AS HATCHED IN SECTION 26 TOWNSHIP 5 NORTH, RANGE 5 WEST OF THE WILLAMETTE MERIDIAN.

---THE BASIS OF BEARINGS ARE BASED ON CS NO. 5172, BETWEEN MONUMENTS 1 AND 32.

--ALL REFERENCES WERE MEASURED WITH A HAND COMPASS SET AT DECLINATION 16° EAST AND A STEEL TAPE.


--BOUNDARY LINES SHOWN AS HATCHED WERE MARKED WITH RED RIBBON ON LINE WITH 1/2" X 6' FIBERGLASS RODS AT 100' ± INTERVALS, BLAZES AT CHEST HEIGHT WITH ORANGE PAINT ON TREES WITHIN 10' ± ON THE NORTH SIDE OF LINE.

#### MONUMENT NOTES:

[1]  
CENTER 1/4 OF SECTION 26  
FOUND A 5/8" IRON ROD WITH A Y.P.C. MARKED "KEENON LAND SERVICES INC.", PER CS NO. 5172 (HELD),  
REFERENCES FOUND  
FOUND A 3" BRASS DISK BEARS N 86°59'59" W 79.33', PER CS NO. M-382  
A WHITE FIBERGLASS POST BEARS S 65° E 0.2'  
A 9" FIR BEARS S 5° W 12.9' TO HEALED FACE WITH A WILLAMETTE INDUSTRIES YELLOW TAG  
A 11" FIR BEARS N 15° W 18.0' TO HEALED FACE WITH A KLS YELLOW TAG  
A 14" FIR HIGH STUMP BEARS N 78° E 26.0' TO HEALED FACE WITH A WILLAMETTE INDUSTRIES YELLOW TAG.

[32]  
1/4 CORNER COMMON TO SECTIONS 26 AND 27  
FOUND A 1" IRON PIPE UP 12" WITH A 9" ALDER GROWING OVER TOP OF THE PIPE, PER CS NO. 968 (HELD),  
REFERENCES FOUND  
A 8" FIR BEARS N 35° W 3.2' TO HEALED FACE WITH A WILLAMETTE INDUSTRIES YELLOW TAG  
A 32" FIR STUMP N 85° W 5.9' TO HEALED FACE WITH A WILLAMETTE INDUSTRIES YELLOW TAG  
A 8" FIR BEARS S 31° E 17.1' TO HEALED FACE WITH A WILLAMETTE INDUSTRIES YELLOW TAG  
A 9" FIR BEARS S 37° E 21.7' TO HEALED FACE WITH A WILLAMETTE INDUSTRIES YELLOW TAG  
A 12" FIR BEARS N 65° E 28.0' TO HEALED FACE NO TAG.

#### WEYERHAEUSER COMPANY

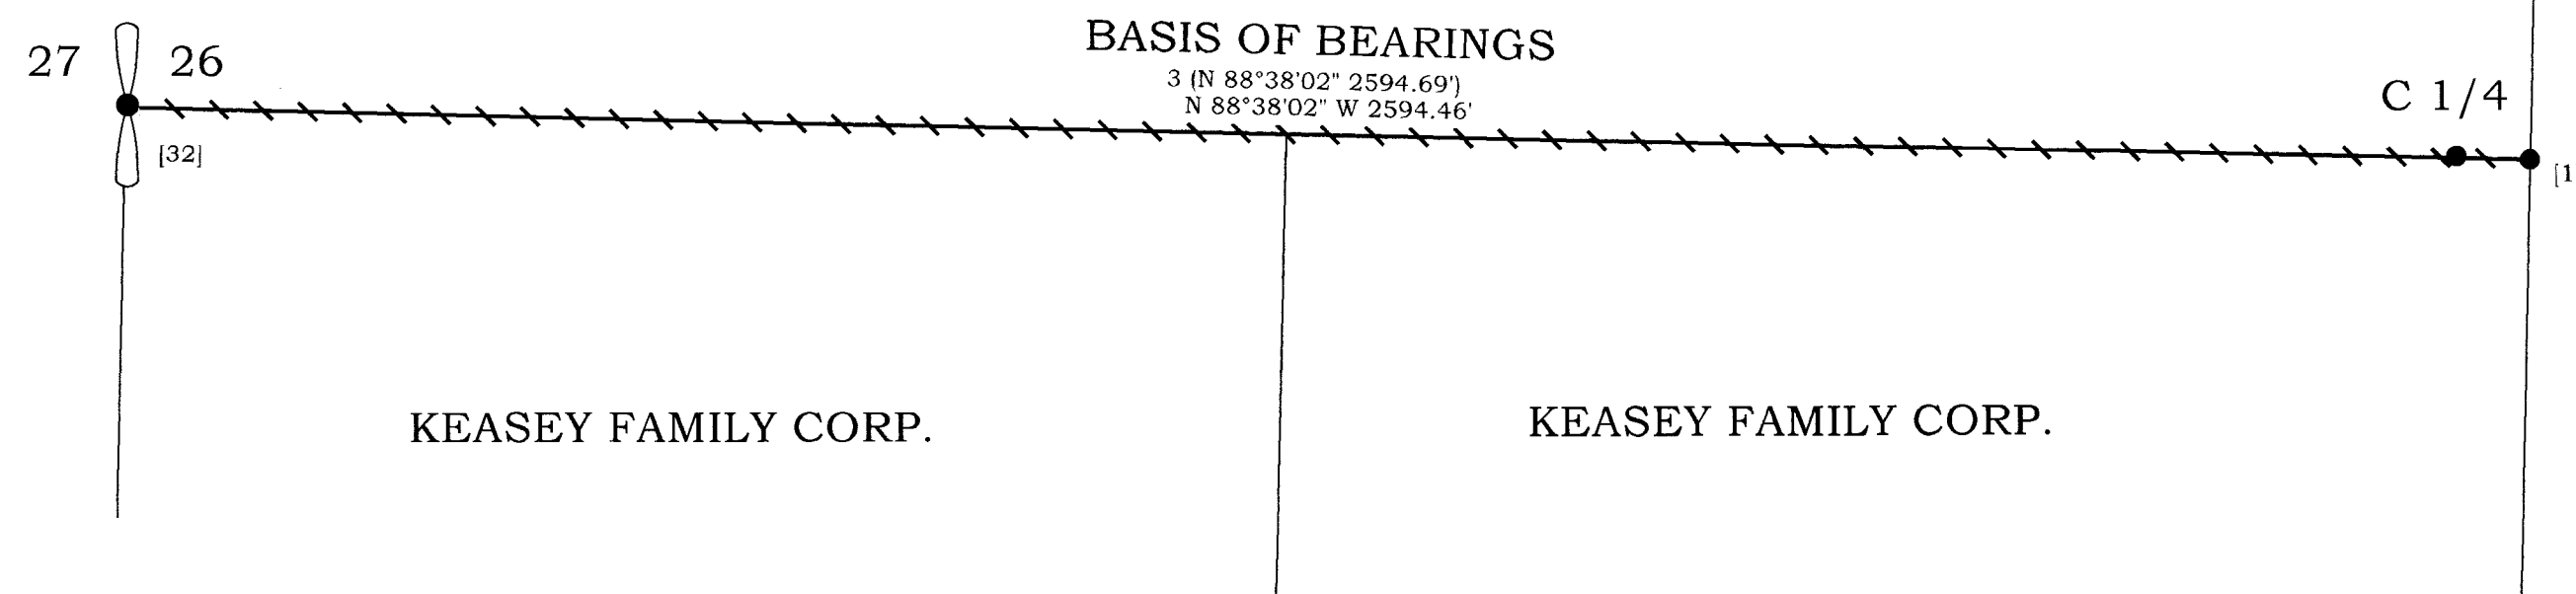

#### LEGEND

- FOUND MONUMENT AS NOTED
- [X] MONUMENT POINT NO
- ( ) RECORD SURVEY DATA
- CS NO. COUNTY SURVEY NUMBER, COLUMBIA COUNTY SURVEY RECORDS
- Y.P.C. YELLOW PLASTIC CAP
- /// MARKED BOUNDARY LINE

#### REFERENCES:

SURVEYS  
1 = CS NO. 968  
2 = CS NO. M-382  
3 = CS NO. 5172

REGISTERED PROFESSIONAL LAND SURVEYOR  OREGON JANUARY 19, 1993 DONALD D WALLACE, JR 2601 RENEWS 6/30/22	 K.L.S. SURVEYING INC. 1224 ALDER STREET VERNONIA, OREGON 97064 (503) 429-6115	RECORD OF SURVEY FOR  WEYERHAEUSER COMPANY IN THE WEST 1/2 OF SECTION 26, T5N, R5W, W.M., COLUMBIA COUNTY, OREGON MAY 4, 2021	DRAWN BY: DJL FIELD: BTJ/KJN EQUIPMENT: NOMAD/NIKON JOB No. 21-191 DRAWING NAME: 21-191 ROS REVISED: 11-11-2021
---	--	---	--