



RECORD OF SURVEY
for DON AND NANCEY DAILEY
IN THE NE 1/4 SEC 3, T4N, R4W, WM.
AND FIRST ADDITION
TO RIVERVIEW LOTS
COLUMBIA COUNTY, OREGON
SCALE 1"=100' MARCH 24, 1992

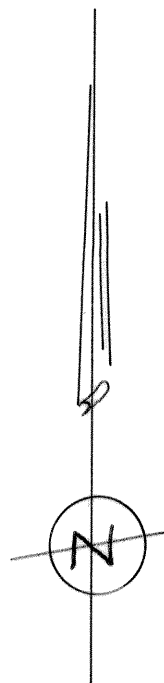

NARRATIVE: THIS SURVEY WAS DONE AT THE REQUEST OF DON AND NANCEY DAILEY TO MONUMENT THE BOUNDARIES OF LOT 1 BLOCK 3 FIRST ADDITION TO RIVERVIEW LOTS AND THAT TRACT AS DESCRIBED IN DEED BOOK 186 PAGE 849, COLUMBIA COUNTY DEED RECORDS. CONTROL FOR THIS SURVEY IS FROM RS NO. 3402 AND FIRST ADDITION TO RIVERVIEW LOTS. I HELD RECORD BEARINGS AND DISTANCES TO ESTABLISH THE CORNERS OF SAID TRACT. THE BASIS OF BEARINGS IS THE CENTERLINE OF ALDER STREET FROM RS NO. 3402.

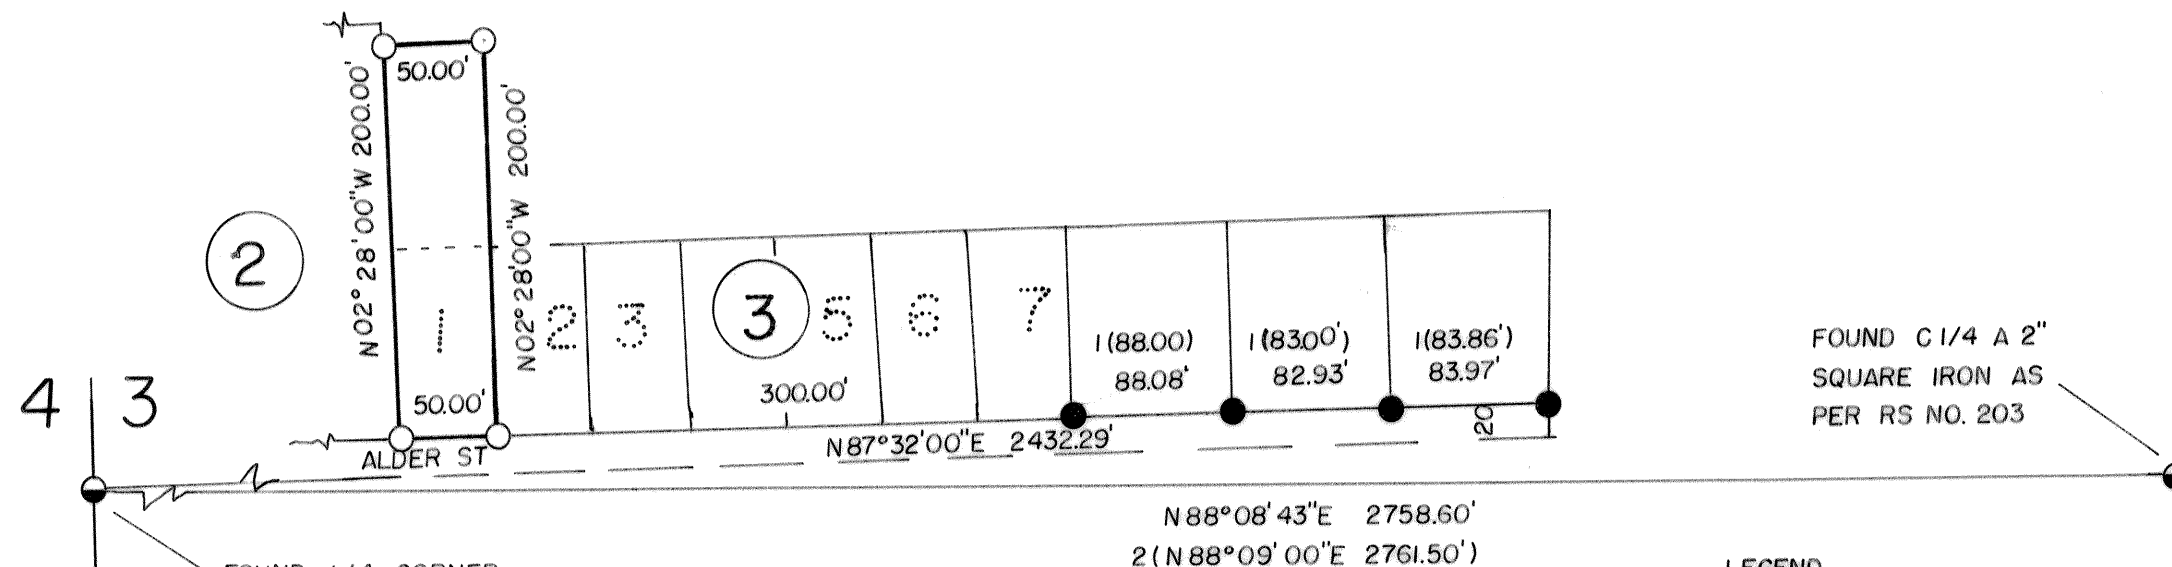

FOUND 1/4 CORNER
A 5/8" IR WITH CAP
MARKED "RUSSELL PLS 707"
IN PAVEMENT ON SOUTH
SIDE OF HWY 47.

L. JERRY KEENON
1311 ALDER ST.
VERNONIA, OREGON 97064
PH # 429-6115

FOUND C 1/4 A 2"
SQUARE IRON AS
PER RS NO. 203

LEGEND

- — MONUMENT FOUND AS NOTED
- — FOUND A 5/8" IR WITH CAP "LS 847" RS NO. 3402
- — SET A 5/8" X 30" IR WITH A YELLOW PLASTIC CAP MARKED "KEENON LS 1080"
- () — RECORD DATA 1 = RS NO. 3402
2 = RS NO. 203

RS — RECORD SURVEY
IR — IRON ROD

DRAWN BY: DON WALLACE



COUNTY SURVEYOR
RECEIVED 6-4-92
FILED 7-1-92