



5444

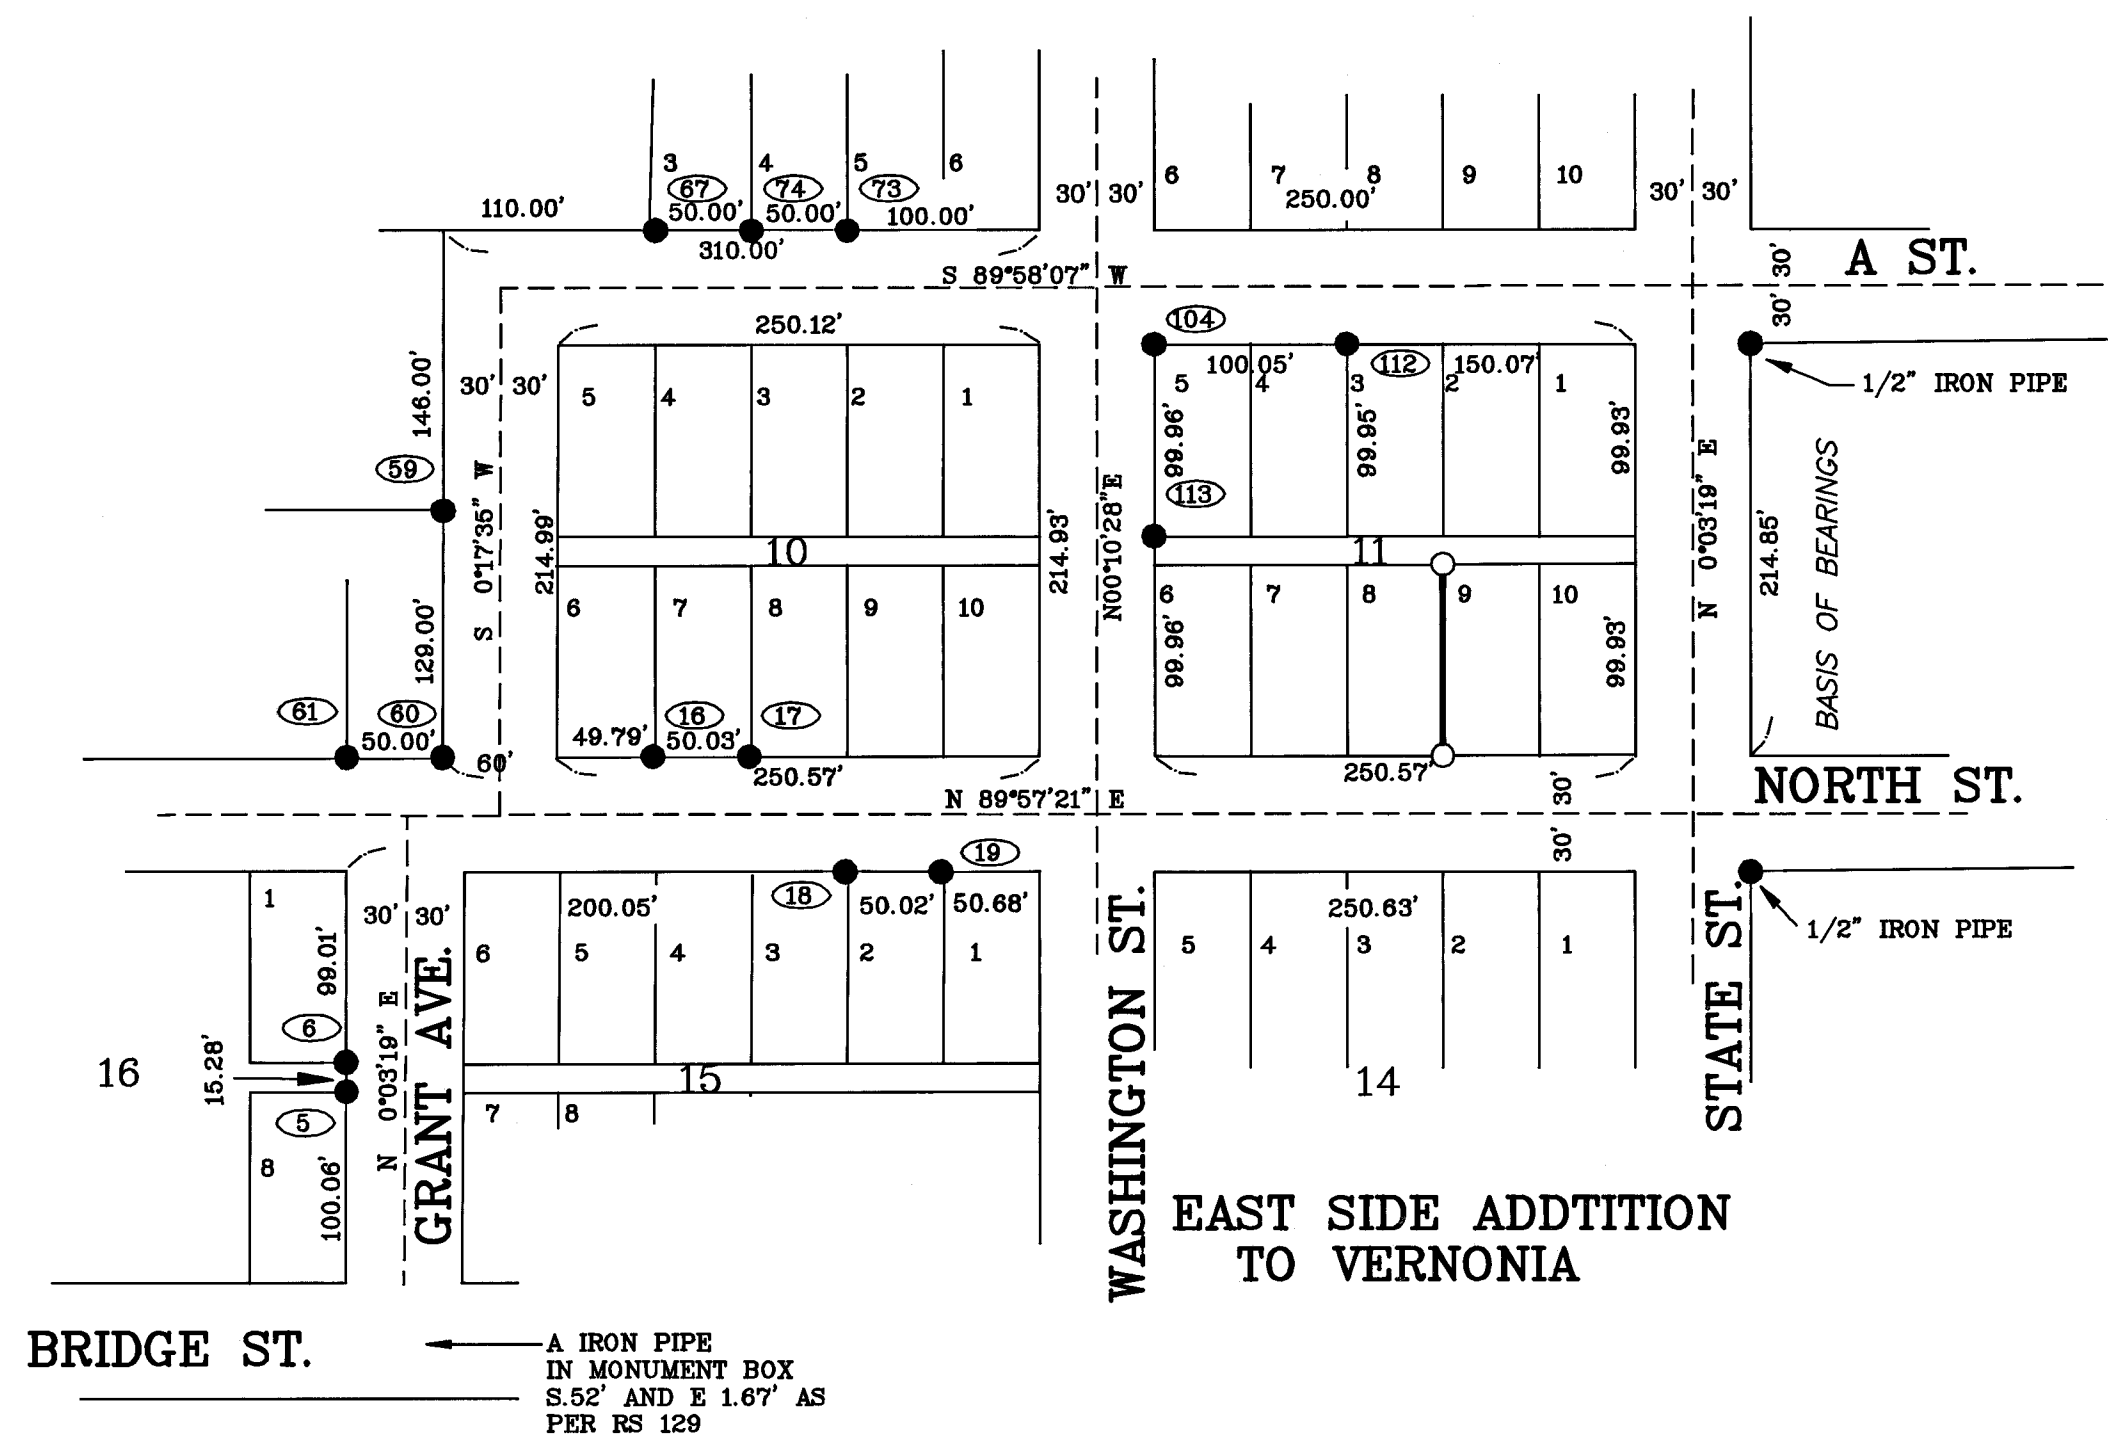

DETAIL OF BLOCK 11
SCALE 1" = 50'

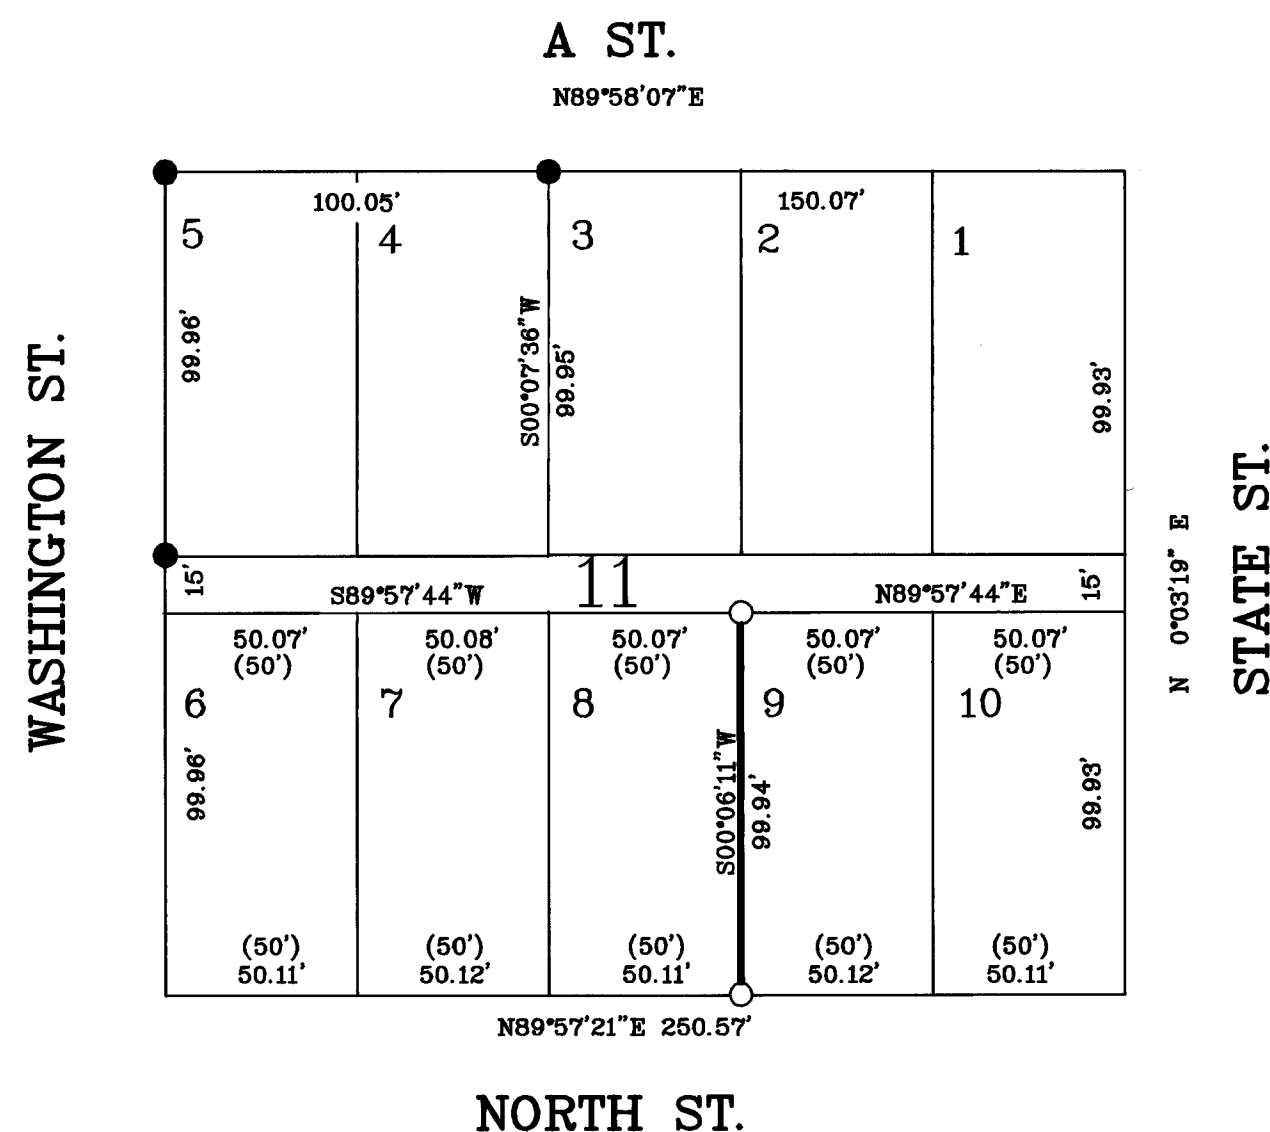

NARRATIVE:

-- THIS SURVEY WAS ACCOMPLISHED AT THE REQUEST OF THE TROY JERMAN TO MONUMENT THE WEST LINE OF LOT 9 OF BLOCK 11, EAST SIDE ADDITION TO VERNONIA.

-- THE BEARINGS ARE BASED ON THE TIES BETWEEN THE MONUMENTS ON STATE STREET FROM CS No. 3906.

-- FOR CONTROL I HELD CS No. 3988, 4280 AND THE MONUMENTS NOTED THEREIN

LEGEND

- = MONUMENT FOUND AS NOTED
- = SET A 5/8" x 30" IRON ROD WITH A Y.P.C. MARKED "KEENON LAND SERVICES INC."
- () = RECORD PLAT DATA
- CS = RECORD SURVEY No.
- Y.P.C. = YELLOW PLASTIC CAP
- = CONTROL POINT No.

MONUMENT NOTES

- (5) 1/2" IRON PIPE PER RS L-1332
- (6) 5/8" IRON ROD ORIGIN UNKNOWN
- (16) 5/8" IRON ROD WITH CAP PER RS L-1631 N 0.22'
- (17) 5/8" IRON ROD WITH CAP PER RS L-1631 N 0.12'
- (18) 5/8" IRON ROD WITH CAP PER RS L-1954
- (19) 5/8" IRON ROD WITH CAP PER RS L-1954
- (59) 5/8" IRON ROD WITH A Y.P.C. MARKED "KEENON LAND SERVICES INC." PER CS No.
- (60) 5/8" IRON ROD WITH A Y.P.C. MARKED "KEENON LAND SERVICES INC." PER CS No. 3988
- (61) 5/8" IRON ROD WITH A Y.P.C. MARKED "KEENON LAND SERVICES INC." PER CS No. 3988
- (67) 5/8" IRON ROD WITH A Y.P.C. MARKED "KEENON LAND SERVICES INC." PER CS No. 3988
- (73) 5/8" IRON ROD WITH A Y.P.C. MARKED "KEENON LAND SERVICES INC." PER CS No. 3988
- (74) 5/8" IRON ROD WITH A Y.P.C. MARKED "KEENON LAND SERVICES INC." PER CS No. 3988
- (104) 5/8" IRON ROD WITH A Y.P.C. MARKED "KEENON LAND SERVICES INC." PER CS No. 4280.
- (112) 5/8" IRON ROD WITH A Y.P.C. MARKED "KEENON LAND SERVICES INC." PER CS No. 4280.
- (113) 5/8" IRON ROD WITH A Y.P.C. MARKED "KEENON LAND SERVICES INC." PER CS No. 4280.

<p>REGISTERED PROFESSIONAL LAND SURVEYOR</p> <p><i>Leslie G. Keenon</i></p> <p>OREGON JULY 30, 1976 LESLIE G. KEENON 1080 RENEWAL DATE 6/30/01</p>	<p>KEENON LAND SERVICES</p> <p>1224 ALDER ST. VERNONIA, OR 97064 (503) 429-6115</p>	<p>SURVEY FOR TROY JERMAN IN EAST SIDE ADDITION TO VERNONIA, IN THE NW 1/4 OF SECTION 4, T4N, R4W, W.M. COLUMBIA COUNTY, OREGON SCALE 1" = 100' MARCH 31, 2000</p>		<p>COLUMBIA COUNTY SURVEYORS OFFICE</p> <p>RECEIVED _____ ACCEPTED _____ CHECK # _____</p>
		<p>DRAWN BY: DDW FIELD: MWM/JDB EQUIPMENT: GTS300/TDS48 JOB No. 00-068A PROJECT No. 94-197 REVISED: 4/28/00</p>		

4743