


BRIDGE STREET

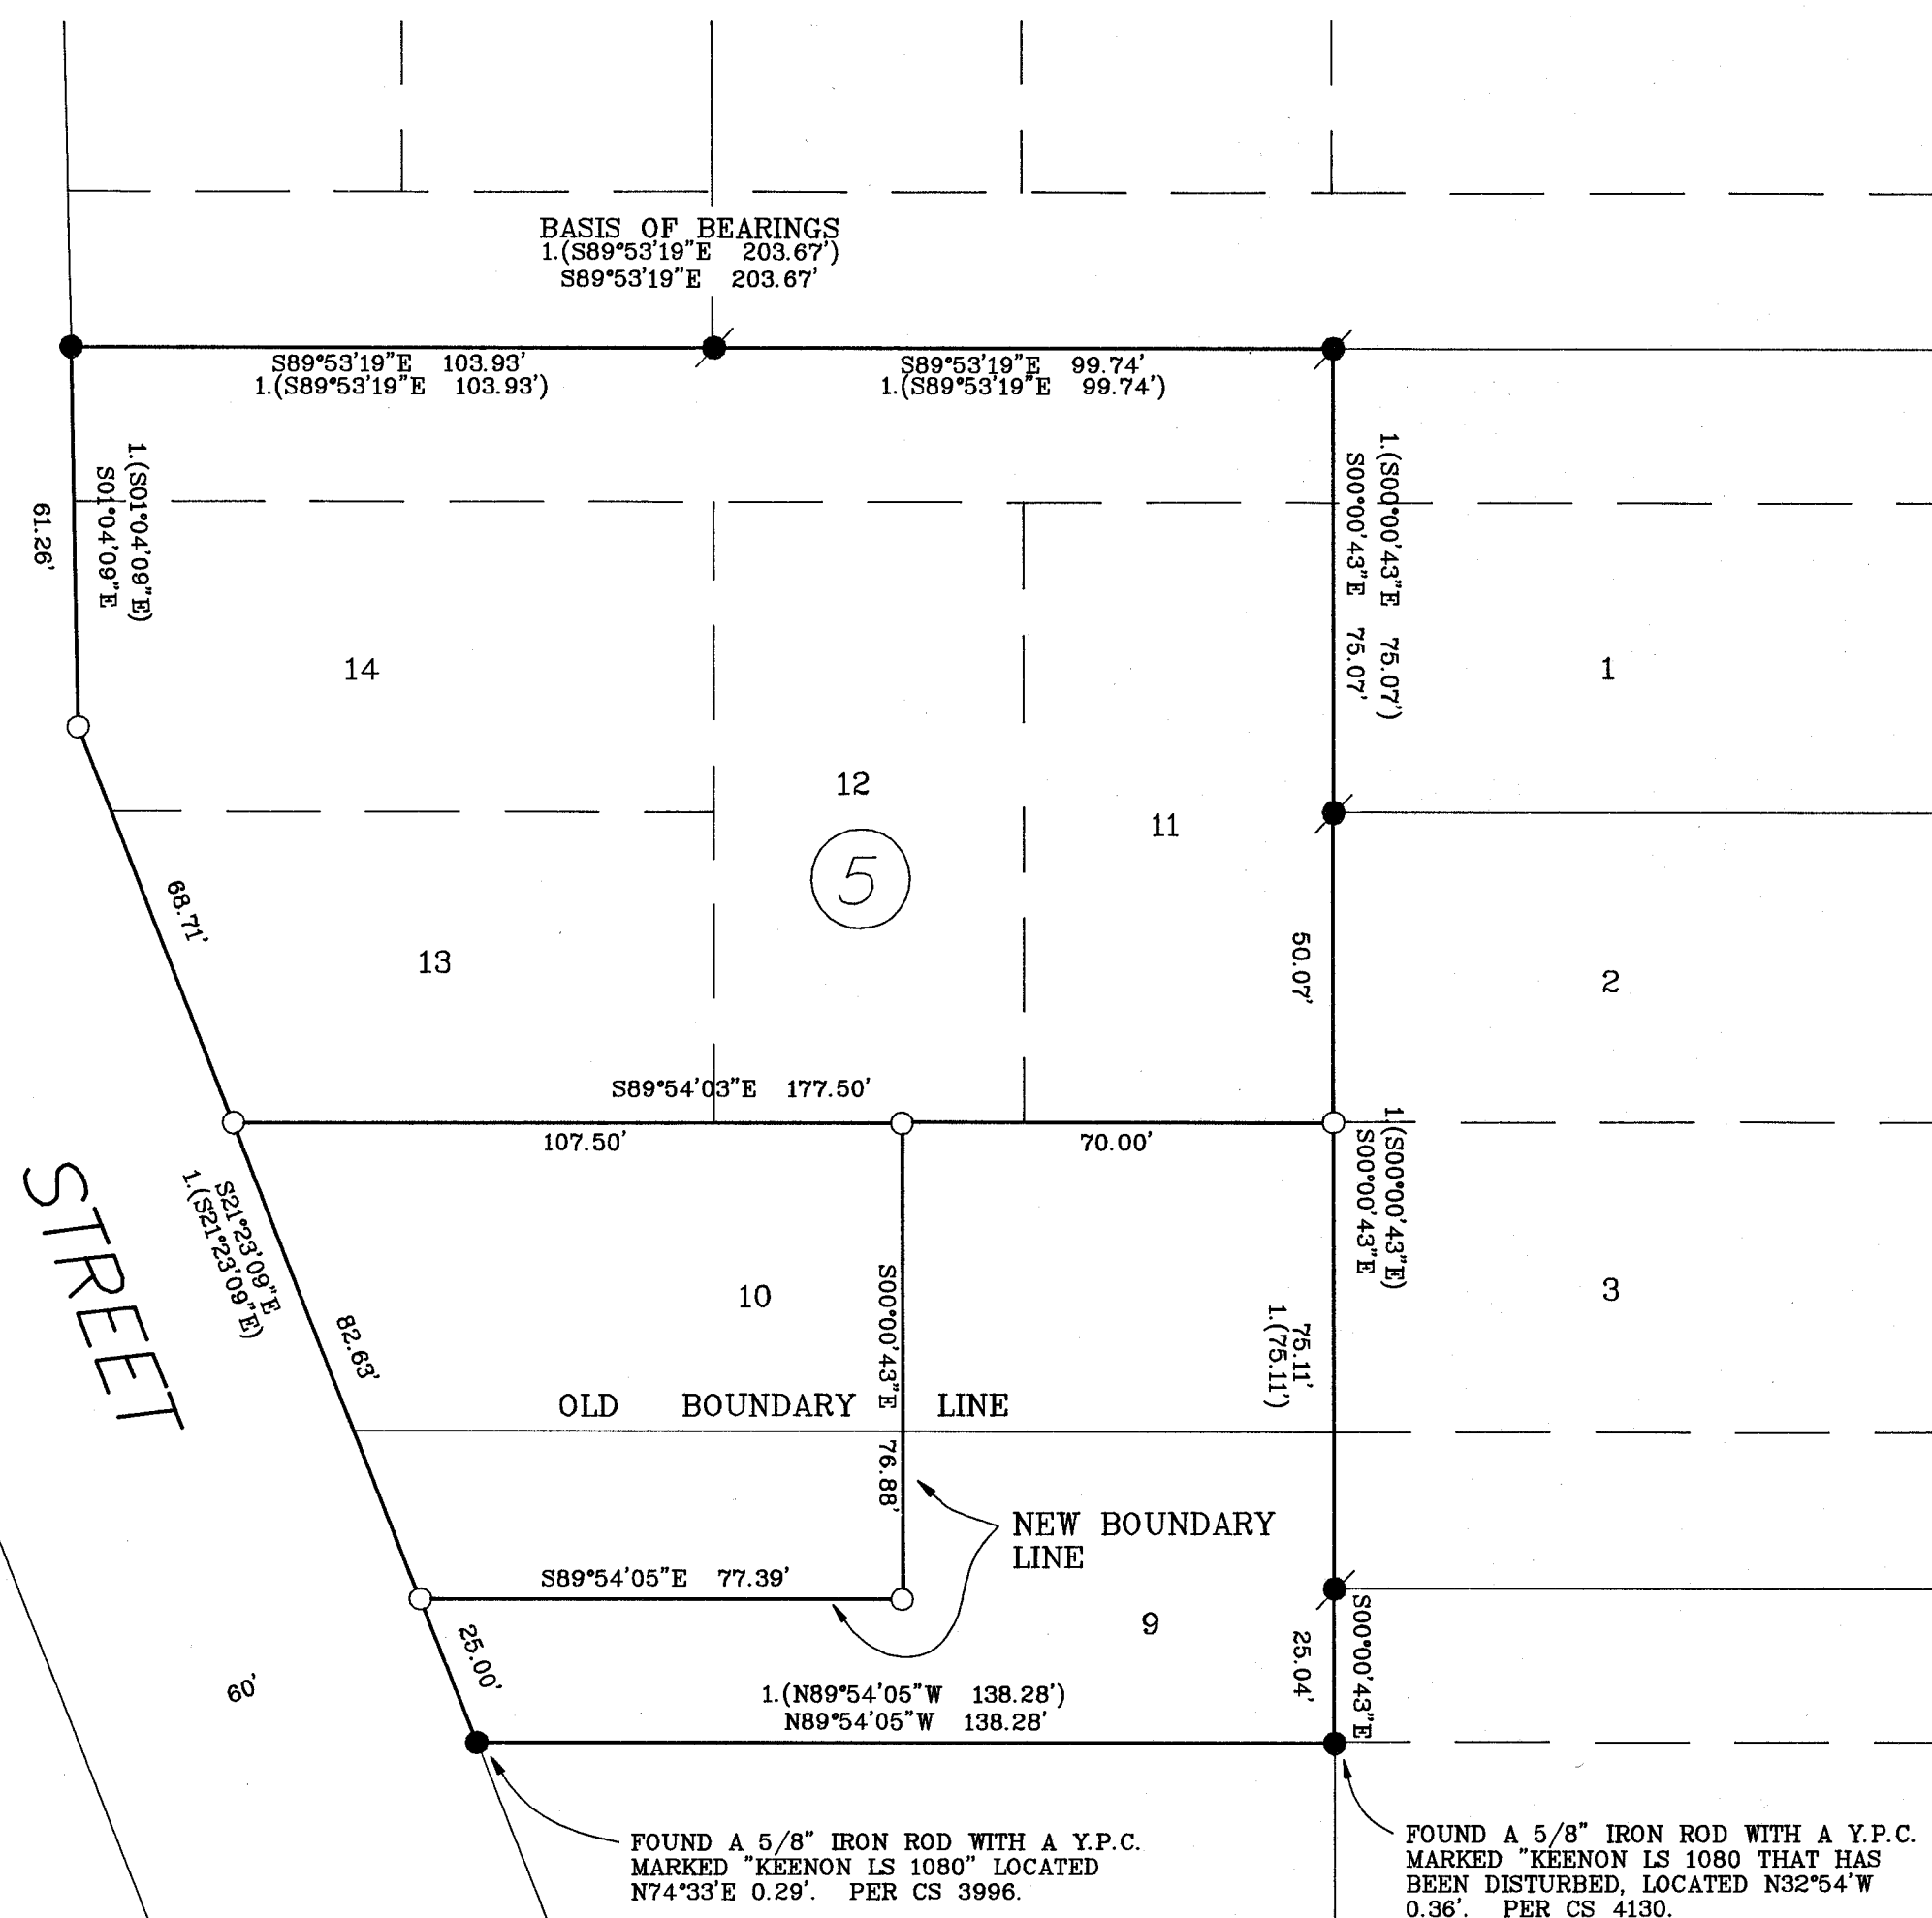

CLATSOP ST.

SIXTH STREET

NARRATIVE:

--THIS SURVEY WAS ACCOMPLISHED AT THE REQUEST OF MATTHEW MONNIN TO ADJUST THE BOUNDARY LINES AS SHOWN IN LOTS 9 AND 10, BLOCK 5, COREY ADDITION TO VERNONIA AS SHOWN.

--THE BASIS OF BEARINGS IS FROM CS 4130.

--I HELD THE FOUND MONUMENTS PER CS 4130 FOR THE CORNERS OF THE LOTS SHOWN. I PROPORTIONED THE DISTANCES BETWEEN SAID FOUND MONUMENTS TO ESTABLISH THE MONUMENTS ALONG THE EAST RIGHT-OF-WAY LINE OF BRIDGE STREET, AND AT THE SOUTHEAST CORNER OF LOT 11, BLOCK 5. I MONUMENTED THE NEW BOUNDARY LINE AT THE LOCATION REQUESTED BY THE OWNER.

LEGEND



- = FOUND A 5/8" IRON ROD WITH A Y.P.C. MARKED "KEENON LANDS SERVICES INC." PER CS 4130.
- = MONUMENT FOUND AS NOTED
- = SET A 5/8" x 30" IRON ROD WITH A Y.P.C. MARKED "KEENON LAND SERVICES INC."
- () = RECORD SURVEY DATA
- [] = RECORD DEED DATA
- CS_No = RECORD SURVEY No.
- Y.P.C. = YELLOW PLASTIC CAP
- = CONTROL POINT No.

REFERENCE SURVEYS

1 = CS No. 4130

COUNTY SURVEYOR

RECEIVED 5-22-98
 FILED 7-10-98

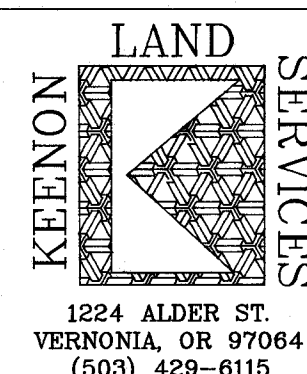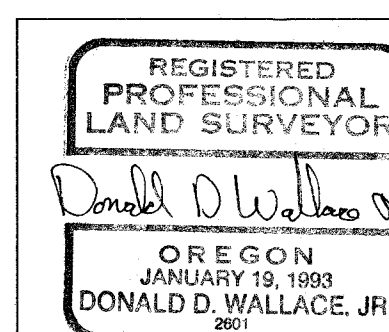

PROPERTY LINE ADJUSTMENT FOR
 MATTHEW MONNIN
 IN COREY'S ADDITION TO VERNONIA
 IN THE NE 1/4 OF S 5, T4N, R4W, W.M.
 COLUMBIA COUNTY, OREGON
 SCALE 1" = 30' APRIL 5, 1998

SURVEYORS OFFICE
 RECEIVED 5-22-98
 ACCEPTED 7-10-98
 CHECK # _____

DRAWN BY: VSS FIELD: VSS/MM EQUIPMENT: GTS300/TDS48 JOB No. MATVANCE PROJECT No. REVISED: