


CS 5694

CS 5694

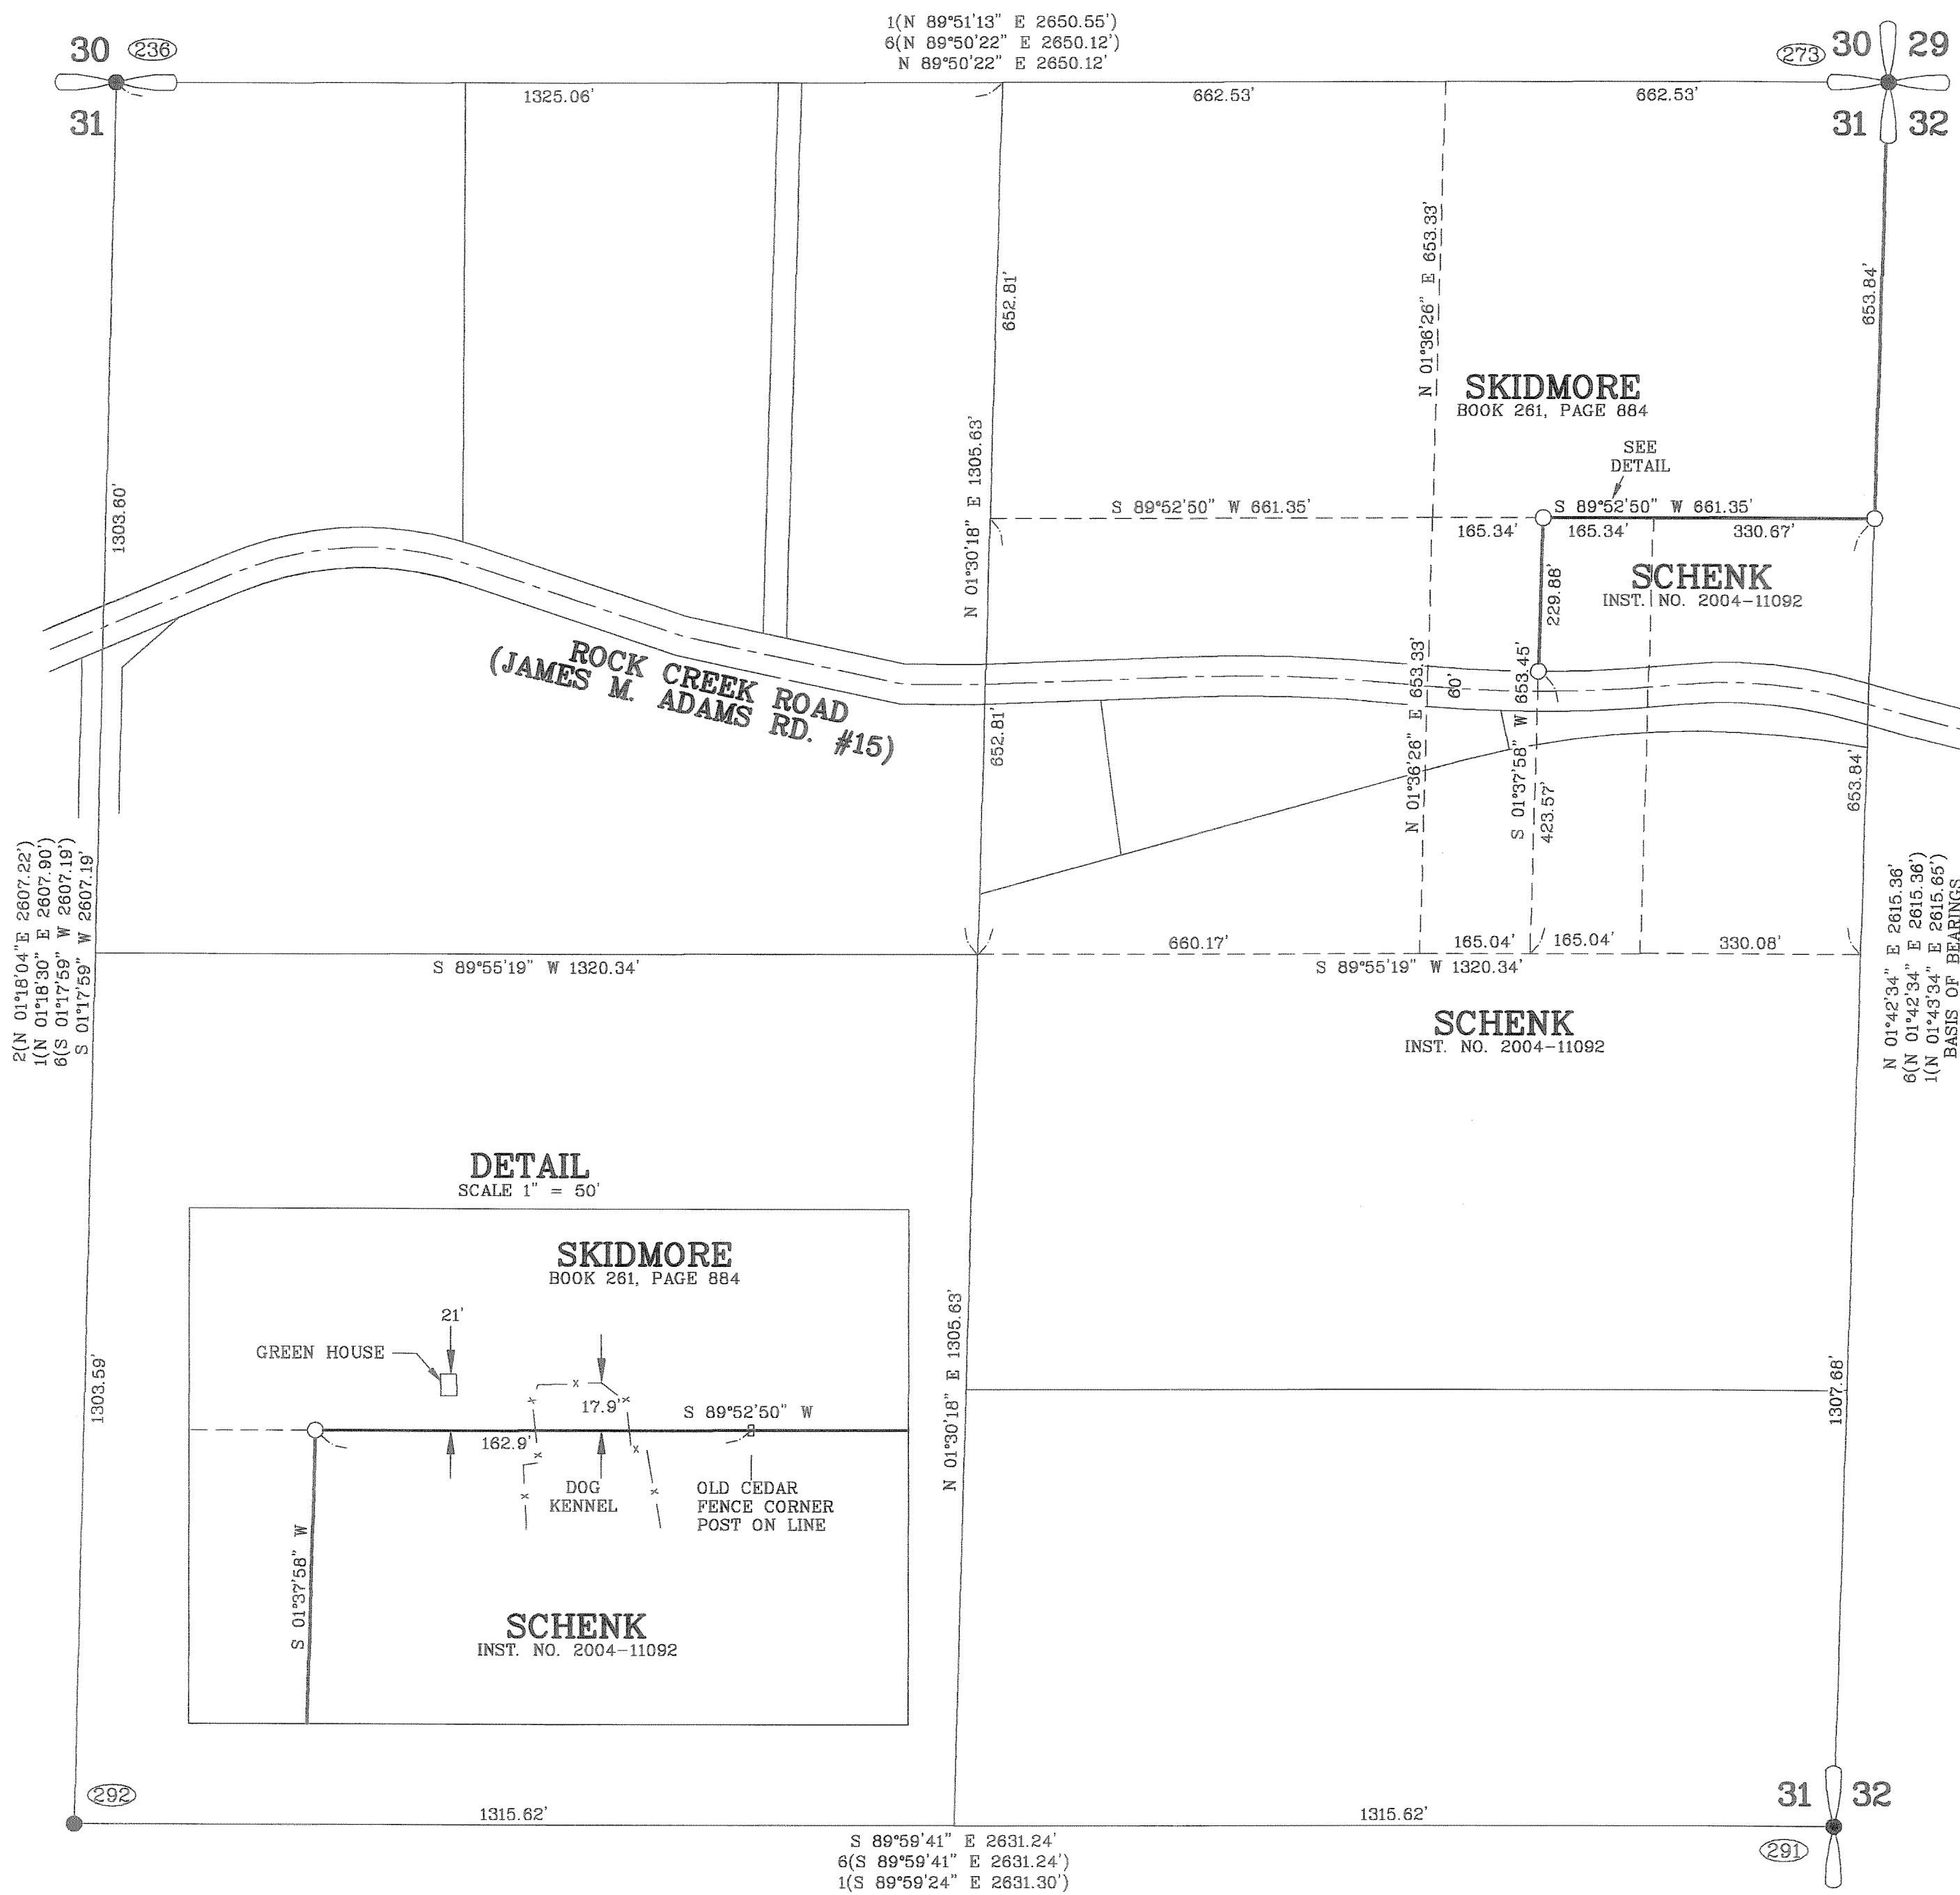

LEGEND:

- = MONUMENT FOUND AS NOTED
- = SET 5/8" X 30" IRON ROD WITH A Y.P.C. MARKED "K.L.S. SURVEYING INC"
- () = RECORD SURVEY DATA
- CS NO. = RECORD SURVEY NUMBER
- Y.P.C. = YELLOW PLASTIC CAP
- = MONUMENT POINT NUMBER (SEE MONUMENT NOTES)

REFERENCE SURVEYS:

- 1 = CS NO. 3508
- 2 = CS NO. 4350
- 3 = CS NO. 5447
- 4 = CS NO. B-243
- 5 = CS NO. L-1298
- 6 = P.P. 1997-34
- 6 = CS 5498

NARRATIVE:

--THIS SURVEY WAS ACCOMPLISHED AT THE REQUEST OF FRED SKIDMORE TO MARK AND MONUMENT A PORTION OF THAT PROPERTY DESCRIBED IN DEED BOOK 261, PAGE 884, COLUMBIA COUNTY RECORDS AS SHOWN HEREON.

--THE BASIS OF BEARINGS IS THE EAST LINE OF THE NORTHEAST QUARTER PER CS 5498 BETWEEN MONUMENT NUMBERS 291 AND 273.

--FOR CONTROL I HELD THE MONUMENTS NOTED IN THE MONUMENT NOTES AND SUBDIVIDED THE NORTHEAST QUARTER PER THE 1973 BLM MANUAL OF SURVEYING INSTRUCTIONS.

ROCK CREEK ROAD:
--FOR THE CENTERLINE I HELD THE AS-TRAVELED LOCATION AND ESTABLISHED THE RIGHT OF WAY 30' FROM THE AS-TRAVELED CENTERLINE.

MONUMENT NOTES:

- 236
N 1/4 CORNER SECTION 31
FOUND A 2" IRON PIPE WITH 3" CROWN ZELLERBACH BRASS CAP PER CS NO. 3508 (HELD)
- 273
SECTION CORNER COMMON TO SECTIONS 29, 30, 31 & 32
FOUND A 2" IRON PIPE WITH 3" CROWN ZELLERBACH BRASS CAP AS NOTED IN CS NO. 3508 (HELD)
- 291
E 1/4 CORNER SECTION 31
FOUND A 2" IRON PIPE WITH 3" CROWN ZELLERBACH BRASS CAP PER CS NO. 3508 (HELD)
- 292
C 1/4 CORNER
FOUND A 2" IRON PIPE WITH 3" CROWN ZELLERBACH BRASS CAP PER CS NO. 3508 (HELD)

REGISTERED
PROFESSIONAL
LAND SURVEYOR

DONALD D. WALLACE JR.
OREGON
JANUARY 19, 1993
DONALD D. WALLACE JR.
2601
RENEWAL DATE 6/30/10



SURVEY FOR

FRED SKIDMORE
IN THE NE 1/4 OF SECTION 31,
T5N, R4W, W.M.
COLUMBIA COUNTY, OREGON
SCALE 1" = 200' DECEMBER 8, 2009

Columbia County Surveyor
Received 12/31/09
Filed 2/10/10
CS# 5694

DRAWN BY: DDW

FIELD: BTF/SND

EQUIPMENT: HIPER-GA/2500 JOB No. 10-003

PROJECT No. 10-003

REVISED: 1/25/10

CS 5694

CS 5694