


PROPERTY LINE ADJUSTMENT
FOR GERALD AND SANDRA BRUCE
IN ROSE ADDITION TO VERNONIA AND THE TOWN
OF VERNONIA, IN THE SE 1/4 OF SEC 5,
AND THE SW 1/4 OF SEC 4, T4N, R4W, W.M.
COLUMBIA COUNTY, OREGON
SCALE 1" = 50' JUNE 28, 1994

3961

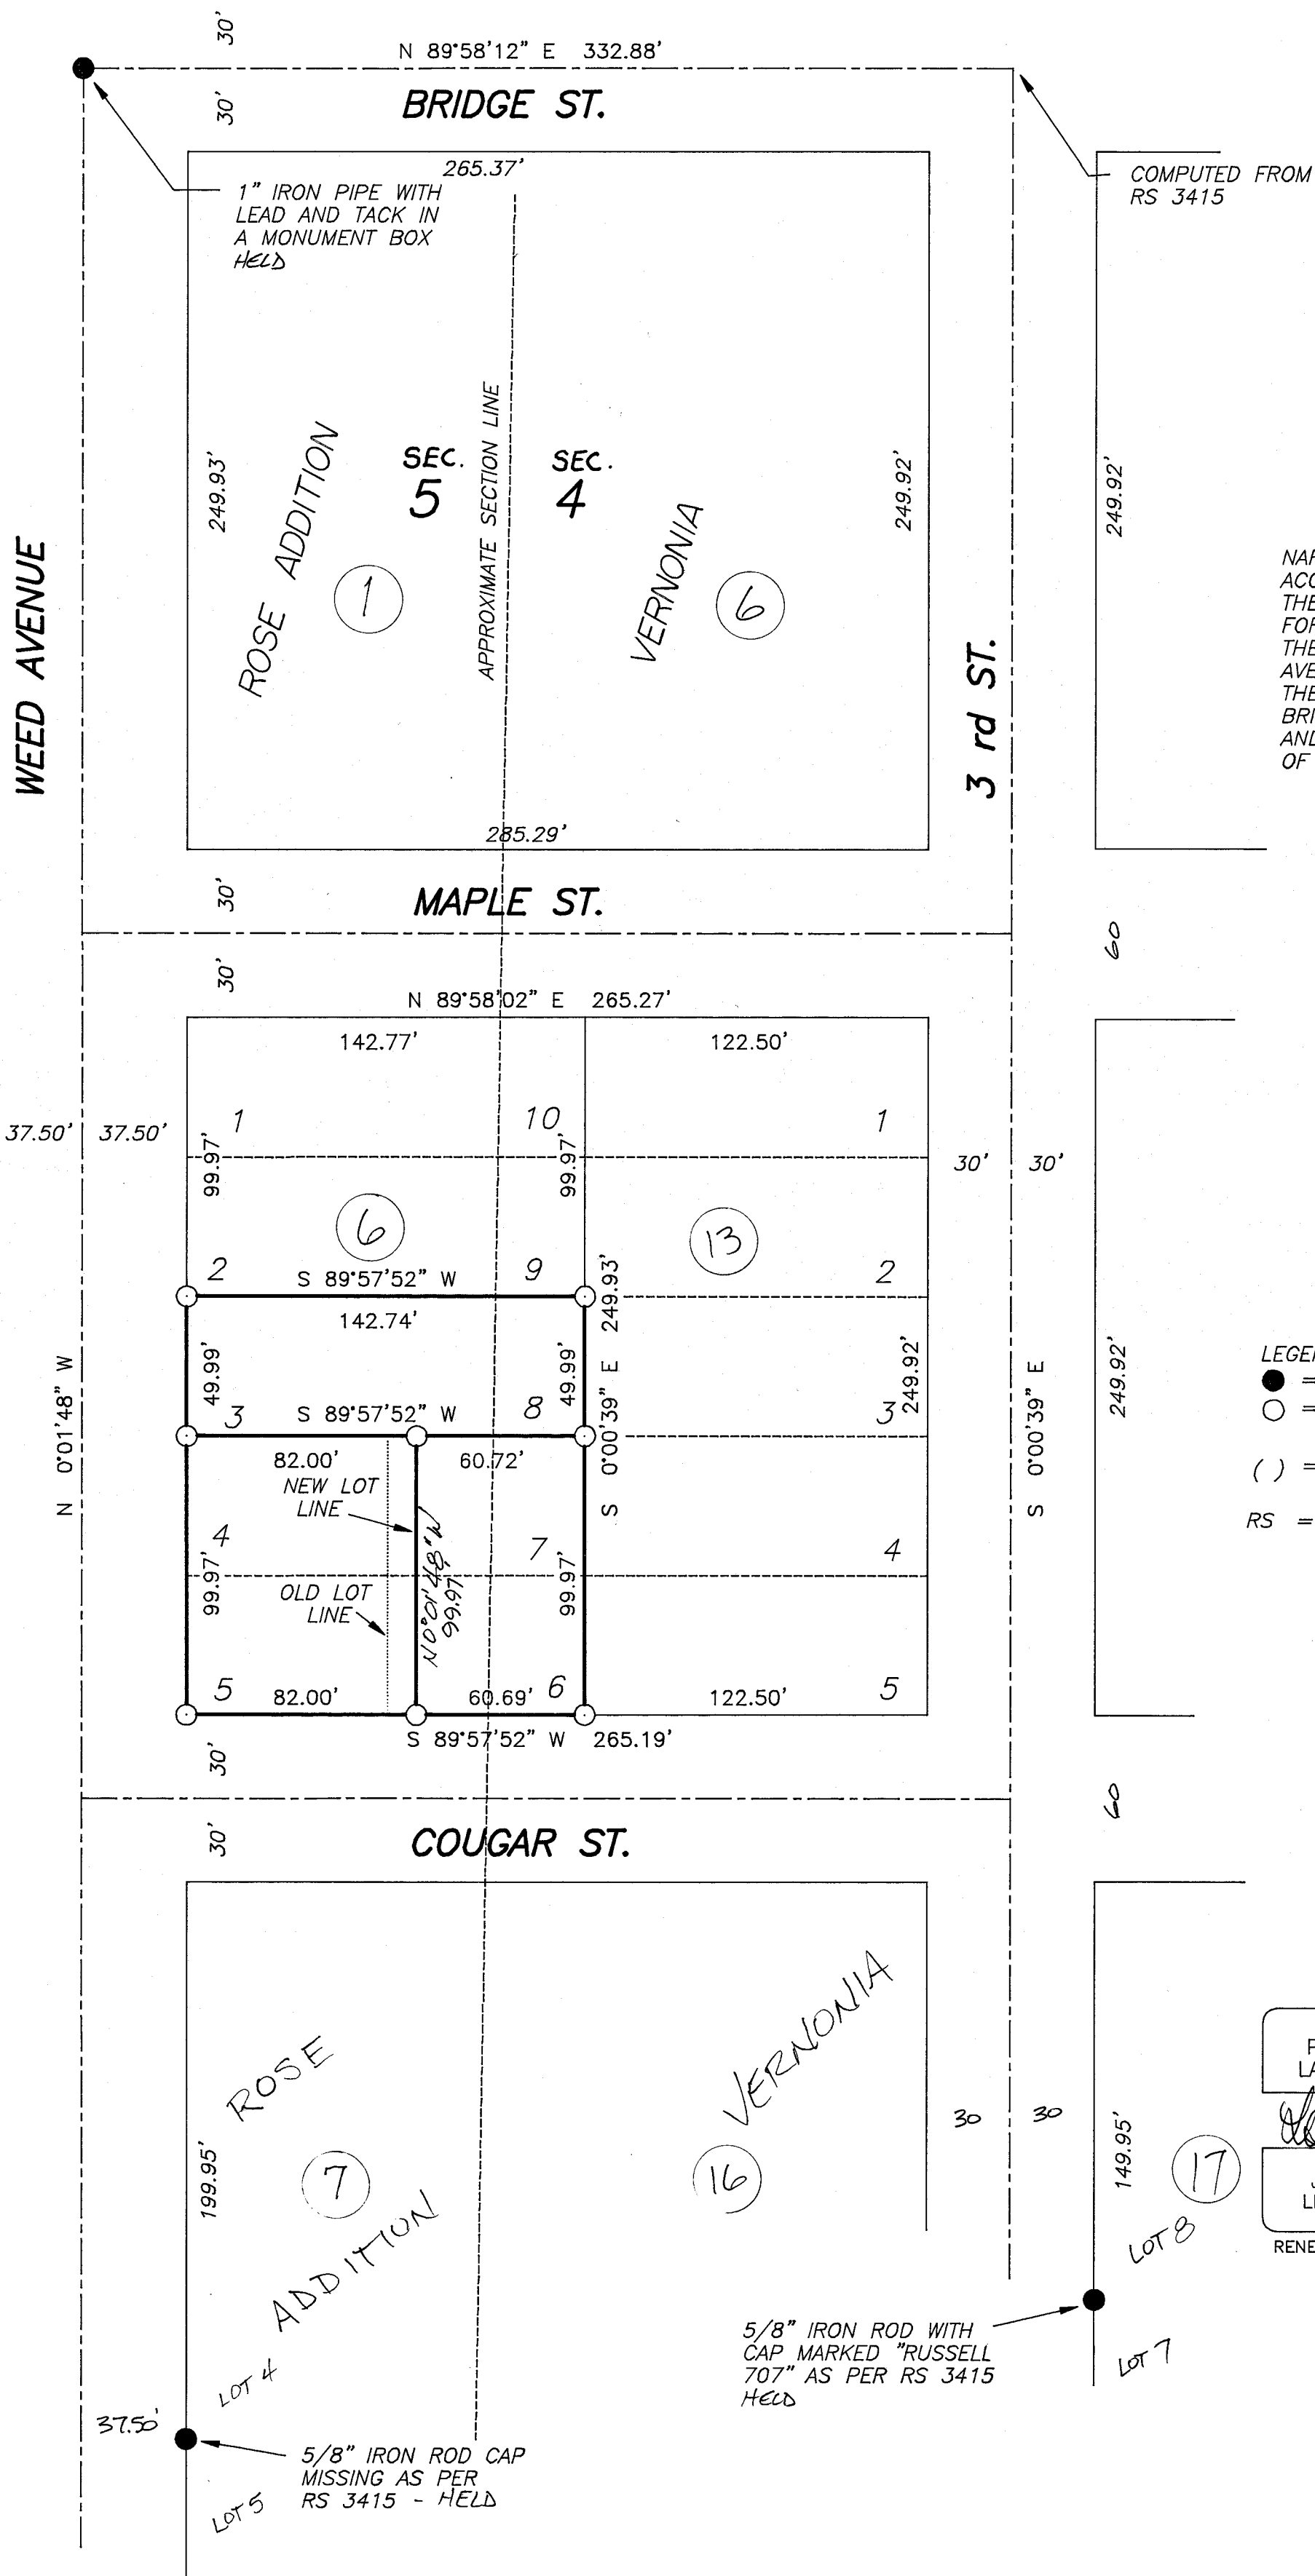

NARRATIVE: THE PURPOSE OF THIS SURVEY WAS TO ACCOMMODATE A PROPERTY LINE ADJUSTMENT AS SHOWN. THE BASIS OF BEARINGS IS WEED AVENUE FROM RS 3415. FOR CONTROL I HELD THE MONUMENTS SET IN RS 3415, AND THE CENTERLINE MONUMENT AT THE INTERSECTION OF WEED AVENUE AND BRIDGE ST. I COMPUTED THE LOCATION OF THE CENTERLINE MONUMENT AT THE INTERSECTION OF BRIDGE ST. AND 3rd ST. BY HOLDING THE RECORD BEARING AND DISTANCE FROM THE MONUMENT AT THE INTERSECTION OF BRIDGE ST. AND WEED AVENUE FROM RS 3415.

LEGEND
● = MONUMENT FOUND AS NOTED
○ = SET A 5/8" X 30" IRON ROD WITH A YELLOW PLASTIC CAP MARKED "KEENON LS 1080"
() = RECORD DATA 1 = RS
2 = RS
RS = RECORD SURVEY NO.

REGISTERED
PROFESSIONAL
LAND SURVEYOR
Leslie G. Keenon
OREGON
JULY 30, 1976
LESLIE G. KEENON
1080
RENEWAL DATE 6/30/95

LAND
SERVICES
KEENON
1224 ALDER ST.
VERNONIA, OR
97064
(503) 429-6115

COLUMBIA COUNTY SURVEYORS OFFICE
RECEIVED 7-19-94
ACCEPTED FOR FILING 9-20-94

3961