


Narrative: This survey has been perpetuated from found Monuments & Record Surveys Nos. 1025, 2555, 2162, & 540 Recorded in Columbia Co. Surveyors office. Equipment used was a 1min Theodolite & Mac I EMD. Section 13 Subdivided by C.R. Wagner Jan. 1958.

*R.D. Montgomery* 1831

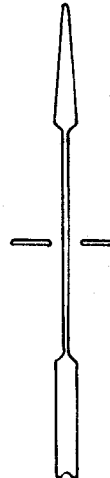

**COLUMBIA COUNTY SURVEYOR**

DATE RECEIVED 9-2-81

DATE FILED 9-2-81

BY [Signature]

<p>REGISTERED PROFESSIONAL LAND SURVEYOR</p> <p><i>Richard W. Montgomery</i></p> <p>OREGON JULY 13, 1979</p> <p>RICHARD W. MONTGOMERY 1831</p>	PREPARED FOR, AND AT THE REQUEST OF		NO.	L-81-6-34
	Dan Bunn		SCALE	1" = 200'
	LOCATION:		DATE	July 10, 1981
	SE 1/4 SE 1/4 sec. 13 T. 4 N. R. 5 W. W.M. SW 1/4 SW 1/4 SEC. 18 T. 4 N. R. 4 W. W.M.,		<input checked="" type="checkbox"/> MON. FOUND <input type="checkbox"/> 1/2"x24" IRON ROD SET ( ) DENOTES RECORD DIST & BEARING	
Columbia COUNTY, OREGON		<p><b>LAND MARKERS, INC.</b></p> <p>5778 COMMERCIAL ST. S.E. • SALEM, OR 97302 • PHONE 378-7721</p> <p>DICK MONTGOMERY LAND SURVEYOR NATE HUMMEL</p>		