
A

PARTITION PLAT No. 2001-25 A PARTITION OF PARCEL 2 OF PARTITION PLAT 1997-56 IN THE CITY OF VERNONIA
IN THE NW 1/4 OF SEC 3, T4N, R4W, W.M.
COLUMBIA COUNTY, OREGON
SCALE 1" = 30' AUGUST 22, 2001

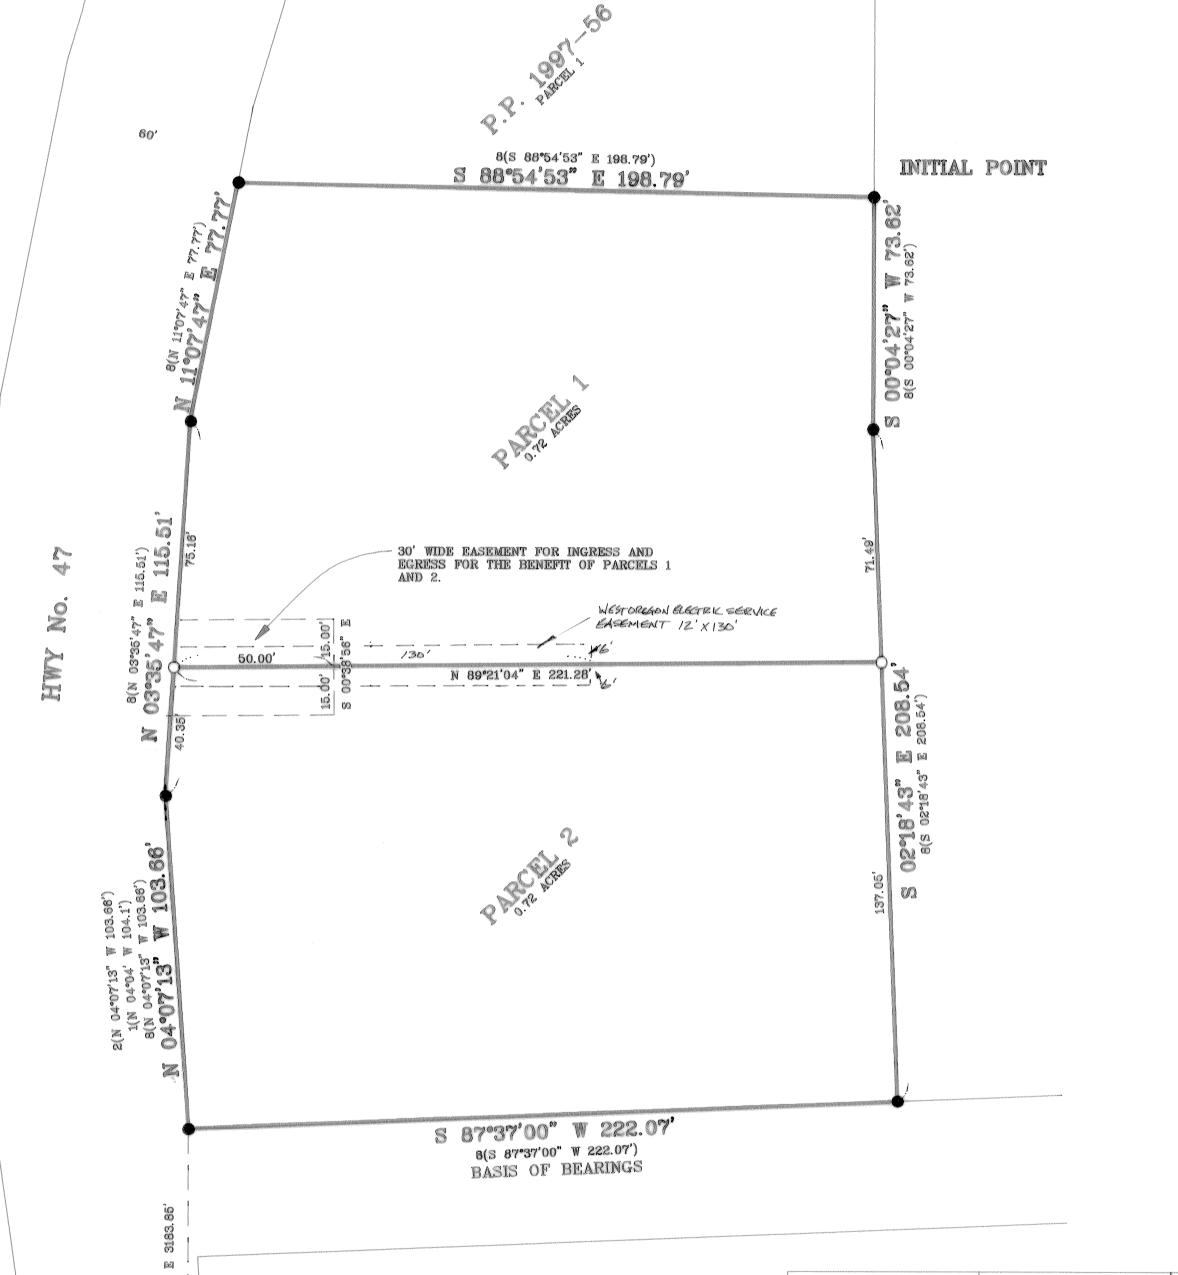

COLUMBIA COUNTY G.P.S. CONTROL VERNONIA

A 2" BRASS CAP MARKED "COLUMBIA COUNTY

CONTROL, COL 02, LS 2210"

LEGEND

- FOUND A 5/8" x 30" IRON ROD WITH A Y.P.C. MARKED "KEENON LAND SERVICES INC." EXCEPT AS NOTED.
- SET A 5/8" x 30" IRON ROD WITH A Y.P.C. MARKED "KEENON LAND SERVICES INC."
- () = RECORD SURVEY DATA
- CS = RECORD SURVEY No.
- Y.P.C. = YELLOW PLASTIC CAP

REFERENCE SURVEYS

- 1 = CS No. 224 2 = CS No. 4347 3 = CS No. B-202 4 = CS No. 3972 5 = CS No. 4018 6 = CS No. 3025
- 7 = CS No. 4212
- 8 = PARTITION PLAT 1997-56

REFERENCE DEEDS

- 1 = CLERKS INST. # 88-3179 2 = CLERKS INST. # 95-10154 3 = BOOK 56, PAGE 54

LAND 1224 ALDER ST.

FIELD: DDW/MWM

OREGON JULY 30, 1976 LESLIE G. KEENON VERNONIA, OR 97064 (503) 429-6115 RENEWAL DATE 6/30/99

REGISTERED

PROFESSIONAL LAND SURVEYOR

1080

DRAWN BY: DDW

EQUIPMENT: GTS300/TDS48 JOB No. 01-074

PROJECT No. 95-161

REVISED: 11/11/97

SHEET 1 OF 2

COLUMBIA COUNTY SURVEYORS OFFICE

RECEIVED ACCEPTED_

PARTITION PLAT No. 20(-25

A PARTITION OF PARCEL 2 OF
PARTITION PLAT 1997-56
IN THE CITY OF VERNONIA
IN THE NW 1/4 OF SEC 3, T4N, R4W, W.M.
COLUMBIA COUNTY, OREGON
AUGUST 22, 2001

SURVEYORS CERTIFICATE:

I, LESLIE G. KEENON, DO HEREBY CERTIFY THAT I HAVE CORRECTLY SURVEYED AND MARKED WITH PROPER MONUMENTS, THE LAND REPRESENTED ON THE ANNEXED PARTITION MAP, THE BOUNDARIES BEING DESCRIBED AS FOLLOWS:

PARCEL 2 OF PARTITION PLAT 1997-56.

DECLARATION:

KNOW ALL PEOPLE BY THESE PRESENTS THAT WE, RALPH D. LOHR, BRIAN LARDBUNG BASSETT, AND DONALD L. MANUEL ARE THE OWNERS OF THE LAND REPRESENTED ON THE ANNEXED PLAT, AND MORE PARTICULARLY DESCRIBED IN THE ACCOMPANYING SURVEYORS CERTIFICATE, AND HAVE CAUSED THE SAME TO BE SURVEYED AND PARTITIONED INTO PARCELS 1 AND 2 IN ACCORDANCE WITH O.R.S. CHAPTER 92, AS SHOWN ON THE ANNEXED PARTITION PLAT. WE HEREBY DESCRIPTION FOR THE CASSIMENT AS SHOWN.

BRINN L. BASSETT

Polyn L BASSETT

ACKNOWLEDGEMENT:

STATE OF OREGON

COUNTY OF COLUMBIA

KNOW ALL PEOPLE BY THESE PRESENTS, THAT ON THIS 24 DAY
OF LIZAMON 2001 BEFORE ME, A NOTARY PUBLIC FOR OREGON,
PERSONALLY APPEARED RALPH LOHP, DONALD L. MANUEL,
BRIAN L. BASSETT, AND ROBYN L. BASSETT WHO DID SAY THAT

PERSONALLY APPEARED RALPH LOHR, DONALD L. MANUEL, BRIAN L. BASSETT, AND ROBYN L. BASSETT WHO DID SAY THAT THEY ARE THE IDENTICAL PERSONS NAMED IN THE FOREGOING INSTRUMENT AND THAT THEY DID EXECUTE SAID INSTRUMENT OF THEIR OWN FREE AND VOLUNTARY ACT.

Notary Public for Oregon My commission expires, 02-09-02



NOTES:

1. THIS PARTITION IS SUBJECT TO AN EASEMENT RECORDED IN INSTRUMENT #01-05952 IN FAVOR OF WEST OREGON ELECTRIC COOPERATIVE INC. FOR THE CONSTRUCTION AND MAINTAINANCE OF POWER LINES, AS REPLACED BY DOCUMENT # 21- ///48
2. THIS PARTITION IS SUBJECT TO AN EASEMENT RECORDED IN INSTRUMENT #01-05953 IN FAVOR OF WEST OREGON ELECTRIC COOPERATIVE INC. FOR THE CONSTRUCTION AND MAINTAINANCE OF POWER LINES, AS REPLACED BY DOCUMENT # 01- ///49

NARRATIVE:

--THIS SURVEY WAS ACCOMPLISHED AT THE REQUEST OF RALPH LOHR AND BERYL LOHR FOR THE PURPOSE OF PARTITIONING PARCEL 2 OF PARTITION PLAT 1997-56 INTO PARCELS 1 AND 2 AS SHOWN ON THE ANNEXED PLAT.

--THE BASIS OF BEARINGS IS FROM PARTITION PLAT 1997-56. BETWEEN THE MONUMENTS ON THE SOUTH LINE OF PARCEL 2. PROCEDURE:

--I HELD THE RECORD INFORMATION PER PARTITION PLAT 1997-56 AND MY CONTROL NETWORK CREATED THEREIN.

APPROVALS:

APPROVED THIS 24 DAY OF September, 2001

CONTROL OF VICENONIA PLANNING DEPARTMENT

APPROVED THIS 10 BAY OF 2 close , 2001

COLUMBIA COUNTY SURVEYOR

STATE OF OREGON

COUNTY OF COLUMBIA

I DO HEREBY CERTIFY THAT THE ATTACHED PARTITION PLAT WAS RECEIVED FOR RECORD ON THIS OF DAY OF 2001 AT 2.32 O'CLOCK VM., AND RECORDED AS INSTRUMENT NO 01-1/358, AND PARTITION PLAT NO. 2.001-25, COLUMBIA COUNTY RECORDS.

Meque The Carray Superty Set Calledon Columbia county director of assessment and taxation



REGISTERED PROFESSIONAL LAND SURVEYOR OREGON JULY 30, 1976	KEENON
LEGLIE G. NEEHON	1224
ADE LADI	MEEN N

1080 RENEWAL DATE 6/30/03

DRAWN BY: DDW

LAND

V
F
R
C
F
R
C
F
R

1224 ALDER ST. VERNONIA, OR 97064 (503) 429-6115 FIELD: DDW/MWM

EQUIPMENT: GTS300/TDS48 JOB No. 01-074

SHEET 2 OF 2

COLUMBIA COUNTY SURVEYORS OFFICE RECEIVED

ACCEPTED____CHECK #___

PROJECT No. 95-160 REVISED: 11/11/97