


9857

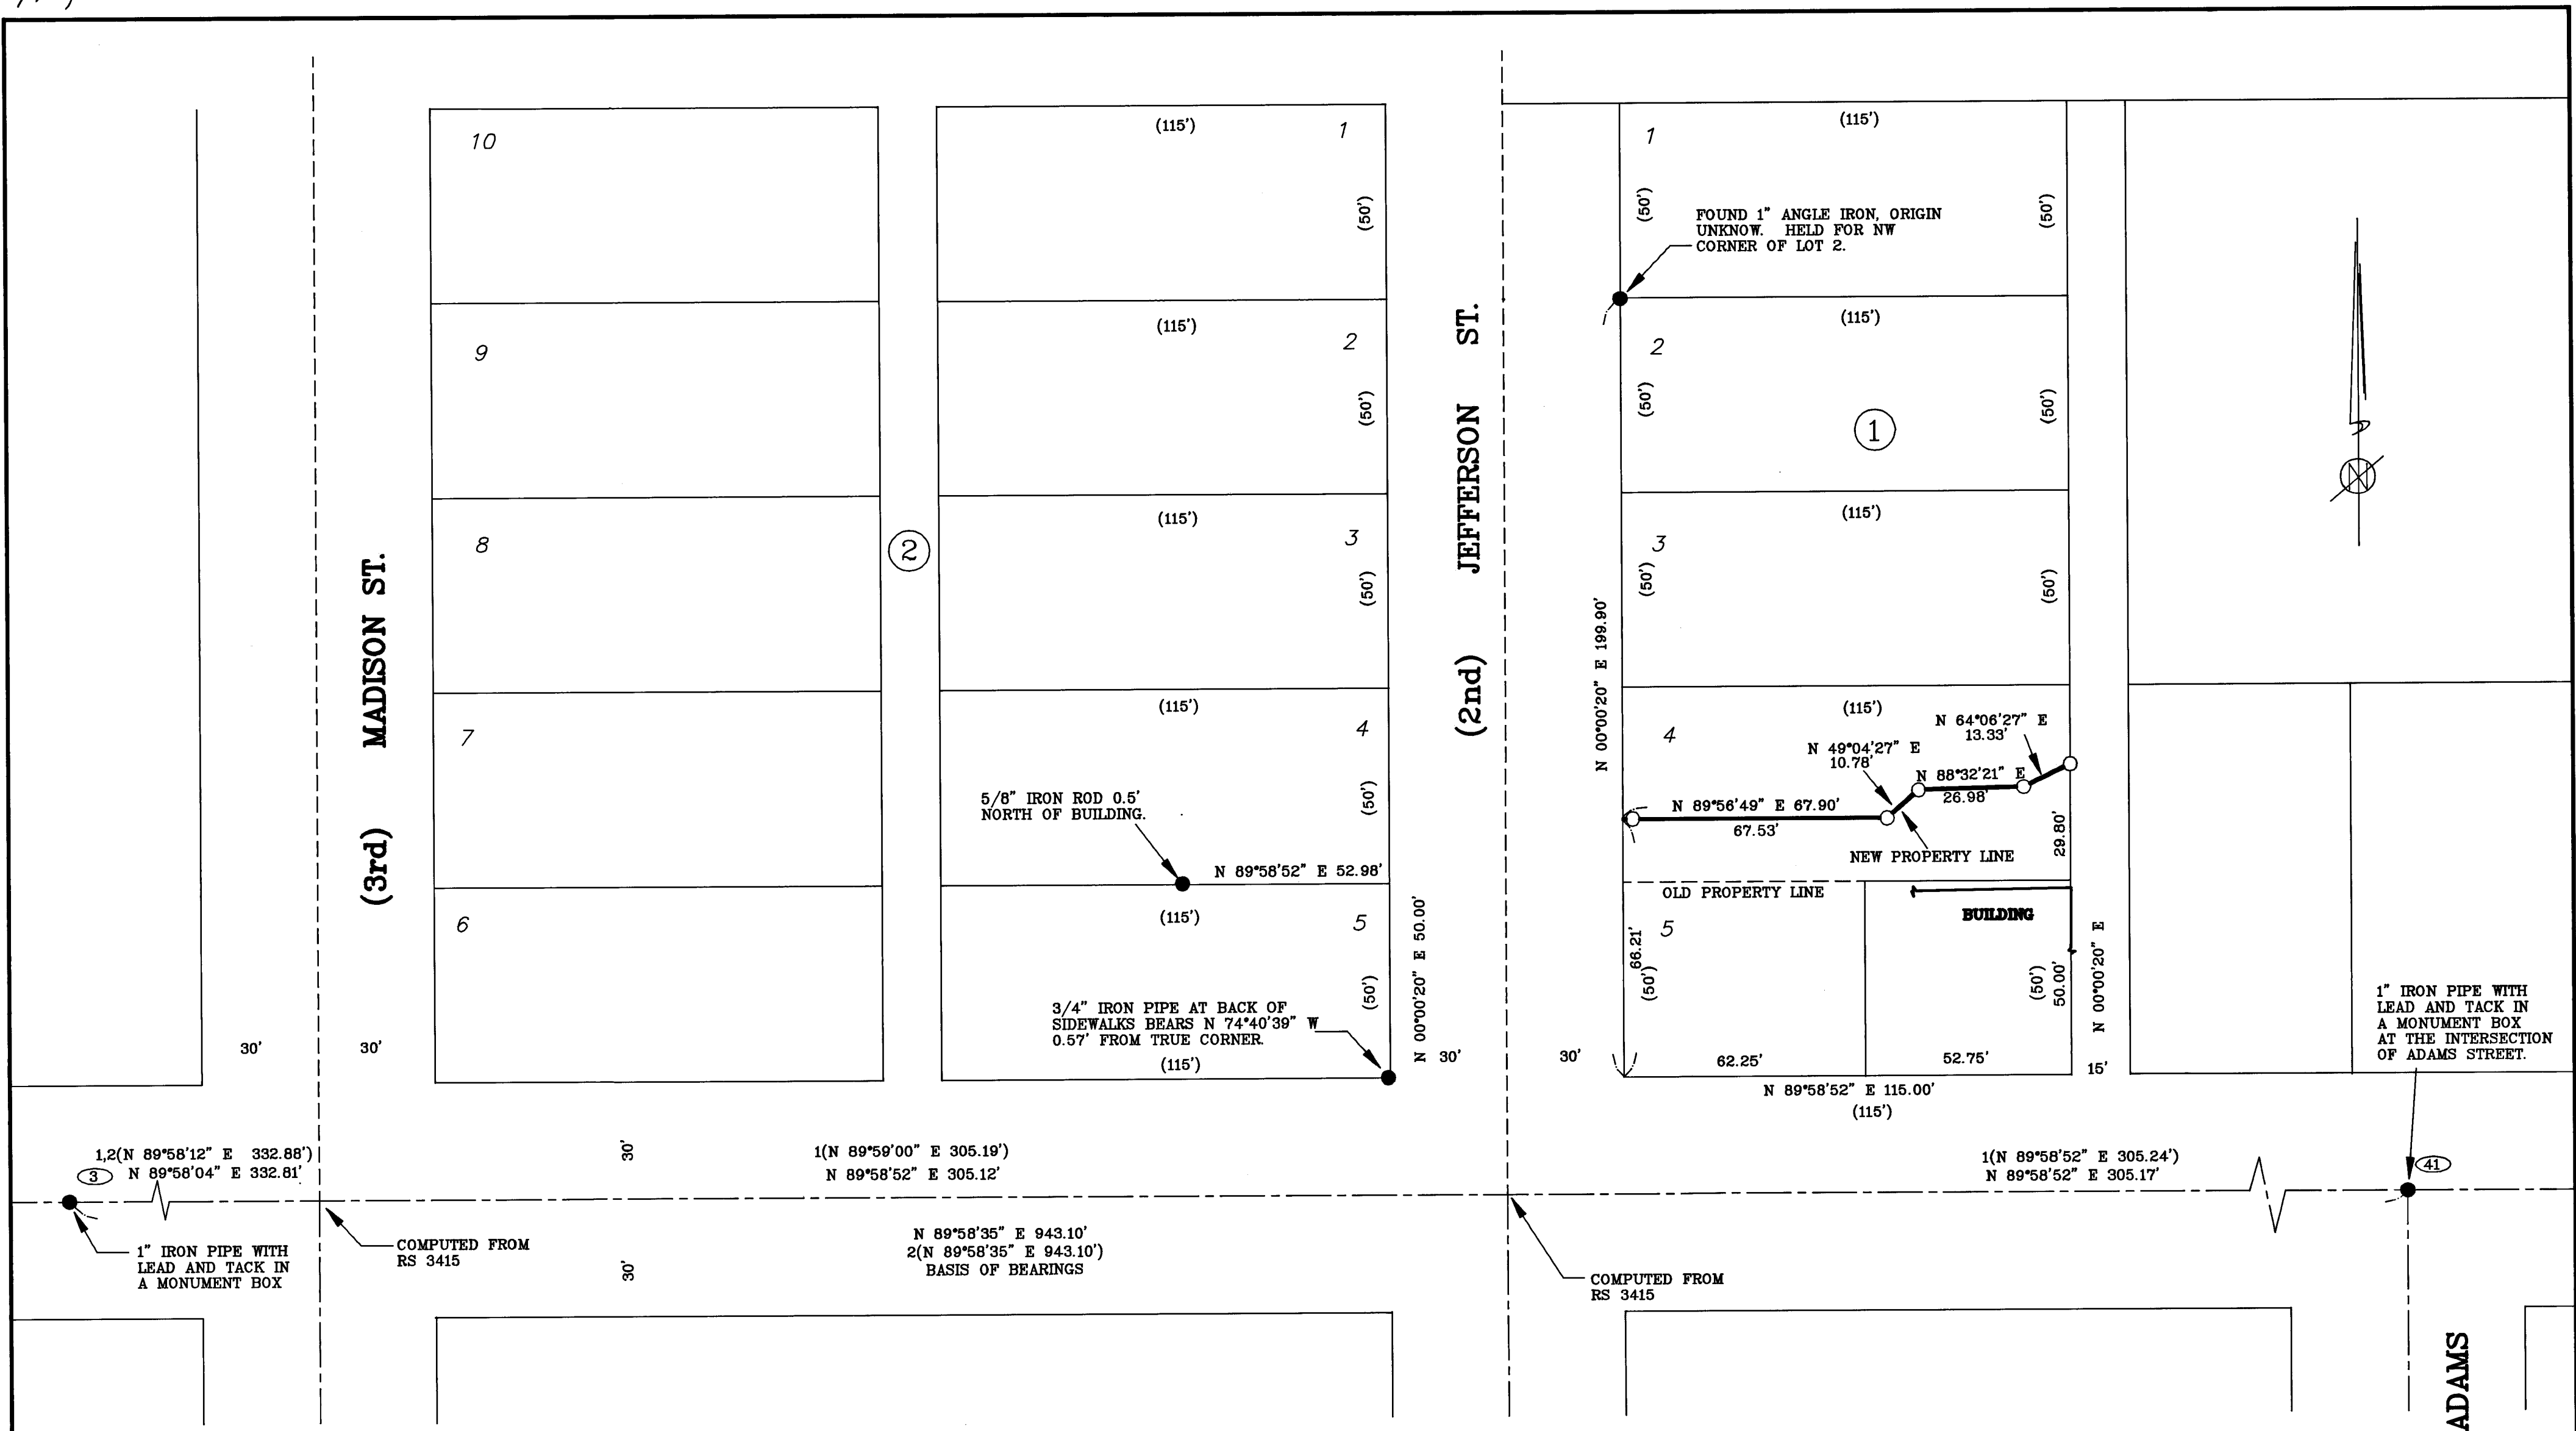

NARRATIVE:

---THIS SURVEY WAS ACCOMPLISHED AT THE REQUEST OF RAY FOSTER TO MONUMENT AND DESCRIBE A PROPERTY LINE ADJUSTMENT IN BLOCK 1, VERNONIA.

--- THE BASIS OF BEARINGS IS FROM CS No 3967 BETWEEN CONTROL MONUMENTS No. 3 AND 41.

---FOR CONTROL I HELD THE MONUMENTS AT THE INTERSECTION OF BRIDGE ST. AND WEED AVE, BRIDGE ST. AND ADAMS ST. PER CS No. 129. I COMPUTED THE LOCATIONS OF THE MONUMENTS ON BRIDGE ST. AT THE INTERSECTIONS WITH MADISON ST. AND JEFFERSON ST. PER CS No 3415 AS THEY HAVE BEEN PAVED OVER. I HELD THE ANGLE IRON AT THE NORTHWEST CORNER OF LOT 2, BLOCK 1, ORIGIN UNKNOWN FOR THE WEST LINE OF BLOCK 1 AND COMPUTED THE EAST LINE AT THE PLATTED DISTANCE FROM SAID WEST LINE. THE NEW LINE WAS ESTABLISHED ALONG THE TOP OF AN EXISTING RETAINING WALL.

LEGEND

- = MONUMENT FOUND AS NOTED
- = SET A 5/8" x 30" IRON ROD WITH A Y.P.C. MARKED "KEENON LAND SERVICES INC."
- () = RECORD SURVEY DATA
- [] = RECORD DEED DATA
- CS No. = RECORD SURVEY No.
- Y.P.C. = YELLOW PLASTIC CAP
- = CONTROL POINT No.

REFERENCE SURVEYS

- 1 = CS No. 3415
 - 2 = CS No. 3967
- TOWN OF VERNONIA

<p>REGISTERED PROFESSIONAL LAND SURVEYOR</p> <p><i>Leslie G. Keenon</i></p> <p>OREGON JULY 30, 1976 LESLIE G. KEENON 1080 RENEWAL DATE 6/30/99</p>	<p>KEENON LAND SERVICES</p> <p>1224 ALDER ST. VERNONIA, OR 97064 (503) 429-6115</p>	<p>PROPERTY LINE ADJUSTMENT FOR RAY FOSTER IN BLOCK 2, VERNONIA IN THE NW 1/4 OF SECTION 4, T4N, R4W, W.M. COLUMBIA COUNTY, OREGON SCALE 1" = 30' JUNE 15, 1998</p>	<p>COLUMBIA COUNTY SURVEYORS OFFICE RECEIVED <u>8-17-98</u> ACCEPTED <u>10-28-98</u> CHECK # _____</p>		
DRAWN BY: DDW	FIELD: DDWSS	EQUIPMENT: GTS300/TDS48	JOB No. 98-092	PROJECT No. 97-005	REVISED: 6/15/98

4526