


B-202

RECORD OF SURVEY  
FOR LINN BUCKNER  
IN THE NW 1/4 OF SEC. 3, T4N, R4W, WM.  
COLUMBIA COUNTY, OREGON  
SCALE 1"=100' APRIL 16, 1993

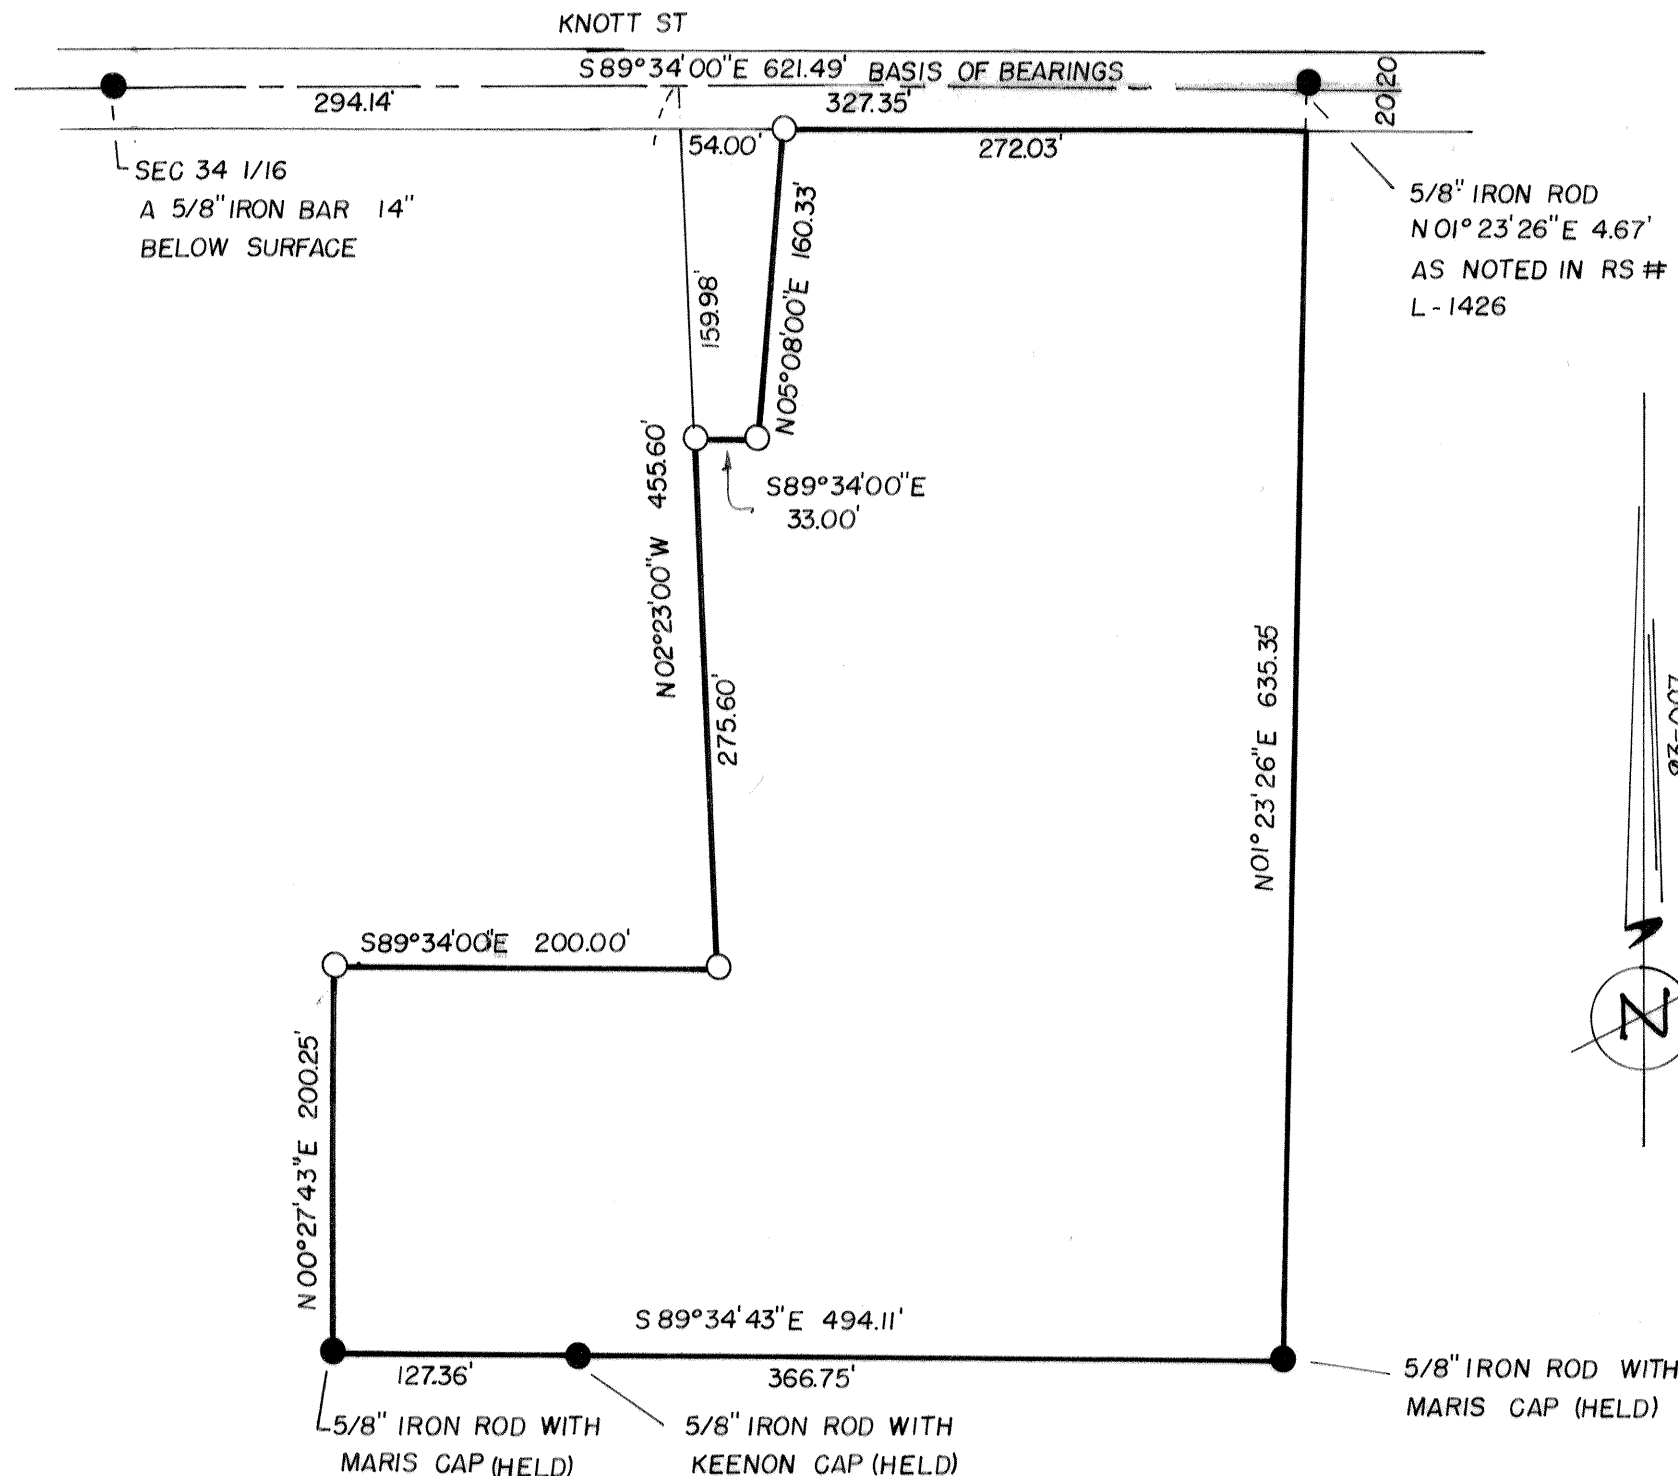

NARRATIVE: THIS SURVEY WAS ACCOMPLISHED AT THE REQUEST OF LINN BUCKNER TO MONUMENT THE PARCELS AS DESCRIBED IN DEED BOOK 186, PAGE 885, AND DOC. 91-2540, COLUMBIA COUNTY DEED RECORDS. THE BASIS OF BEARINGS IS THE NORTH LINE OF THE SECTION 3 FROM RS No. 224.

COUNTY SURVEYOR  
RECEIVED 6-7-93  
FILED 6-28-93

LEGEND

- - MONUMENT FOUND AS NOTED
- - SET A 5/8" X 30" IRON ROD WITH A YELLOW PLASTIC CAP MARKED "KEENON LS1080"
- RS - RECORD SURVEY No.

L JERRY KEENON  
1311 ALDER ST  
VERNONIA, OREGON 97064  
PH # 429-6115

REGISTERED  
PROFESSIONAL  
LAND SURVEYOR

*Leslie G. Keenon*

OREGON  
JULY 30, 1976  
LESLIE G. KEENON  
1080

EXP 12/31/93

B-202