



1 OF 2  
CS 5990

CS 5990  
1 OF 2

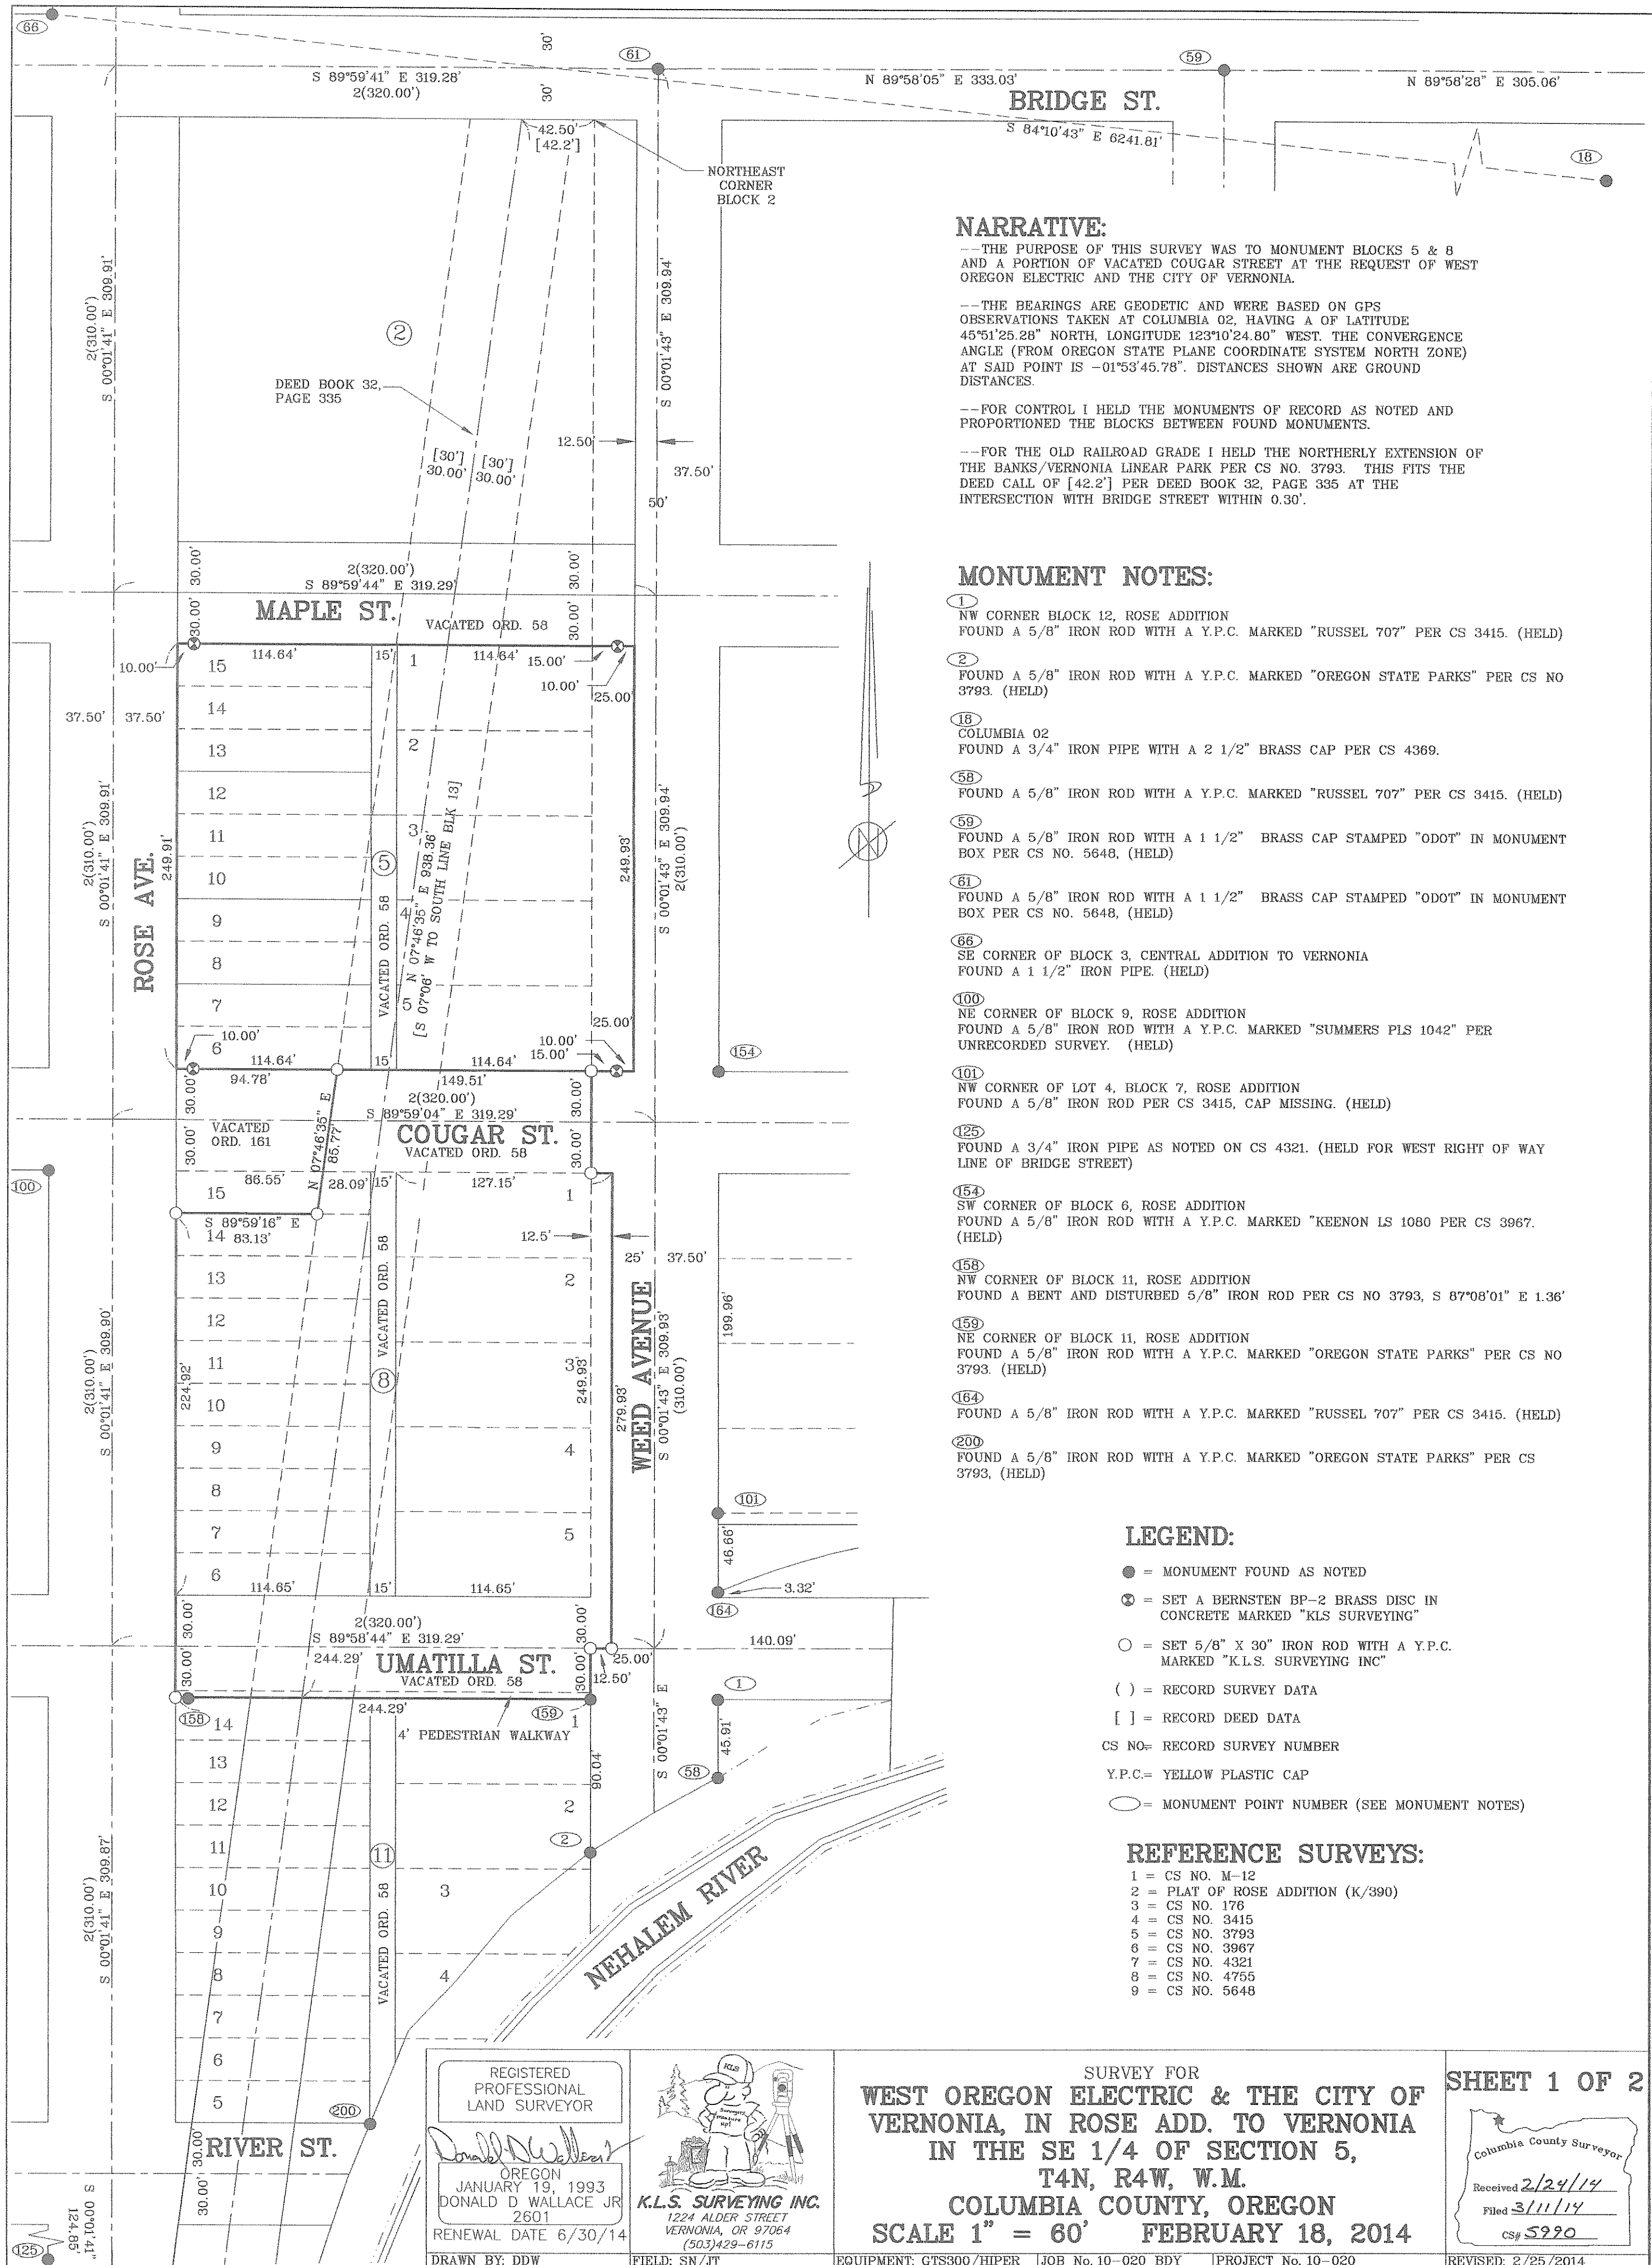

CS 5990  
1 OF 2

CS 5990  
1 OF 2

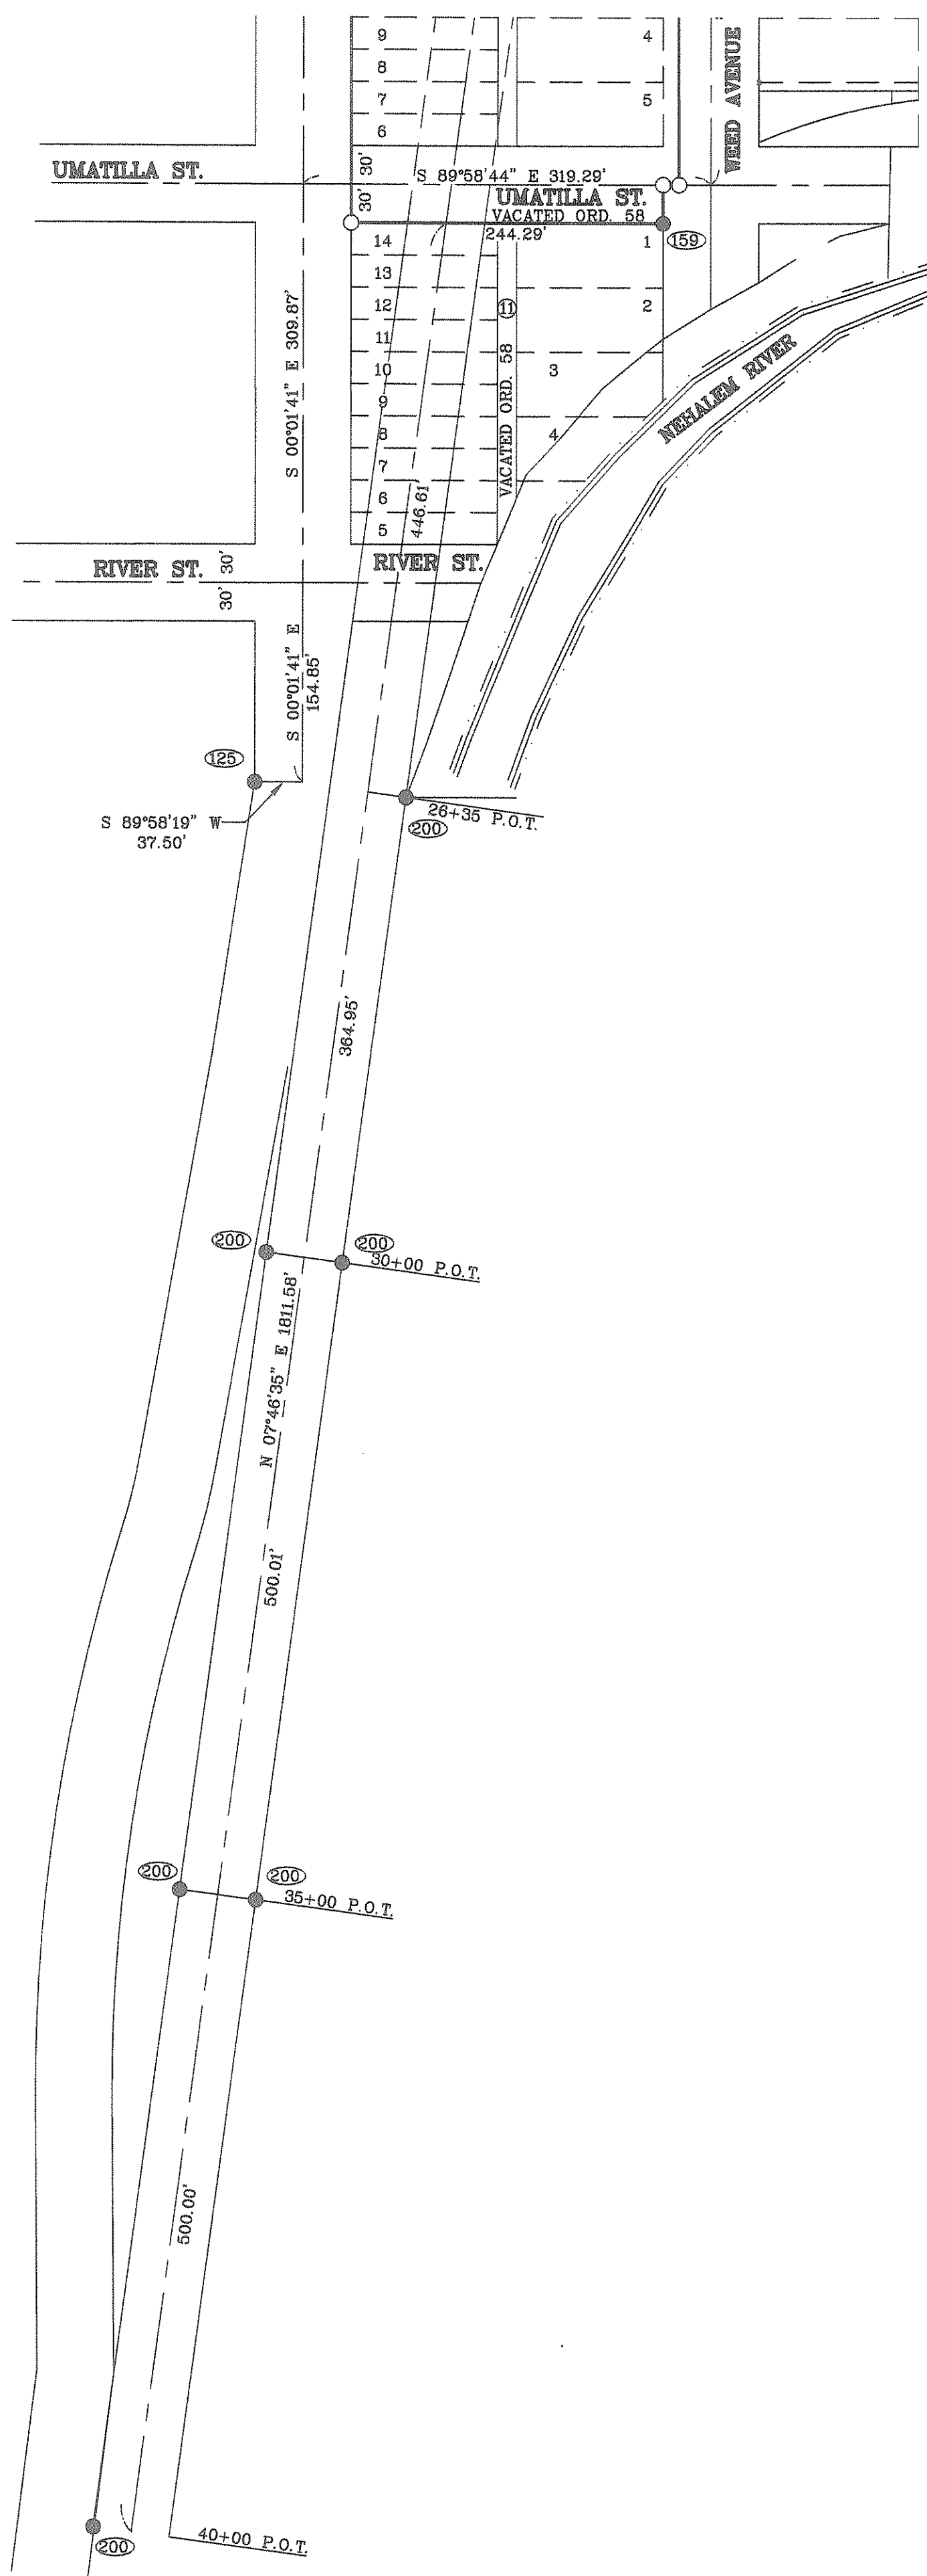

MONUMENT NOTES:

- 1 NW CORNER BLOCK 12, ROSE ADDITION  
FOUND A 5/8" IRON ROD WITH A Y.P.C. MARKED "RUSSEL 707" PER CS 3415. (HELD)
- 2 FOUND A 5/8" IRON ROD WITH A Y.P.C. MARKED "OREGON STATE PARKS" PER CS NO 3793. (HELD)
- 18 COLUMBIA 02  
FOUND A 3/4" IRON PIPE WITH A 2 1/2" BRASS CAP PER CS 4369.
- 59 FOUND A 5/8" IRON ROD WITH A 1 1/2" BRASS CAP STAMPED "ODOT" IN MONUMENT BOX PER CS NO. 5648, (HELD)
- 61 FOUND A 5/8" IRON ROD WITH A 1 1/2" BRASS CAP STAMPED "ODOT" IN MONUMENT BOX PER CS NO. 5648, (HELD)
- 66 SE CORNER OF BLOCK 3, CENTRAL ADDITION TO VERNONIA  
FOUND A 1 1/2" IRON PIPE. (HELD)
- 100 NE CORNER OF BLOCK 9, ROSE ADDITION  
FOUND A 5/8" IRON ROD WITH A Y.P.C. MARKED "SUMMERS PLS 1042" PER UNRECORDED SURVEY. (HELD)
- 101 NW CORNER OF LOT 4, BLOCK 7, ROSE ADDITION  
FOUND A 5/8" IRON ROD PER CS 3415, CAP MISSING. (HELD)
- 125 FOUND A 3/4" IRON PIPE AS NOTED ON CS 4321. (HELD FOR WEST RIGHT OF WAY LINE OF BRIDGE STREET)
- 154 SW CORNER OF BLOCK 6, ROSE ADDITION  
FOUND A 5/8" IRON ROD WITH A Y.P.C. MARKED "KEENON LS 1080 PER CS 3967. (HELD)
- 158 FOUND A 5/8" IRON ROD WITH A Y.P.C. MARKED "RUSSEL 707" PER CS 3415. (HELD)
- 159 NE CORNER OF BLOCK 11, ROSE ADDITION  
FOUND A 5/8" IRON ROD WITH A Y.P.C. MARKED "OREGON STATE PARKS" PER CS NO 3793. (HELD)
- 164 FOUND A 5/8" IRON ROD WITH A Y.P.C. MARKED "RUSSEL 707" PER CS 3415. (HELD)
- 200 FOUND A 5/8" IRON ROD WITH A Y.P.C. MARKED "OREGON STATE PARKS" PER CS 3793, (HELD)

LEGEND:

- = MONUMENT FOUND AS NOTED
- ⊗ = SET A BERNSTEN BP-2 BRASS DISC IN CONCRETE MARKED "KLS SURVEYING"
- = SET 5/8" X 30" IRON ROD WITH A Y.P.C. MARKED "K.L.S. SURVEYING INC"
- ( ) = RECORD SURVEY DATA
- [ ] = RECORD DEED DATA
- CS NO= RECORD SURVEY NUMBER
- Y.P.C.= YELLOW PLASTIC CAP
- = MONUMENT POINT NUMBER (SEE MONUMENT NOTES)

REFERENCE SURVEYS:

- 1 = CS NO. M-12
- 2 = PLAT OF ROSE ADDITION (K/390)
- 3 = CS NO. 178
- 4 = CS NO. 3415
- 5 = CS NO. 3973
- 6 = CS NO. 3967
- 7 = CS NO. 4321
- 8 = CS NO. 4755
- 9 = CS NO. 5648

REGISTERED  
PROFESSIONAL  
LAND SURVEYOR  
  
DONALD D. WALLACE JR.  
OREGON  
JANUARY 19, 1993  
DONALD D. WALLACE JR.  
2601  
RENEWAL DATE 6/30/14

K.L.S. SURVEYING INC.  
1224 ALDER STREET  
VERNONIA, OR 97064  
(503) 429-6115

SURVEY FOR  
WEST OREGON ELECTRIC & THE CITY OF  
VERNONIA, IN ROSE ADD. TO VERNONIA  
IN THE SE 1/4 OF SECTION 5,  
T4N, R4W, W.M.  
COLUMBIA COUNTY, OREGON  
SCALE 1" = 100' FEBRUARY 18, 2014

SHEET 2 OF 2