


561-8

B-175

PROPERTY BOUNDARY SURVEY
a portion of Block 2,
of The Second Addition to Vernonia
in the NW 1/4 NE 1/4,
Section 4, Twp 4 N, Rge 4 W,
Columbia County, Oregon
Scale 1" = 50' Nov. 30, 1992

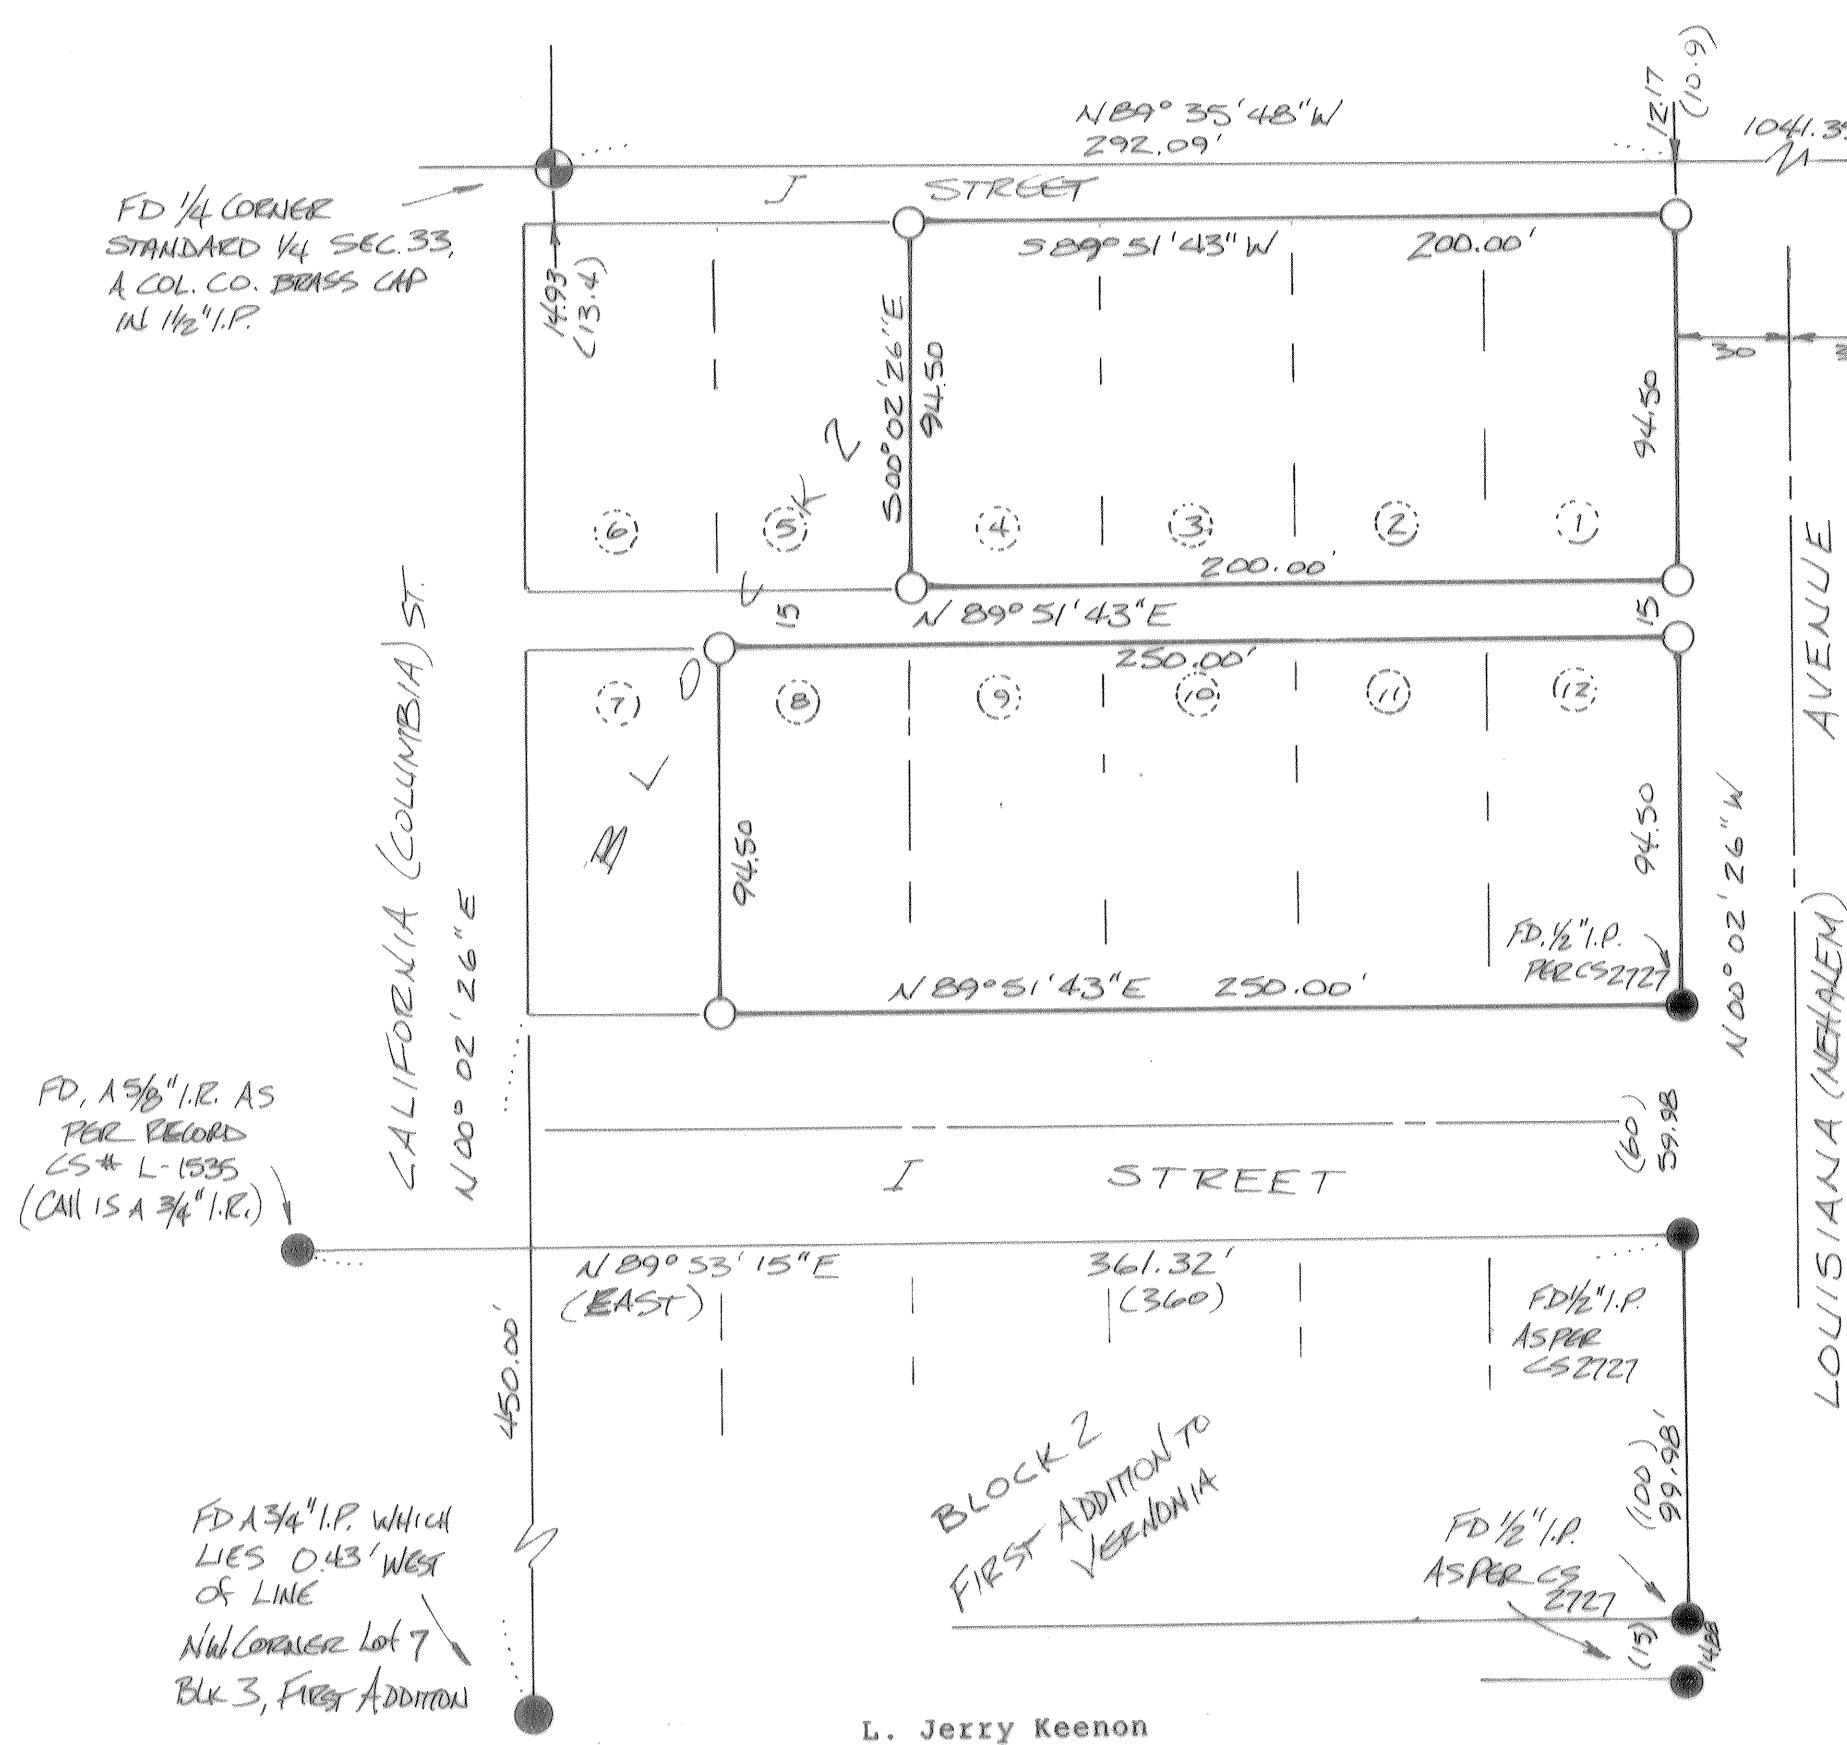

LEGEND:

- Monument found, as noted
- Monument set, each 5/8" x 30" iron rod with yellow plastic cap; "KEENON LS1080"
- Public Road Centerline
- () RECORD INFORMATION

NOTE: THE SECOND ADDITION IS "THE SECOND ADDITION TO THE VERNONIA IMPROVEMENT COMPANY"

NARRATIVE:
This survey was accomplished at the request of Mr. Lanny J. Robson, for the purpose of defining, and monumenting the exterior boundaries of Lots Numbers 1, 2, 3, 4, 8, 9, 10, 11, and 12, all in Block 2, of THE SECOND ADDITION TO VERNONIA. The survey control is from monuments of record recovered as noted and described, with each of the corner monuments being established for the outside boundaries as shown. I held the recovered monuments from record survey CS# 2727, to establish the lot boundaries as deeded. Additional control monuments were also tied as shown hereon, supporting the use of CS# 2727.

The basis of bearings is also from record survey CS # 2727.

COUNTY SURVEYOR
RECEIVED 12-22-92
FILED 1-27-93

L. Jerry Keenon
KEENON LAND SERVICES, INC.
1311 Alder Street
Vernonia, Oregon 97064

B-175

B-175