


B-94

B-94

RECORD OF SURVEY
for CAVENHAM FOREST IND. INC.
IN THE SE 1/4 SEC. 8, T. 4N., R. 4W., W.M.
COLUMBIA COUNTY, OREGON
SCALE 1"=400' JULY 16, 1991



NARRATIVE: THE PURPOSE OF THIS SURVEY WAS TO MARK AND MONUMENT THE PROPERTY LINE AS SHOWN. THE LINE SHOWN WAS MARKED WITH RED AND WHITE RIBBON. NEW BT'S ARE MARKED WITH 4 BLAZES UP THE FACE, A SPIKE IN THE BASE AND LOCATION TAGS ABOVE BLAZES. BEARING BASED ON RECORD SURVEY CS# 3709. RP/BT'S SET WITH HAND COMPASS AND TAPED

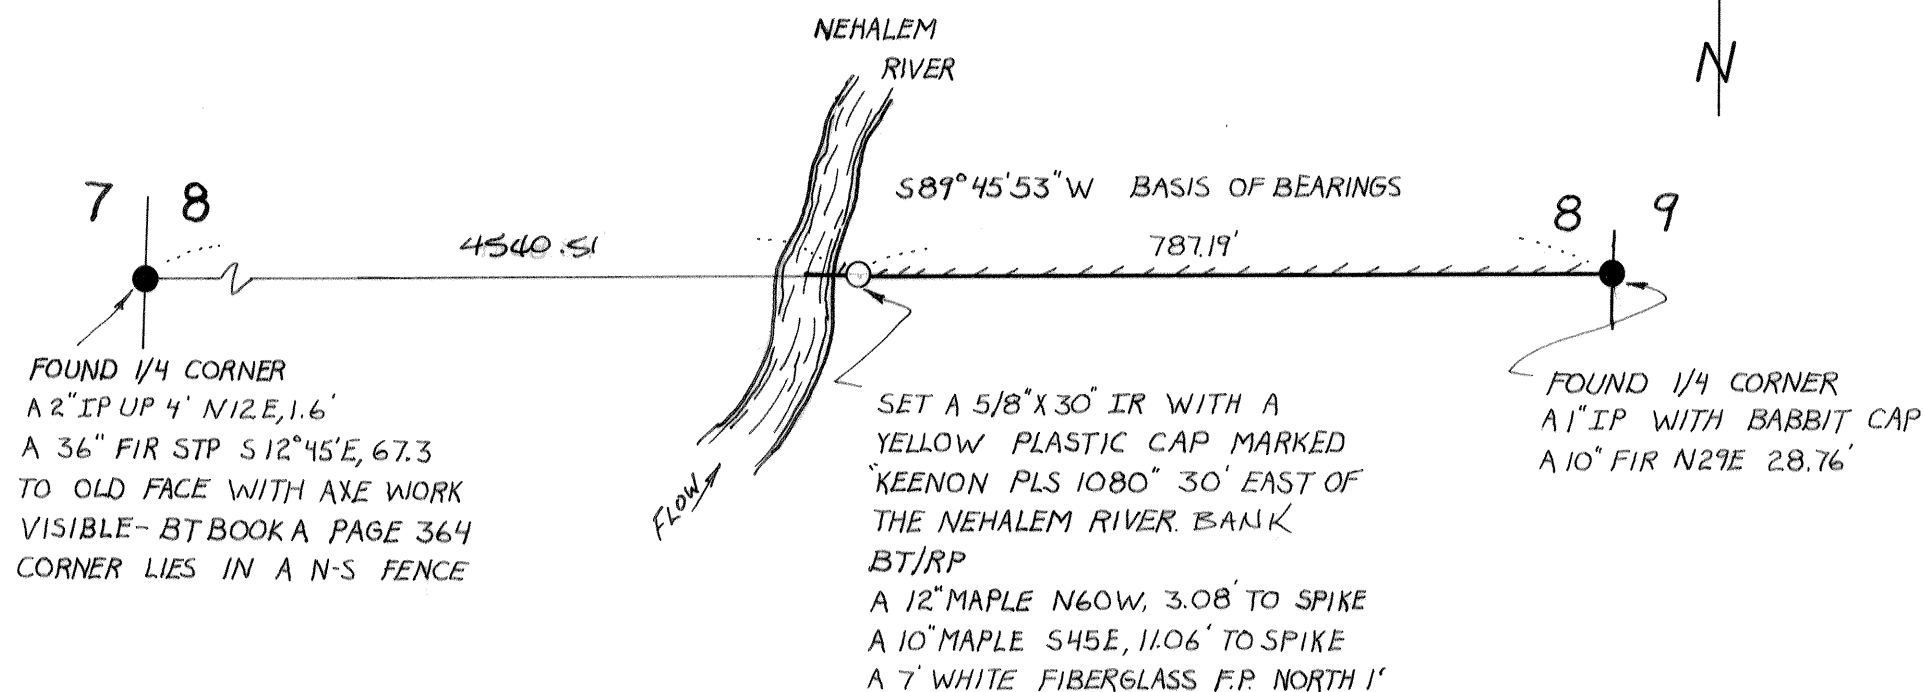


LEGEND

- - MONUMENT FOUND AS NOTED
- - MONUMENT SET AS NOTED

L. JERRY KEENON
1311 ALDER ST.
VERNONIA OREGON 97064
PH # 429-6115

COUNTY SURVEYOR
RECEIVED 8-14-91
FILED 11-7-91 G.D.
CS # B-94

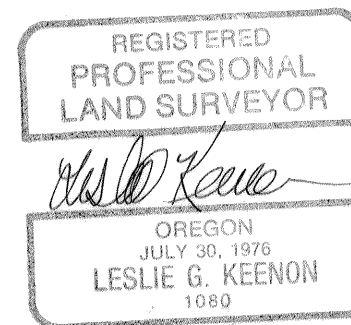

DRAWN BY: DON WALLACE

B-94

B-94