

NARRATIVE:

--THIS SURVEY WAS ACCOMPLISHED AT THE REQUEST OF WEYERHAEUSER COMPANY TO MARK AND MONUMENT THE BOUNDARY LINES SHOWN AS HATCHED IN SECTION 32 TOWNSHIP 5 NORTH, RANGE 4 WEST OF THE WILLAMETTE MERIDIAN.

--THE BEARINGS ARE NAD83 (2011) EPOCH 2010, OREGON COORDINATE REFERENCE SYSTEM COLUMBIA RIVER WEST. DISTANCES SHOWN ARE GROUND DISTANCES.

--FOR CONTROL I HELD THE MONUMENTS AS NOTED.

SECTION 32:
--THE MONUMENT AT THE 1/4 CORNER COMMON TO SECTIONS 32 & 33 IS MISSING. I HELD THE LOCATION FROM LOCAL CONTROL I USED WHILE TYING THE CORNER IN MY SURVEY RECORDED AS CS NO. 5296. THE SE 1/4 WAS SUBDIVIDED IN CS NO. 245. IN 1984 CS NO. L-1743 REPORTS FINDING THE CS AND SE 1/16 CORNER PER CS NO. 245. I FIND BOTH CORNERS, THE SE 1/16 CORNER LIES WEST 19.9' AND SOUTH 11.3' FROM THE COMPUTED LOCATION. I ACCEPT BOTH CORNERS BASED ON THEIR AGE, USE AND ACCEPTANCE.

ROBERTSON TRACT (INSTRUMENT NO. 2018-4271)
--I HELD THE MONUMENTS SET IN CS NO. L-1743 AND EXTENDED THE WEST LINE SOUTH TO THE LINE BETWEEN THE CS AND SE 1/16 CORNERS PER CS NO. 245.

--BOUNDARY LINES SHOWN AS HATCHED WERE MARKED WITH RED AND WHITE RIBBON ON LINE.

--ALL REFERENCES WERE MEASURED WITH A HAND COMPASS SET AT DECLINATION 16° EAST AND A STEEL TAPE. ALL NEW BEARING TREES WERE MEASURED TO THE HEAD OF A 60D SPIKE SET IN THE BASE BLAZE BETWEEN THE "B" AND THE "T". BEARING TREE TAGS WERE PLACED AT SHOULDER HEIGHT ABOVE THE BLAZES.

MONUMENT NOTES:

[29]
1/4 CORNER SECTION 32
FOUND A 2" IRON PIPE WITH A 3" BRASS CAP UP 12" PER CS NO. 3201 (HELD).
A WHITE FIBER GLASS POST N 2.0'

[802]
FOUND A 1/2" IRON PIPE UP 1.00' PER CS NO. L-1743. HELD FOR WEST LINE
MONUMENT BEARS N 1°32'10" E 3.70' FROM SET CORNER.
RED TEE POST BEARS WEST 0.10'.

[811]
FOUND A 1/2" IRON PIPE PER CS NO. L-1743 (HELD).

[820]
FOUND A 1/2" IRON PIPE PER CS NO. L-1743 (HELD FOR NORTH LINE OF
ROBERTSON TRACT)

[839]
CENTER SOUTH 1/16
SET A 5/8" IRON ROD WITH A YELLOW PLASTIC CAP MARKED "KLS SURVEYING
INC"
REFERENCES FOUND FROM CS NO. 245.
A 26" ROTTEN STUMP UP 36" BEARS S 82° W 21.70'
A 28" ROTTEN STUMP UP 30" BEARS S 00° E 15.70'
NEW REFERENCE:
7" FIR BEARS N 36° W 7.34' TO SPIKE SCRIBED "CS 1/16 S32"
8" FIR BEARS N 73° E 9.59' TO SPIKE SCRIBED "CS 1/16 S32"


[867]
CENTER OF SECTION 32
FOUND A 1" STAINLESS PIPE UP 2.35' ORIGIN UNKNOWN, FIRST NOTED IN CS
NO. 2616, BEARING TREES FROM CS NO. 245.
REFERENCES FOUND FROM CS NO. 245.
A 36" FIR HEALED FACE BEARS S 67°36' W 2.63'
A 21" FIR HEALED FACE BEARS S 20°23' E 2.92'

[877]
SOUTH EAST 1/16
FOUND A 1/2" IRON PIPE PER CS NO. L-1743 (HELD) DECAYING WOOD POST
BEARS EAST 0.80'.

[1030]
SOUTHEAST SECTION CORNER SECTION 32
FOUND A 2" IRON PIPE WITH A 3" BRASS CAP PER CS NO. 3201 (HELD).

LEGEND

- FOUND MONUMENT AS NOTED
- SET A 5/8" X 30" IRON ROD WITH A YELLOW PLASTIC CAP MARKED "KLS SURVEYING INC."
- [X] MONUMENT POINT NO
- () RECORD SURVEY DATA
- CS NO. SURVEY NUMBER, COLUMBIA COUNTY SURVEY RECORDS
- Y.P.C. YELLOW PLASTIC CAP

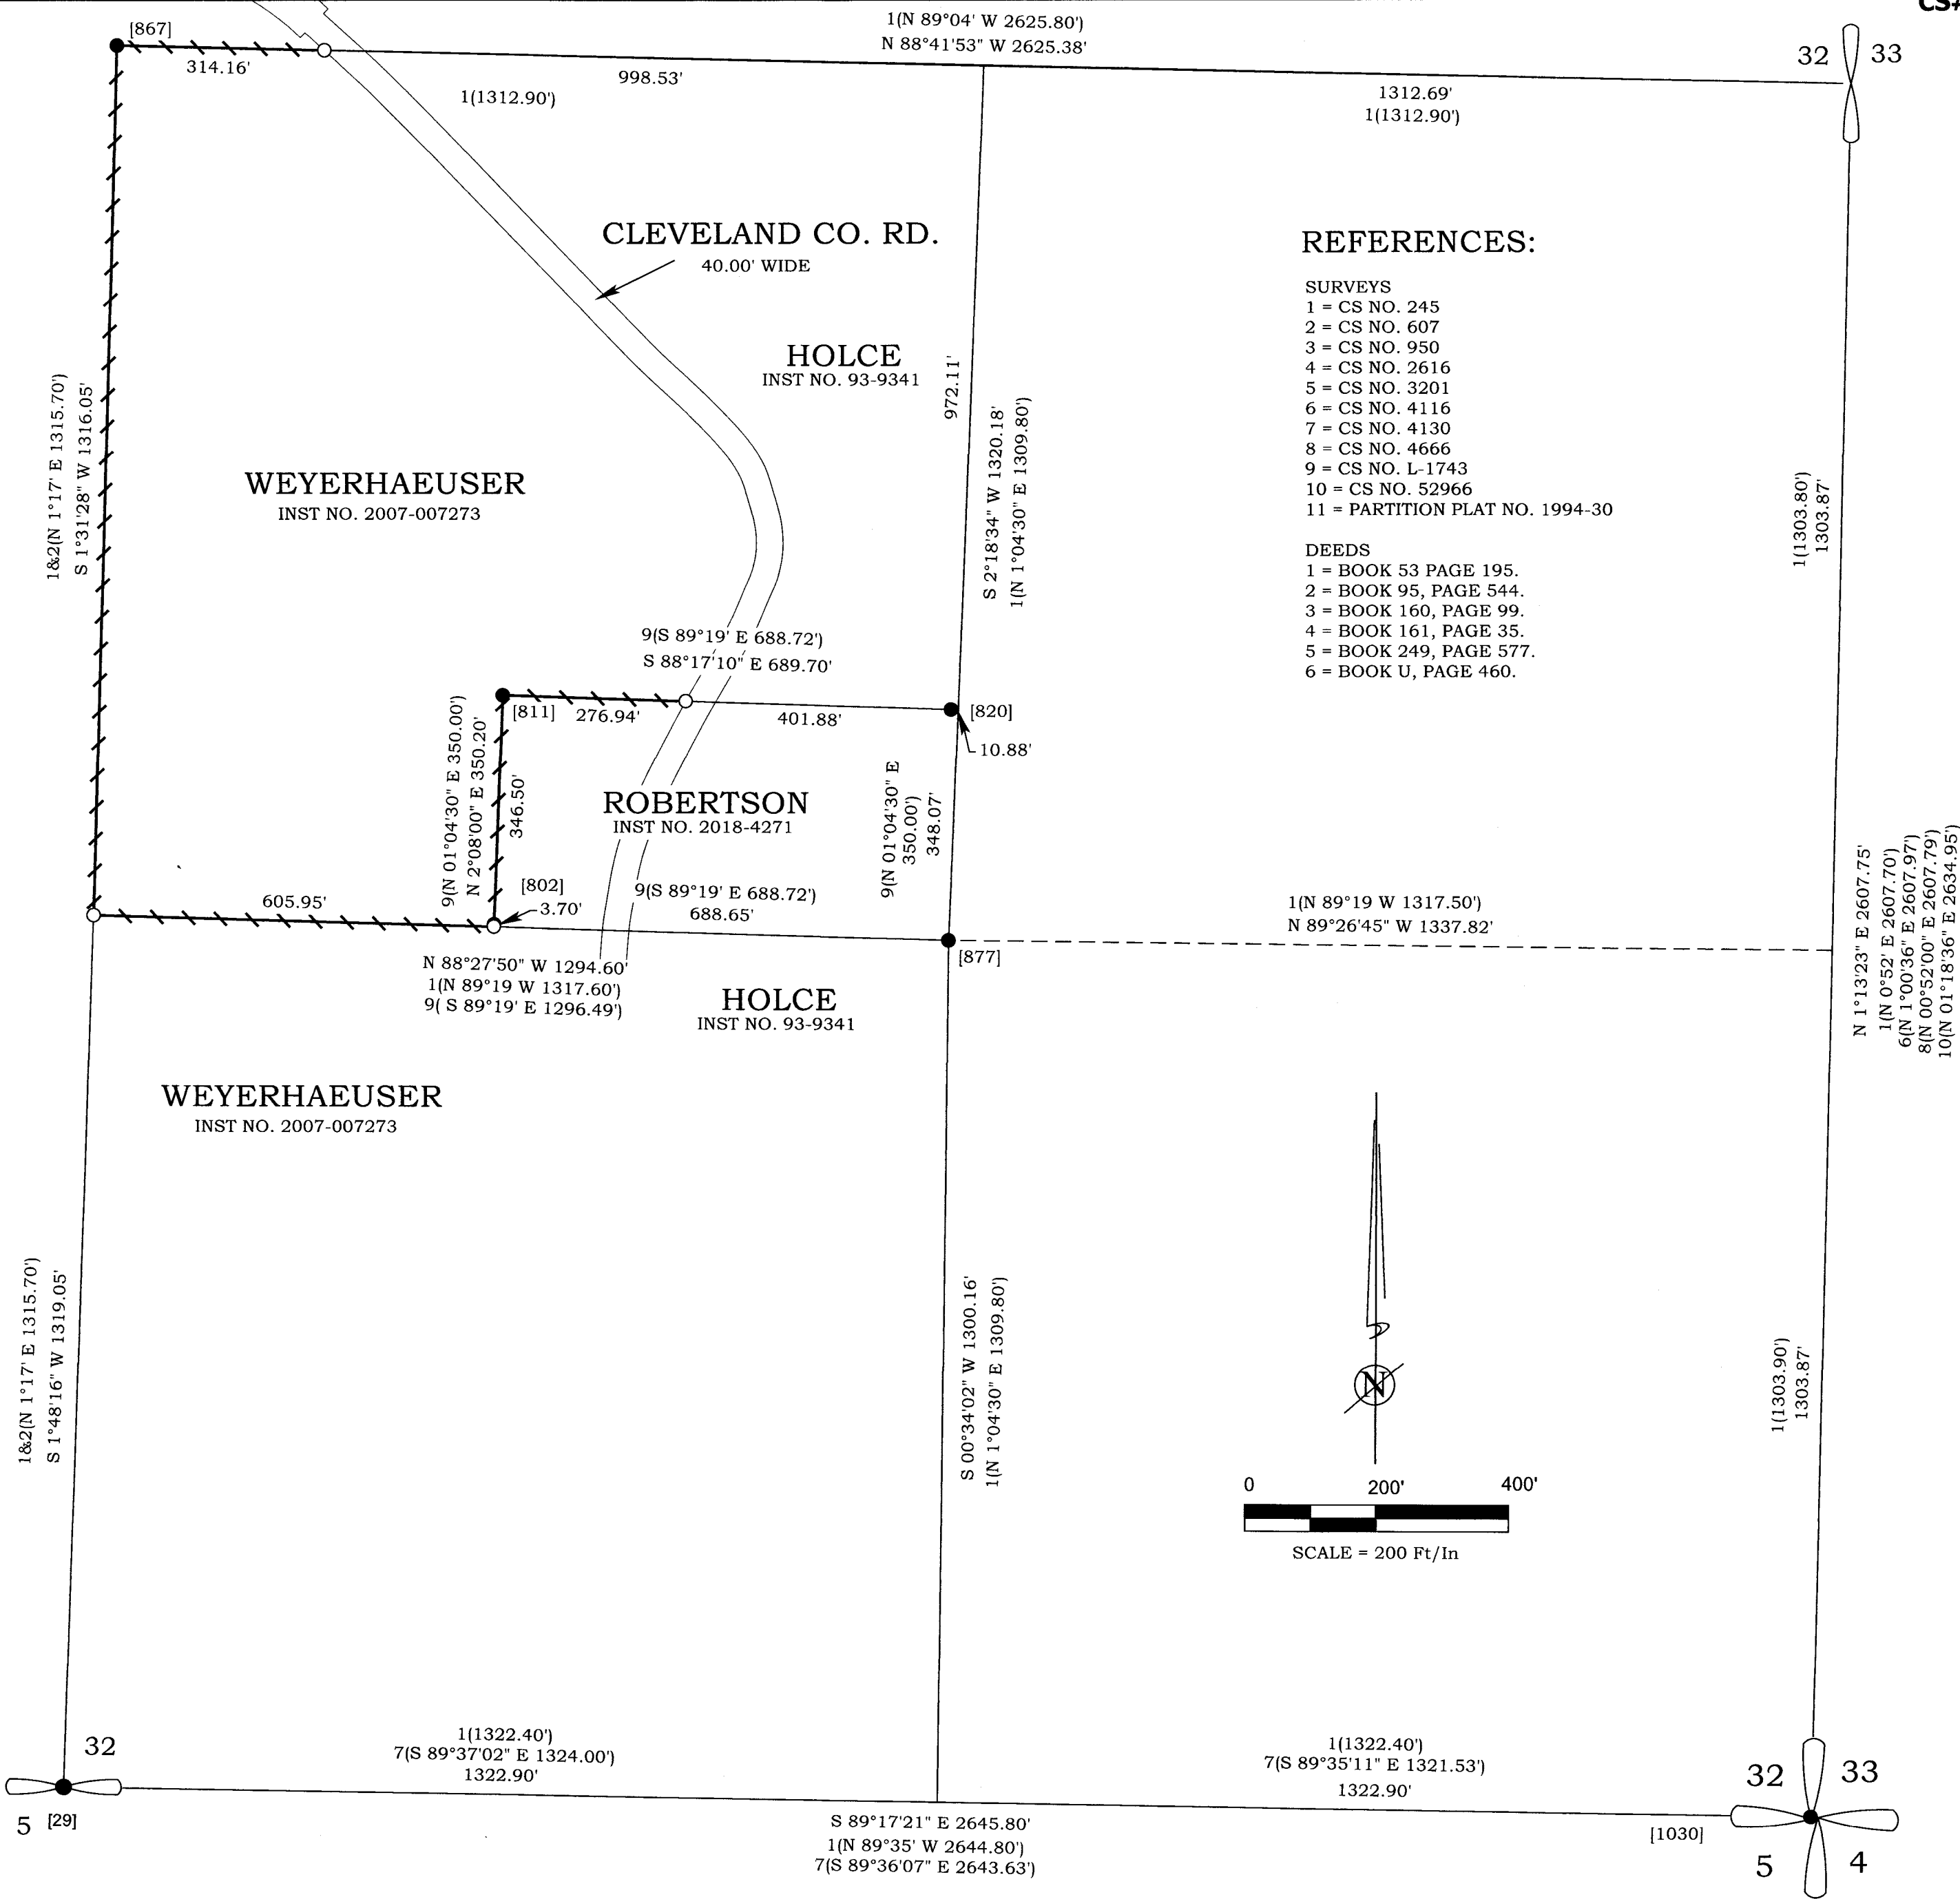

REGISTERED
PROFESSIONAL
LAND SURVEYOR

OREGON
JANUARY 19, 1993
DONALD D WALLACE, JR
2601
RENEWES 6/30/22

K.L.S. SURVEYING INC.
1224 ALDER STREET
VERNONIA, OREGON 97064
(503) 429-6115

RECORD OF SURVEY FOR
WEYERHAEUSER COMPANY
AND SUZY ARMSTRONG
IN THE SE 1/4 OF SECTION 32,
T5N, R4W, W.M.,
COLUMBIA COUNTY, OREGON
NOVEMBER 4, 2020

DRAWN BY: DDW / JDT
FIELD: SWM JR / BTD
EQUIPMENT: GTP301/RECON
JOB No. 20-181
DRAWING NAME: 20-181 ROS
REVISED: 12-21-2020