

fb-9

NEHALEM  
RIVER

5/8" IRON ROD  
WITH CAP PER  
RS # 3805

BASIS OF BEARINGS  
NORTH 87.12'

5/8" IRON ROD  
WITH CAP PER  
RS # 3805

UPPER NEHALEM COUNTY ROAD

N86°23'08"E 263.89'

N 01°20'10"E 475.10'

4.13 ac.

N88°51'43"E 164.87'

N 01°20'10"E 320.00'

117.10'


224.87'

S 88°51'43"E

1/4 CORNER  
A 5/8" IRON ROD WITH A  
2" OREGON STATE PARKS  
ALUMINUM CAP

1319.11'

7 8

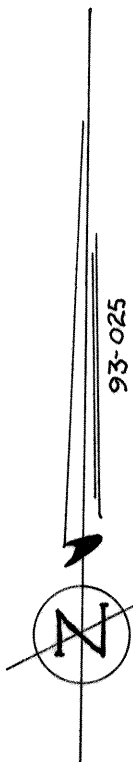

# RECORD OF SURVEY FOR SCHANN AND DENNIS NELSON IN THE SE 1/4 OF SEC 7, T4N, R4W, W.M. COLUMBIA COUNTY, OREGON SCALE 1"=100' MARCH 23, 1993

NARRATIVE: THIS SURVEY WAS ACCOMPLISHED AT THE REQUEST OF SCHANN AND DENNIS NELSON TO MONUMENT THE EAST LINE OF THEIR PROPERTY AS DESCRIBED IN DOC. 88-4037. FOR CONTROL I USED OUR RECOVERED TRAVERSE CONTROL FROM RS # 3805. THE BASIS OF BEARINGS IS FROM RS # 3805.

## LEGEND

- - FOUND, AS NOTED
- - SET A 5/8"X30" IRON ROD WITH A YELLOW PLASTIC CAP MARKED "KEENON LS 1080"
- RS - RECORD SURVEY No.

L. JERRY KEENON  
1311 ALDER ST  
VERNONIA, OREGON 97064  
PHONE 429-6115



COUNTY SURVEYOR  
RECEIVED 4-8-93 T.D.  
FILED 4-21-93

DRAWN BY: DON WALLACE

B-194

B-194