


RECORD OF SURVEY
FOR DARYL GWIN, STEVE LANDERS, AND WALT KEEFER
IN THE NE 1/4 OF SEC. 4
AND LOTS 10-12 BLOCK 4, MALMSTEN'S RIVERSIDE VIEW
IN THE NW 1/4 OF SEC. 3, T4N, R4W, WM.
COLUMBIA COUNTY, OREGON
JULY 12, 1993 SCALE 1"=50'

3868

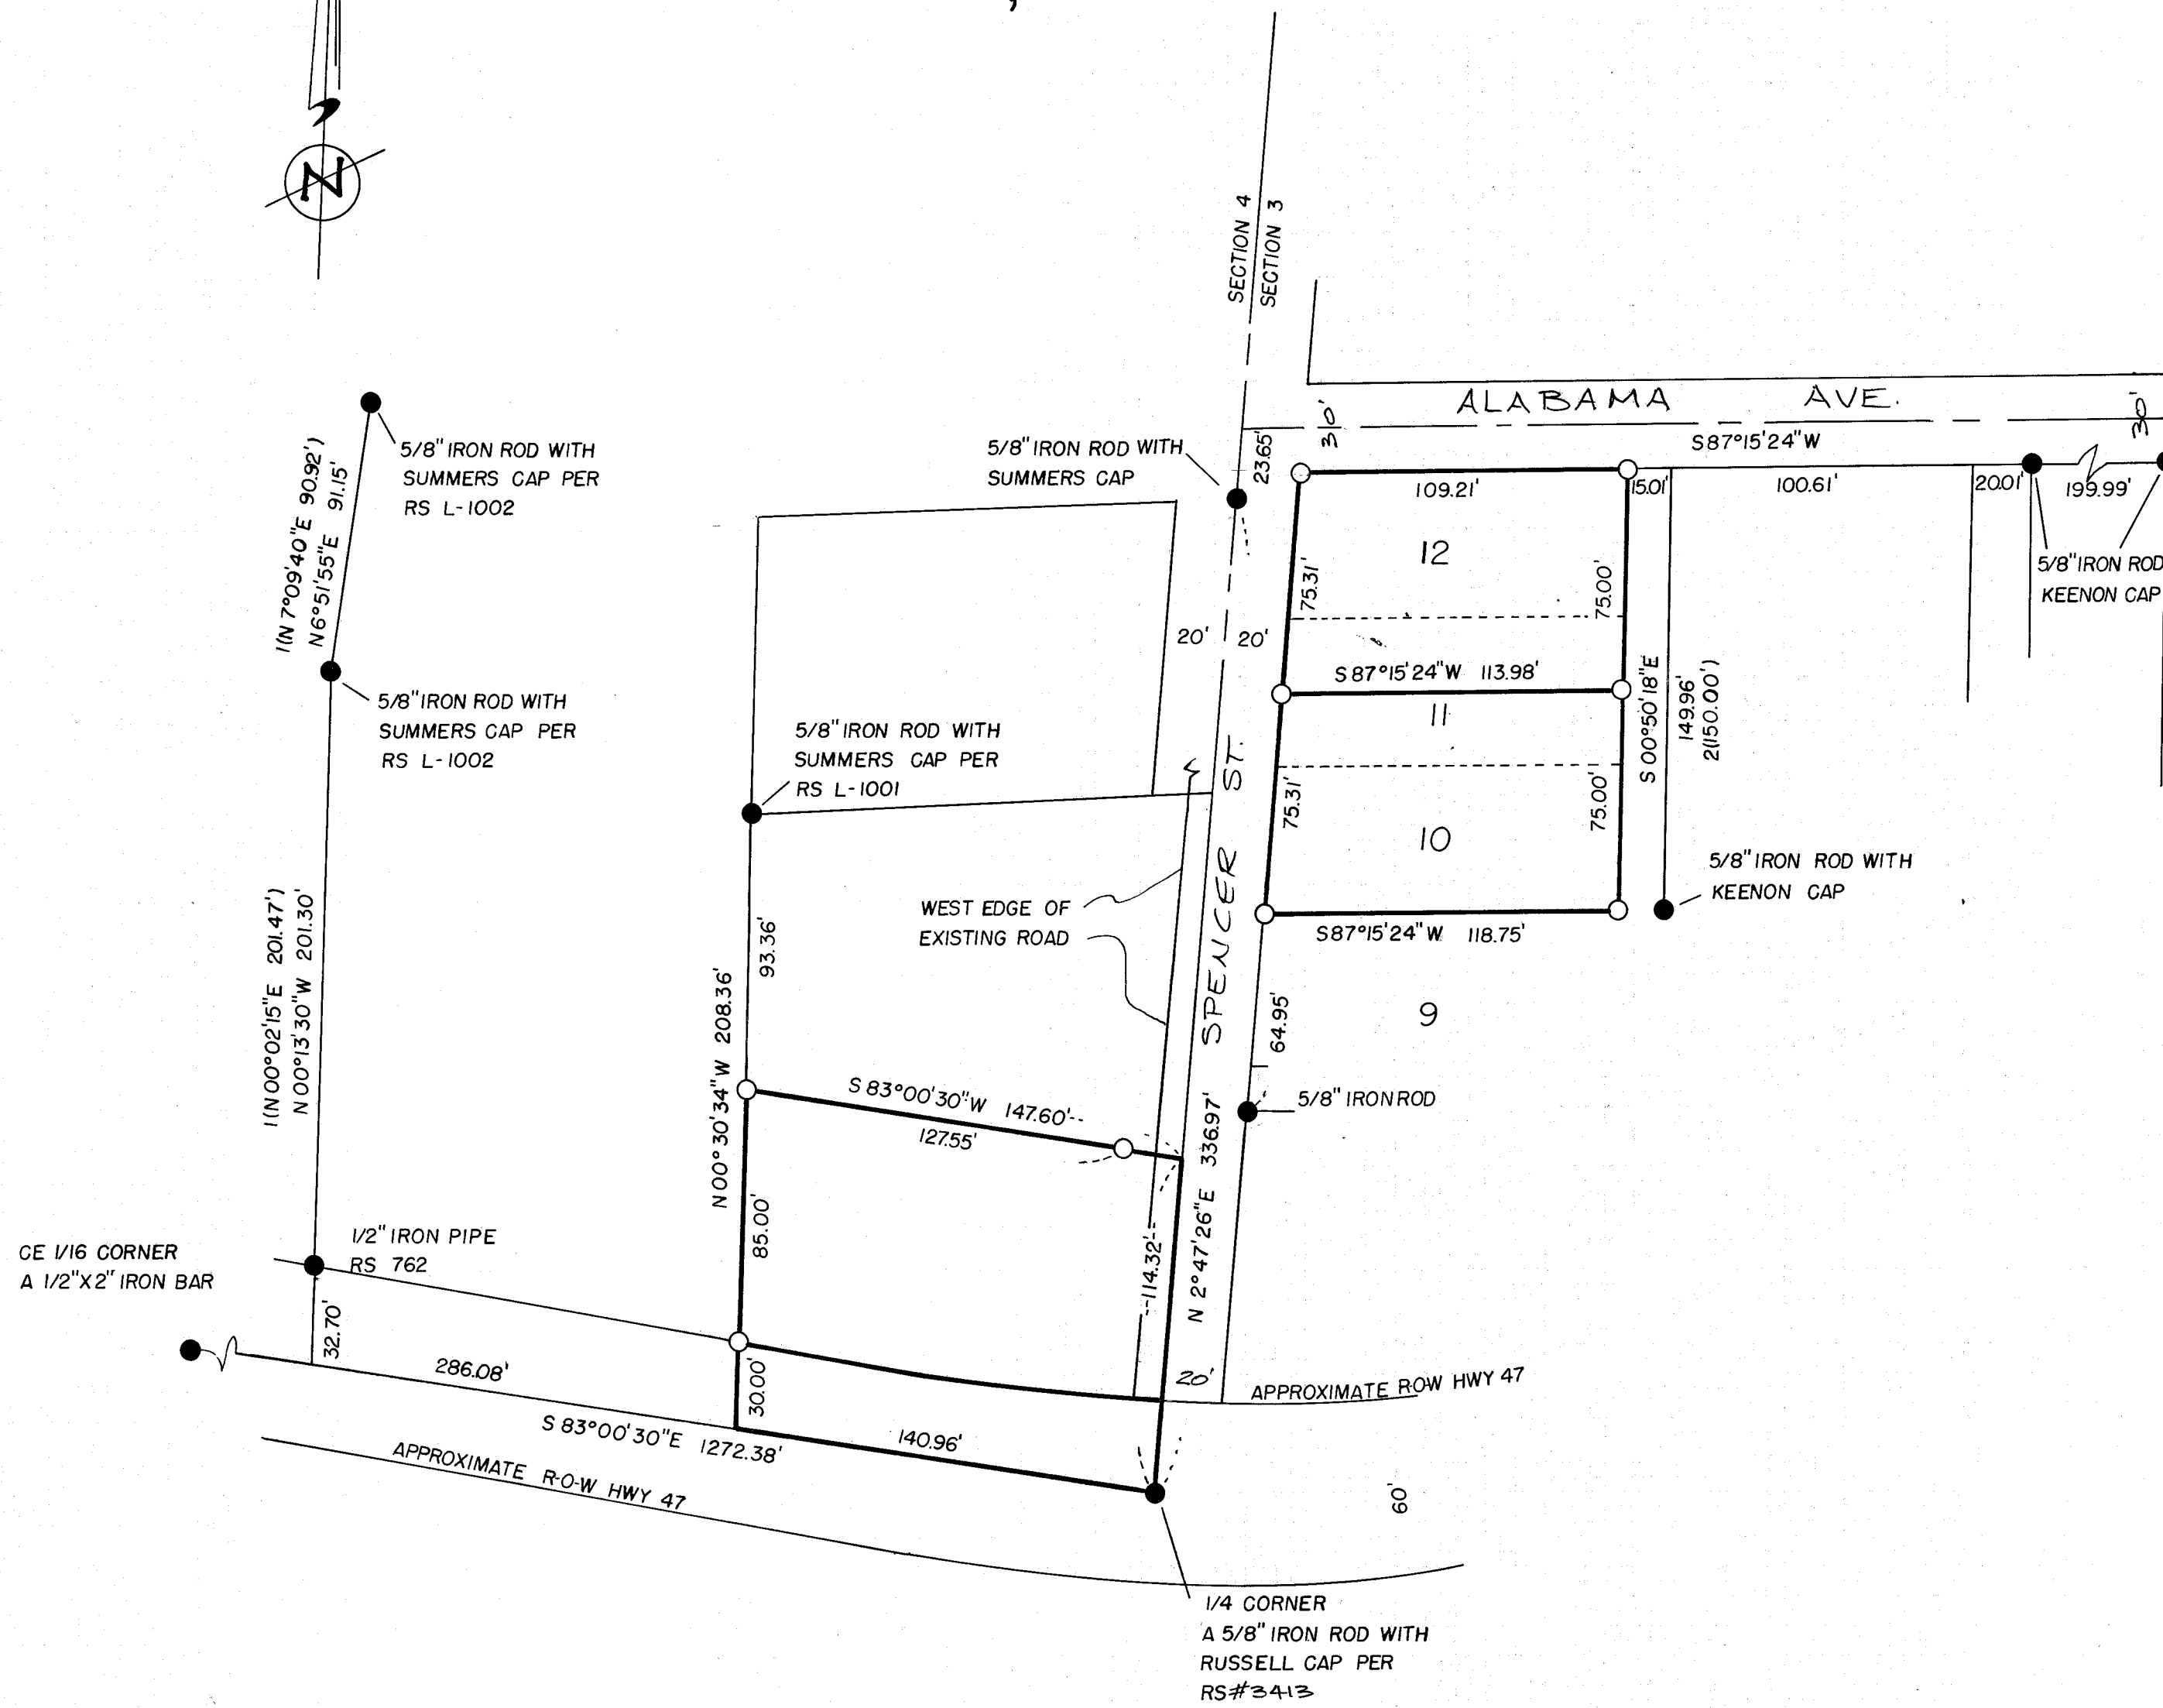

NARRATIVE: THE PURPOSE OF THIS SURVEY WAS TO MONUMENT THE TRACTS SHOWN. THE BASIS OF BEARINGS IS THE SECTION LINE NORTH OF THE 1/4 COMMON TO SECTIONS 3 AND 4 FROM RS 3523 FOR CONTROL. I HELD THE MONUMENTS OF RECORD AS SHOWN.

* 1/4 DENOTES 1/4 CORNER MONUMENT

- LEGEND
- MONUMENT FOUND AS NOTED
 - SET A 5/8" X 30" IRON ROD WITH A YELLOW PLASTIC CAP MARKED "KEENON LS 1080"
 - () RECORD INFORMATION 1=RS L-1002 2=MALMSTEN'S RIVERSIDE VIEW
 - RS RECORD SURVEY No.

L. JERRY KEENON
1311 ALDER ST
VERNONIA, OREGON 97064
PH # 429-6115

REGISTERED
PROFESSIONAL
LAND SURVEYOR
Leslie G. Keenon
OREGON
JULY 30, 1976
LESLIE G. KEENON
1080
EXP 12/31/93

COUNTY SURVEYOR
RECEIVED 8-13-93
FILED 9-20-93