


8/8/7

4318

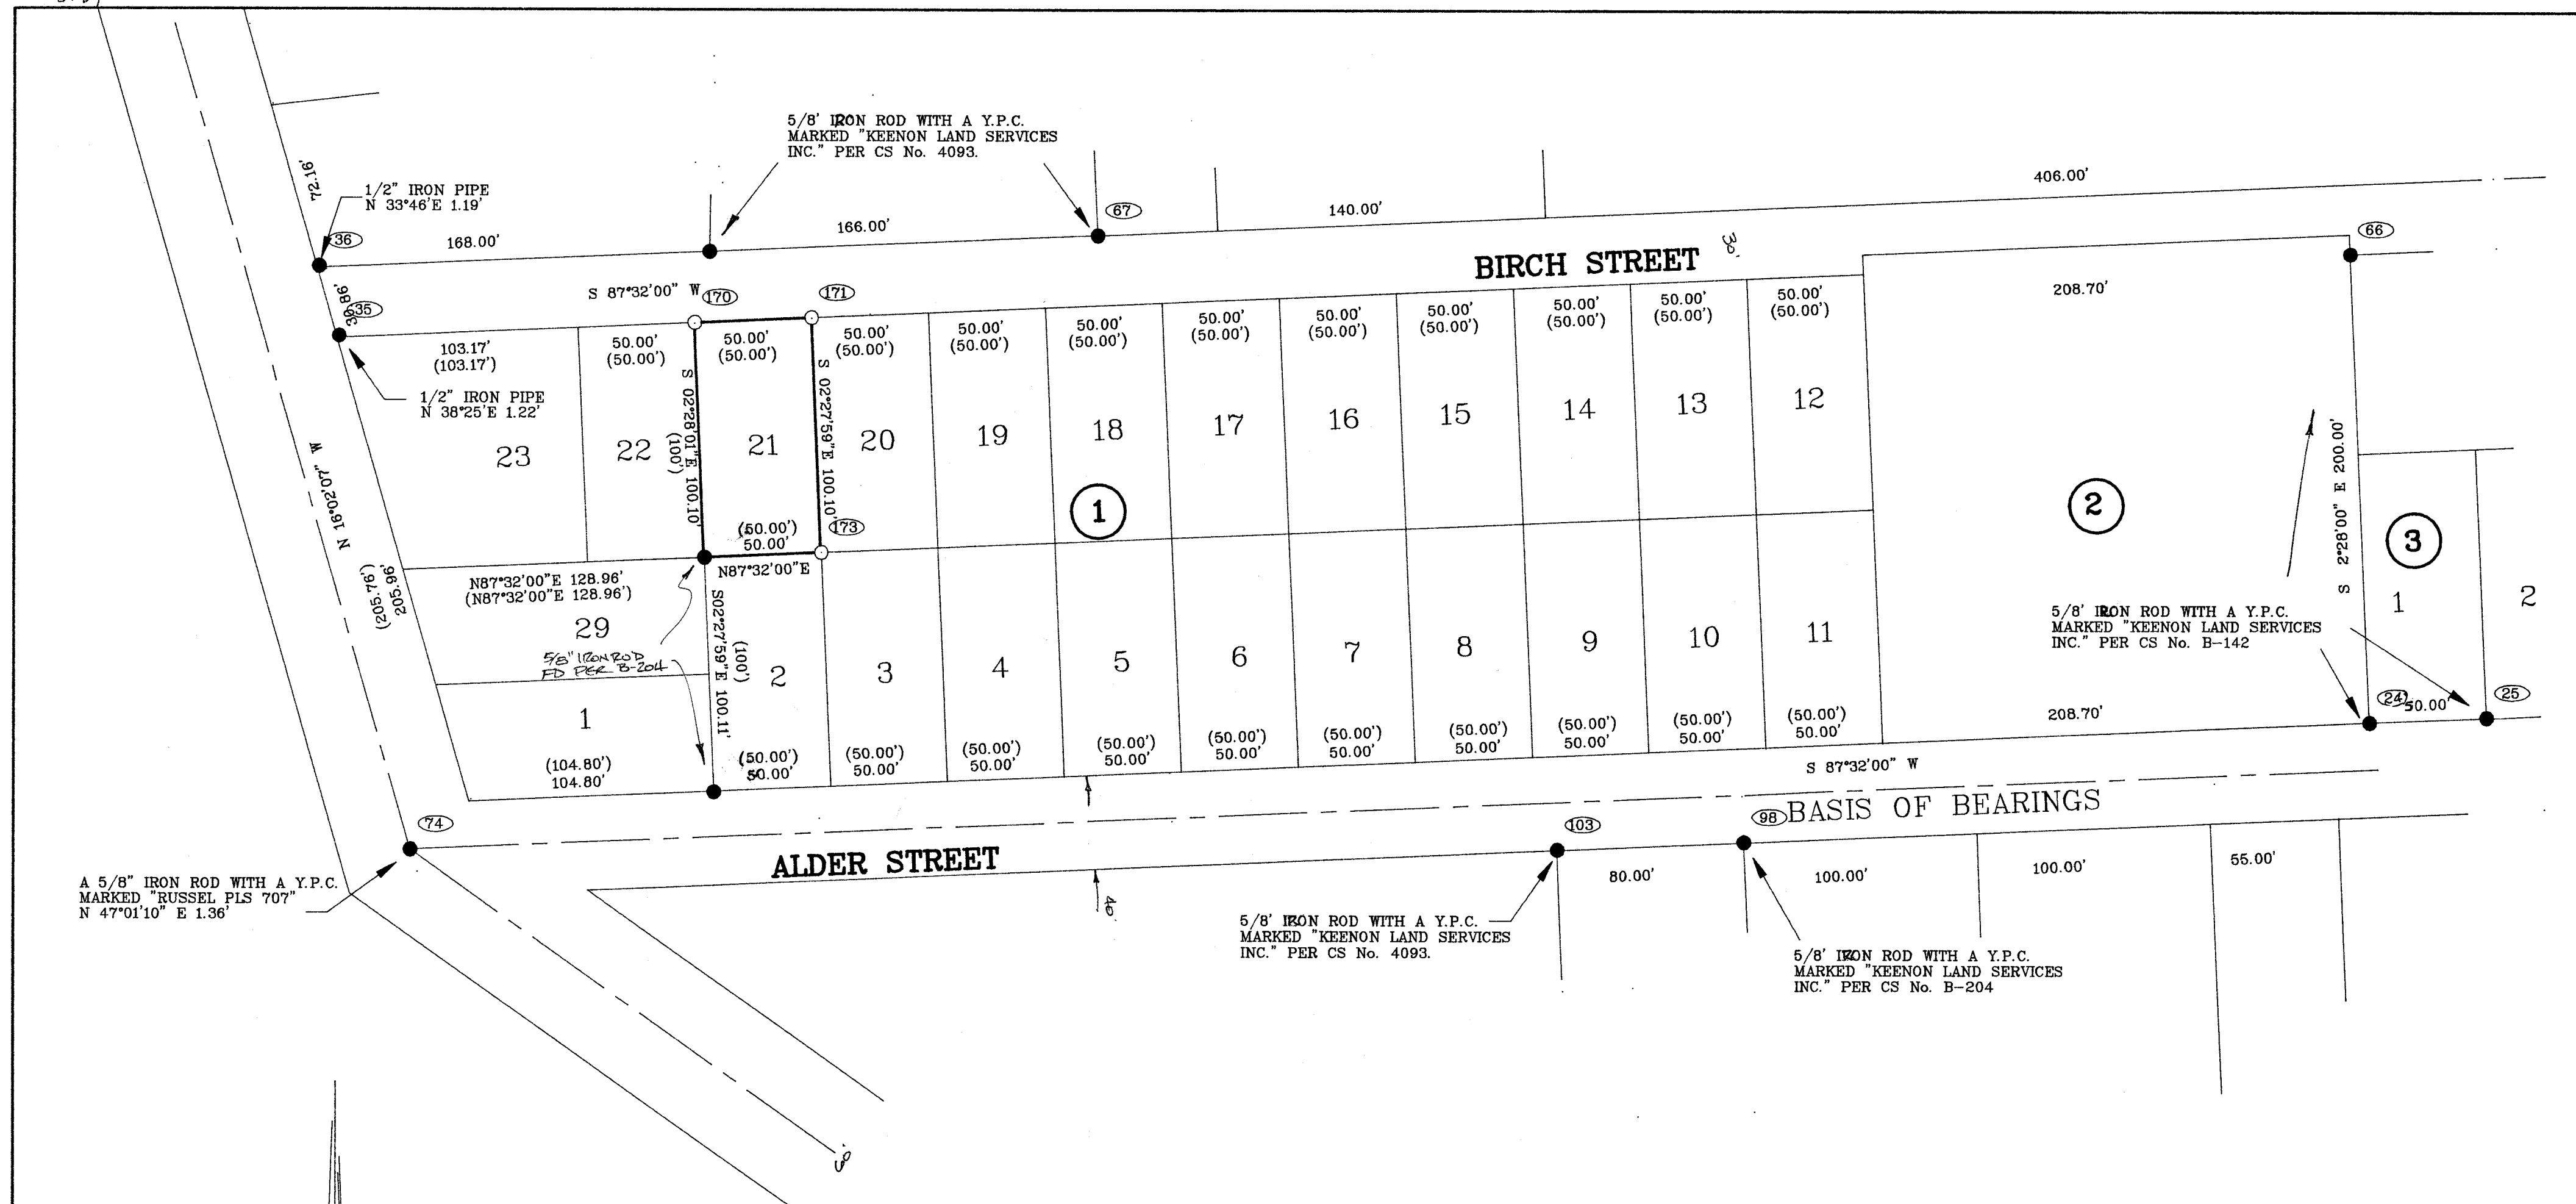

A 5/8" IRON ROD WITH A Y.P.C.
MARKED "RUSSEL PLS 707"
N 47°01'10" E 1.36'

5/8" IRON ROD WITH A Y.P.C.
MARKED "KEENON LAND SERVICES
INC." PER CS No. 4093.

5/8" IRON ROD WITH A Y.P.C.
MARKED "KEENON LAND SERVICES
INC." PER CS No. B-142

5/8" IRON ROD WITH A Y.P.C.
MARKED "KEENON LAND SERVICES
INC." PER CS No. 4093.

5/8" IRON ROD WITH A Y.P.C.
MARKED "KEENON LAND SERVICES
INC." PER CS No. B-204

NARRATIVE:
--THE PURPOSE OF THIS SURVEY WAS TO MONUMENT LOT 21, BLOCK 1,
RIVERVIEW LOTS IN THE CITY OF VERNONIA.
--THE BASIS OF BEARINGS IS FROM CS No. 4093
--FOR CONTROL I HELD CS No. 4093

LEGEND

- = MONUMENT FOUND AS NOTED
- = SET A 5/8" x 30" IRON ROD WITH A Y.P.C.
MARKED "KEENON LAND SERVICES INC."
- () = RECORD SURVEY DATA
- [] = RECORD DEED DATA
- CS No. = RECORD SURVEY No.
- Y.P.C. = YELLOW PLASTIC CAP
- = CONTROL POINT No.

<p>REGISTERED PROFESSIONAL LAND SURVEYOR</p> <p><i>Leslie G. Keenon</i></p> <p>OREGON JULY 30, 1976 LESLIE G. KEENON 1080 RENEWAL DATE 6/30/97</p>	<p>KEENON LAND SERVICES</p> <p>1224 ALDER ST. VERNONIA, OR 97064 (503) 429-6115</p>	<p>SURVEY FOR BRIAN AND MARY MAYNARD LOT 21, BLOCK 1, RIVERVIEW LOTS IN THE NW 1/4 OF SECTION 3, T4N, R4W, W.M. COLUMBIA COUNTY, OREGON SCALE 1" = 50 MARCH 20, 1997</p>		<p>COLUMBIA COUNTY SURVEYORS OFFICE RECEIVED <u>6-3-97</u> ACCEPTED <u>7-22-97</u> CHECK # <u>125</u></p>	
		<p>DRAWN BY: DDW</p>	<p>FIELD: MM/SD</p>		<p>EQUIPMENT: GTS300/TDS48</p>

4318

4318