
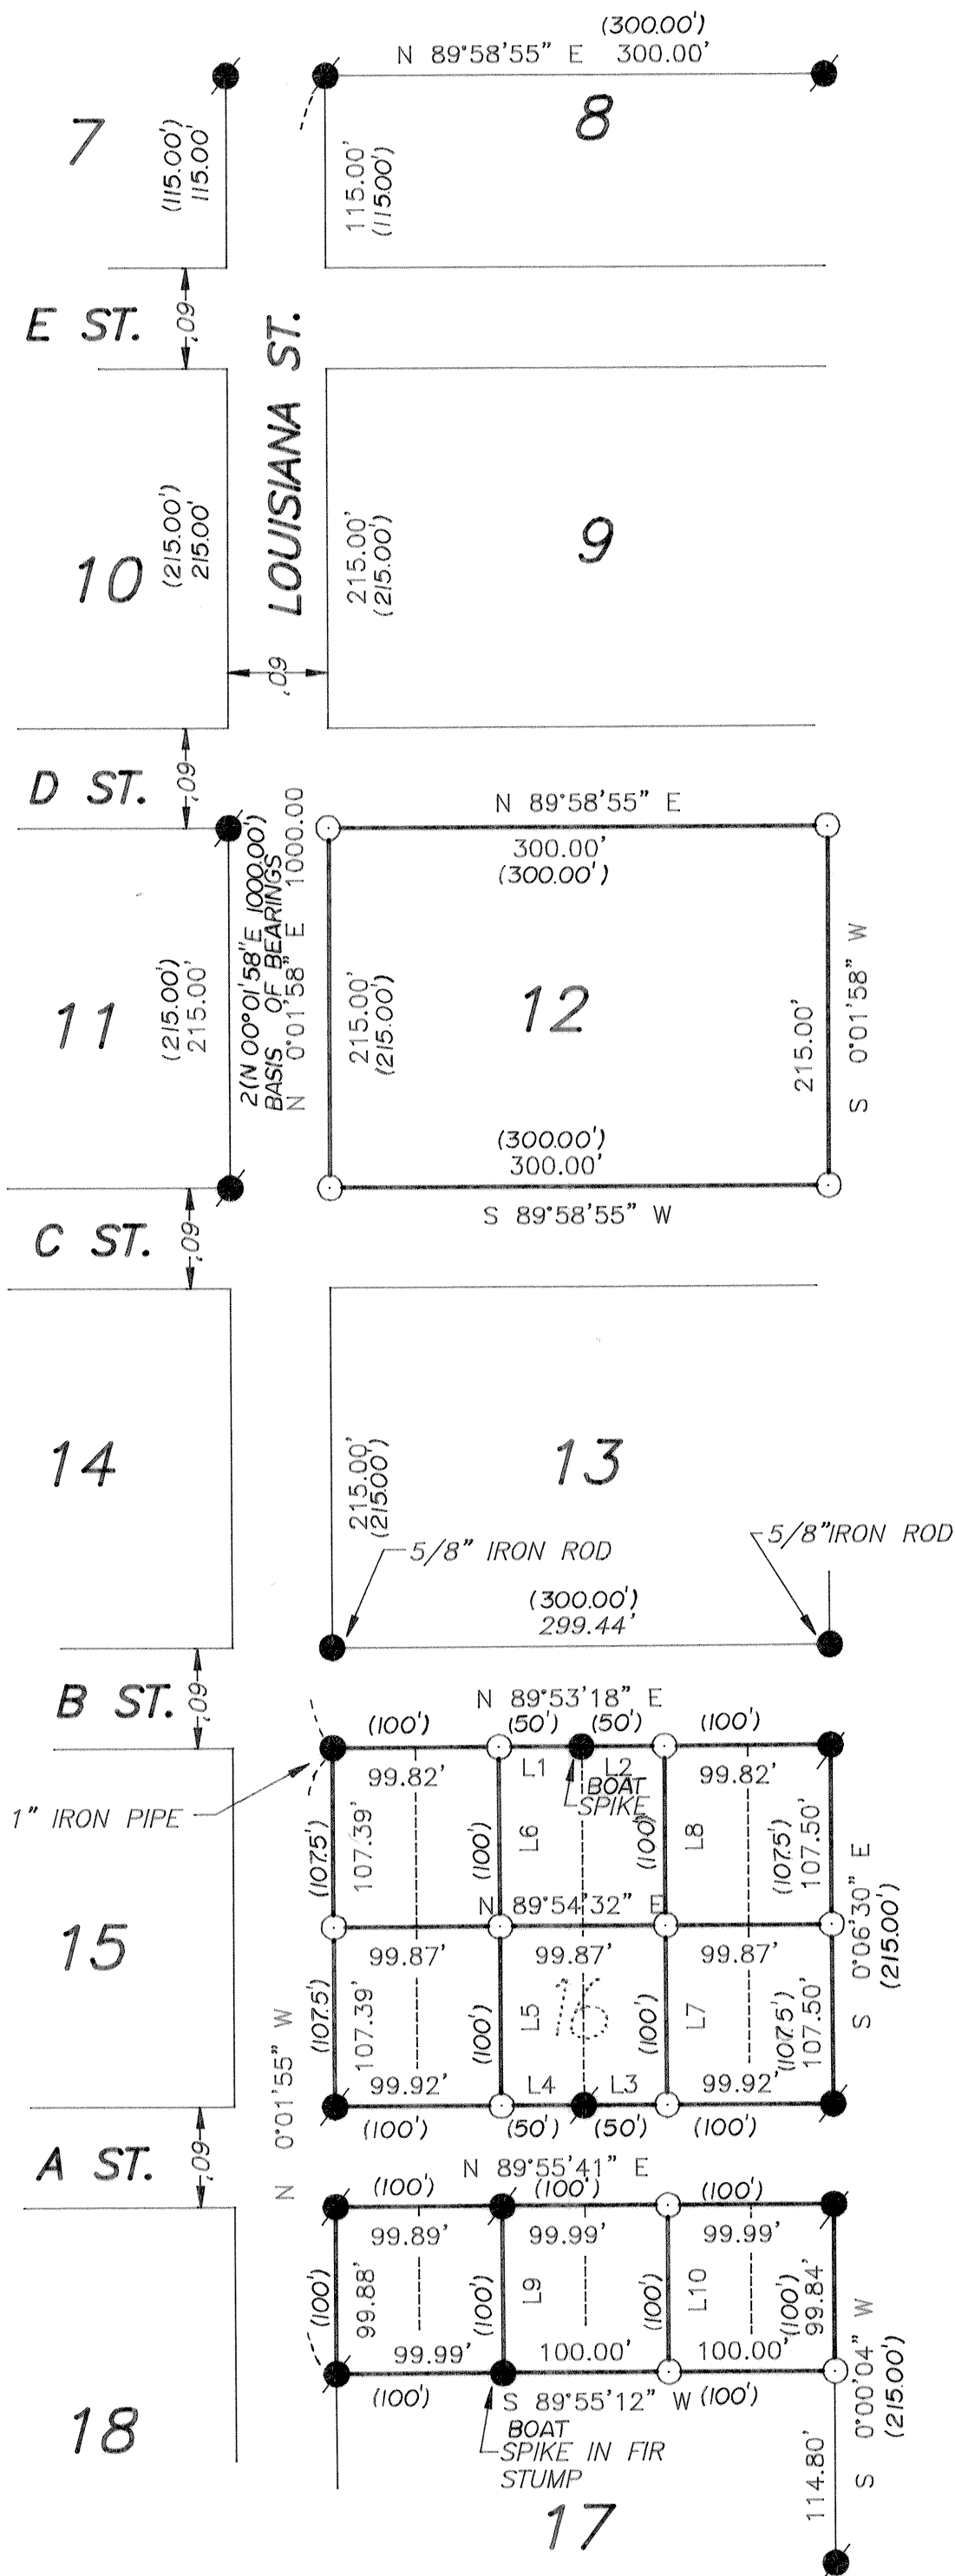


RECORD OF SURVEY
FOR ZEKE MIYASAKI AND EDNA LINN
IN BLOCKS 12, 16, AND 17, FIRST ADDITION TO VERNONIA
IN THE NE 1/4 OF SEC 4 T4N, R4W, W.M.
COLUMBIA COUNTY, OREGON
SCALE 1" = 100' OCT 25, 1994

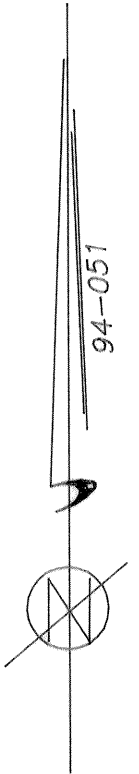

NARRATIVE

THIS SURVEY WAS ACCOMPLISHED AT THE REQUEST OF ZEKE MIYASAKI AND MRS LINN TO MONUMENT THE CORNERS OF THE LOTS AS SHOWN.

THE BEARINGS ARE BASED ON RS 3908, FROM THE EAST LINE OF LOUISIANA ST. BETWEEN THE NW CORNER OF BLOCK 16 AND THE SW CORNER OF LOT 6, BLOCK 8.

PROCEDURE

1. I HELD THE MONUMENTS AS FOUND IN BLOCK 16 AND 17, FIRST ADDITION TO VERNONIA AS PER RS 3605.
2. HELD THE MONUMENTS AS FOUND IN BLOCK 8 AND 11, FIRST ADDITION TO VERNONIA AS PER RS 3908.
3. I HELD THE NORTH AND SOUTH LINES OF BLOCK 12 PARALLEL TO THE E-W LINE IN BLOCK 8.
4. I ESTABLISHED THE EAST LINE IN BLOCK 12 AT THE PLATTED DISTANCE (300') FROM THE EAST LINE OF LOUISIANA ST.

LEGEND


- = FOUND A 5/8" IRON ROD WITH KEENON CAP
- = MONUMENT FOUND AS NOTED
- = SET A 5/8" X 30" IRON ROD WITH A YELLOW PLASTIC CAP MARKED "KEENON LAND SERVICES INC."
- () = RECORD DATA 1 = PLAT OF FIRST ADDITION TO VERNONIA
2 = RS 3908
- RS = RECORD SURVEY NO.

LINE TABLE

LINE	BEARING	DISTANCE
1	N 89°53'18" E	49.90'
2	N 89°53'18" E	49.91'
3	S 89°55'41" W	49.96'
4	S 89°55'41" W	49.96'
5	N 0°03'27" W	107.43'
6	N 0°03'27" W	107.43'
7	N 0°04'58" W	107.46'
8	N 0°04'58" W	107.46'
9	N 0°01'15" W	99.87'
10	N 0°00'36" W	99.86'

REGISTERED
 PROFESSIONAL
 LAND SURVEYOR

 OREGON
 JULY 30, 1976
 LESLIE G. KEENON
 1080
 RENEWAL DATE 6/30/95

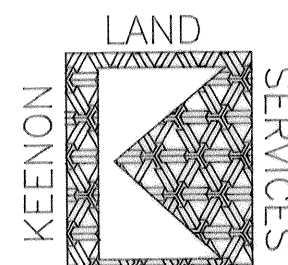

1224 ALDER ST.
 VERNONIA, OR
 97064
 (503) 429-6115

COLUMBIA COUNTY SURVEYORS OFFICE
 RECEIVED 11-15-94
 ACCEPTED FOR FILING 5-11-95