


4164

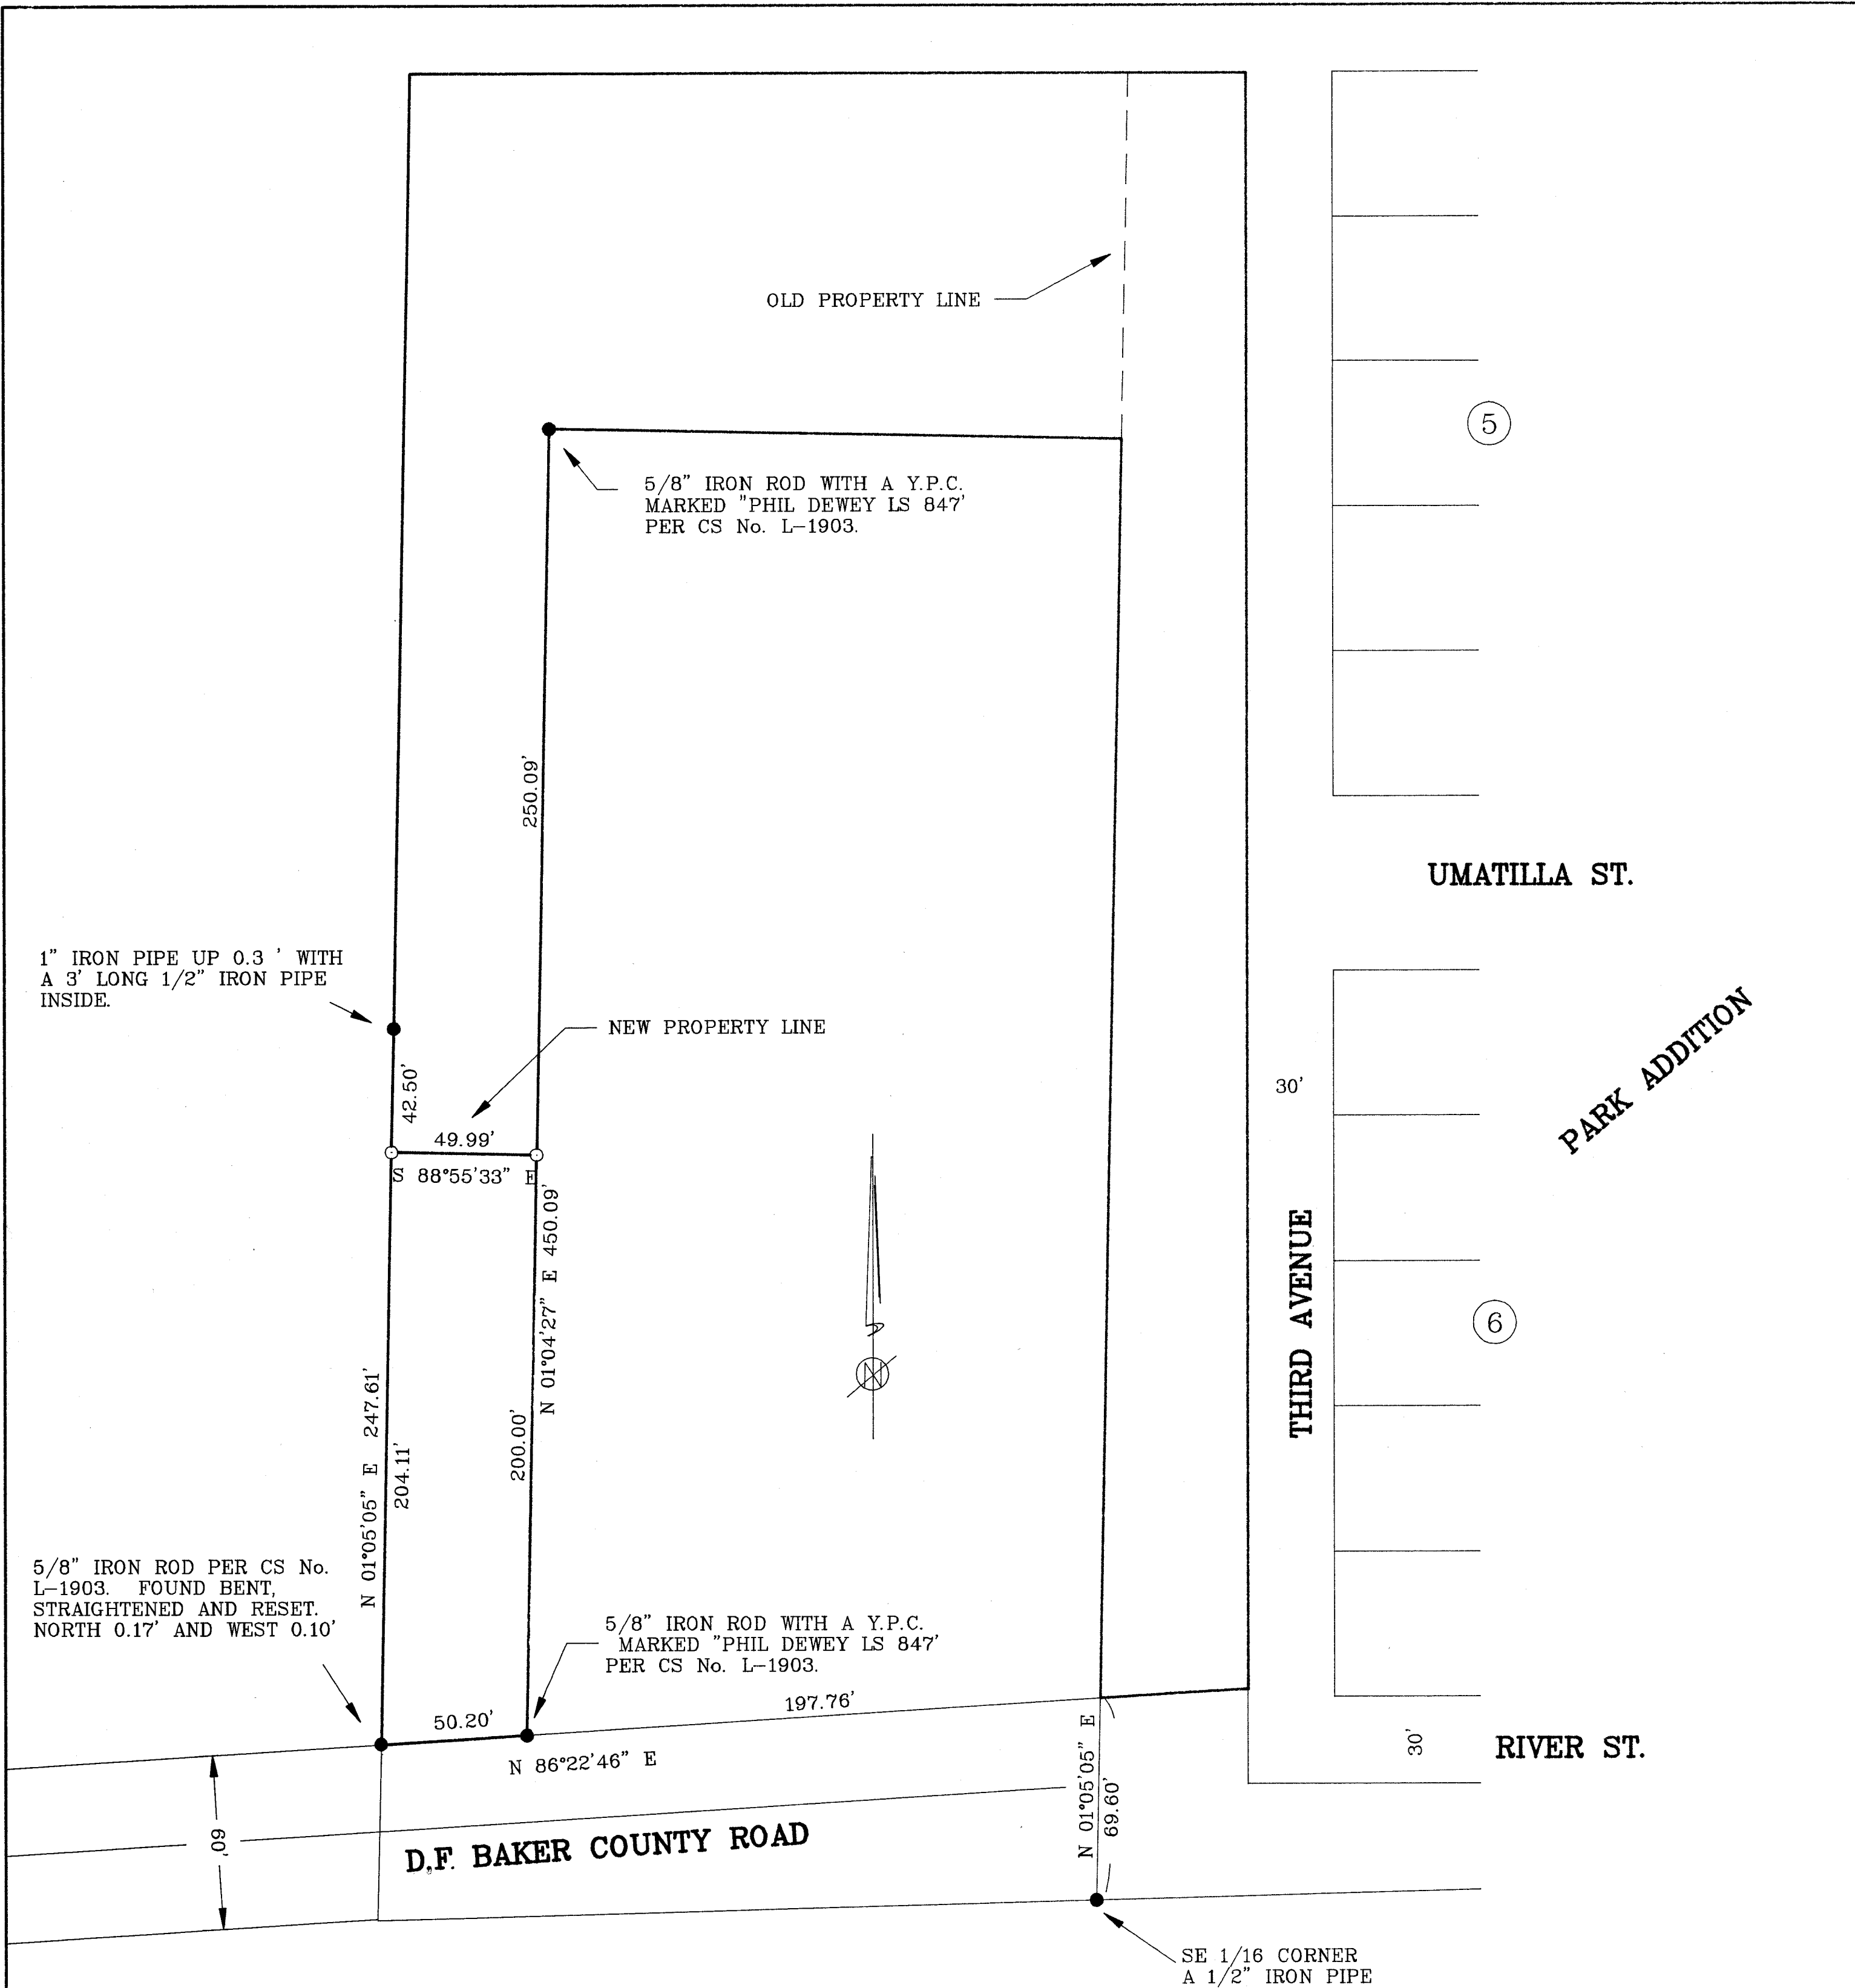

NARRATIVE:

THIS SURVEY WAS ACCOMPLISHED AT THE REQUEST OF JOE AND SUSAN HULT TO MONUMENT A PROPERTY LINE ADJUSTMENT. FOR CONTROL I HELD THE MONUMENTS OF RECORD AS SHOWN PER CS No. L-1903 AND B-161. THE

--BEARING ARE BASED ON CS No. B-161 BETWEEN THE 5/8' IRON RODS ON THE EAST LINE OF THE TRACT AS SHOWN.

LEGEND

- = MONUMENT FOUND AS NOTED
- = SET A 5/8" X 30" IRON ROD WITH A YELLOW PLASTIC CAP MARKED "KEENON LAND SERVICES INC"
- () = RECORD DATA 1 = CS No. A-1009
2 = CS No.
- CS = RECORD SURVEY No.
- Y.P.C. = YELLOW PLASTIC CAP

**PROPERTY LINE ADJUSTMENT
FOR JOE AND SUSAN HULT
IN THE SE 1/4 OF SECTION 5,
T4S, R4W, W.M.
COLUMBIA COUNTY, OREGON
SCALE 1" = 40' MAY 21, 1996**

REGISTERED
PROFESSIONAL
LAND SURVEYOR
Leslie G. Keenon
OREGON
JULY 30, 1976
LESLIE G. KEENON
1080
RENEWAL DATE 6/30/97

LAND
SERVICES
KEENON
1224 ALDER ST
VERNONIA, OR
97064
(503) 429-6225

COLUMBIA COUNTY SURVEYORS OFFICE
RECEIVED 7-18-96
ACCEPTED FOR FILING 9-27-96
CHECK No.

DRAWN BY: DON W. CHECKED BY: REVISED: JOB No. 96-015