
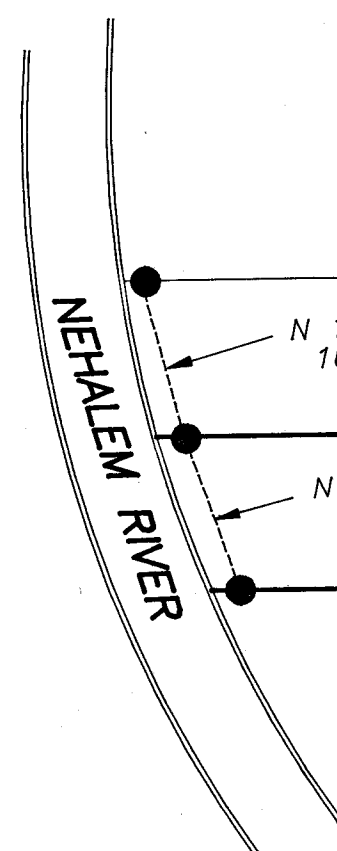


NARRATIVE:

THE PURPOSE OF THIS SURVEY WAS TO LOCATE THE PROPERTY CORNERS AS CALLED FOR IN BOOK 195 PAGE 564, COLUMBIA COUNTY, DEED RECORDS.

I HELD THE IRON PIPE AT THE NORTH QUARTER CORNER AND THE LINE TO THE IRON ROD AT THE CENTER NORTH ONE SIXTEENTH FOR THE EAST LINE OF THE NORTHWEST QUARTER OF THE SECTION AND SET THE SOUTHEAST CORNER OF THE PARCEL AT DEEDED DISTANCE FROM THE NORTH QUARTER CORNER. HELD THE MONUMENTS PER CS No. 1025 AS FOUND.

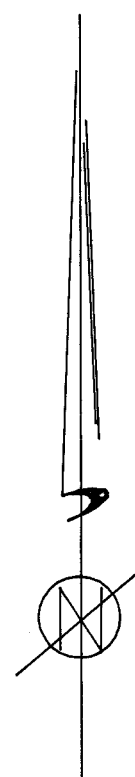

1 (N 89°17' E 1413.85')
N 89°14'53" E 1414.08'

N 15°25'41"W
167.82'

1 (N 89°17' E 1364.00')
N 89°14'35" E 1363.85'

BOOK 195 PAGE 564

N 19°49'23"W
171.61'

1 (N 89°17' E 1300.45')
N 89°15'05" E 1300.36'

12
13
1/4 CORNER
1" IP UP 30"

1 (670.00')
S 1°56'29" W 670.03'

1 (162.50')
S 1°56'12" W 162.41'

1 (162.50')
S 1°51'47" W 162.56'

1 (319.82')
S 1°56'00" W 319.91'

S 1°56'00" W 1314.91'
1 (S 1°56'00" W 1314.82')
2 (S 1°55'50" W 1315.08')

CN 1/16 5/8" IRON ROD
PER CS 1025 AND CS 3620
12" FIR S17°W 25.9'
28" QUADRUPLE FIR S66°E 9.5'

LEGEND

- = FOUND 5/8" IRON ROD UNLESS OTHERWISE NOTED
- = SET A 5/8" X 30" IRON ROD WITH A YELLOW PLASTIC CAP MARKED "KEENON LAND SERVICES INC."


() = RECORD DATA 1 = CS 1025
2 = CS 3620

CS = RECORD SURVEY NO.
Y.P.C. = YELLOW PLASTIC CAP

RECORD OF SURVEY
FOR FRANCIS L. KLINK
IN THE NW 1/4 OF SEC 13,
T4N, R5W, W.M.,
COLUMBIA COUNTY, OREGON
SCALE 1" = 200' NOVEMBER 20, 1995

REGISTERED
PROFESSIONAL
LAND SURVEYOR

OREGON
JULY 30, 1976
LESLIE G. KEENON
1080
RENEWAL DATE 6/30/97

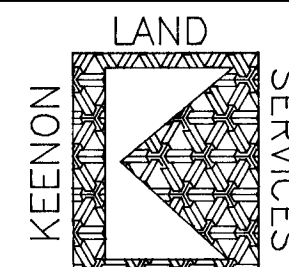

1224 ALDER ST.
VERNONIA, OR
97064
(503) 429-6115

COLUMBIA COUNTY SURVEYORS OFFICE
RECEIVED 12-21-95
ACCEPTED FOR FILING 1-3-96
CHECK No. 4353

DRAWN BY: M. M. CHECKED BY: REVISED: JOB No. 95-057