
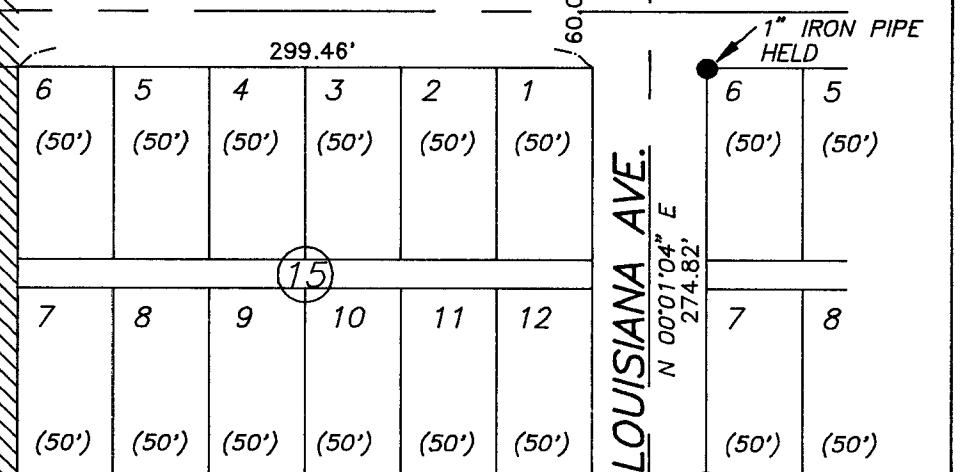
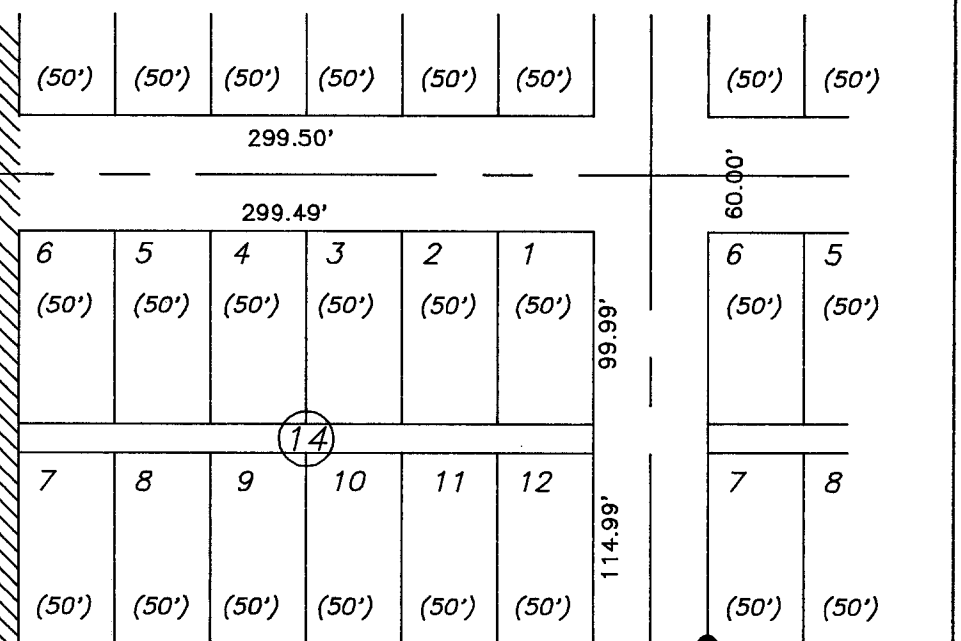
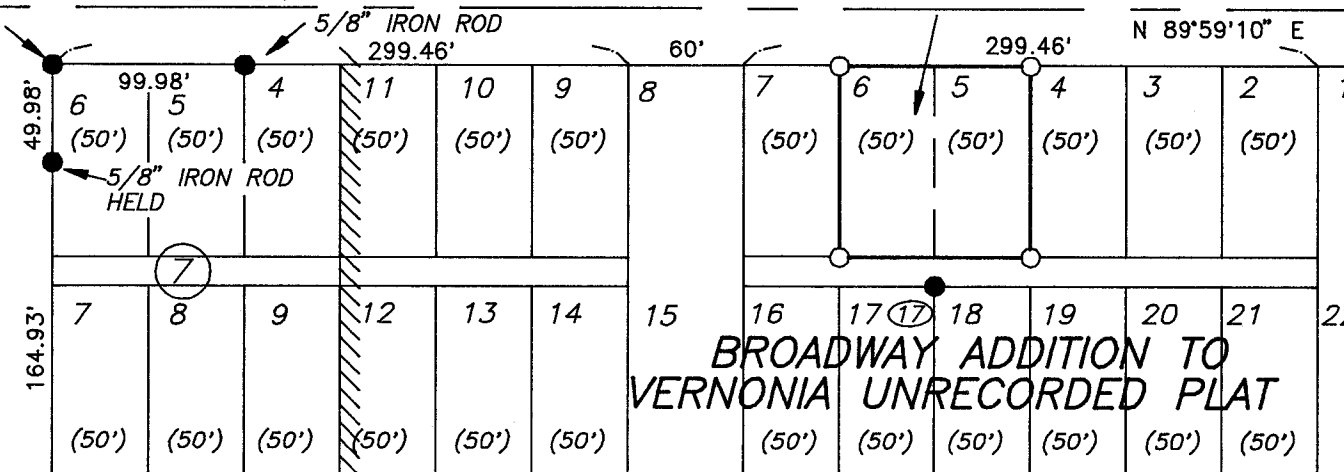
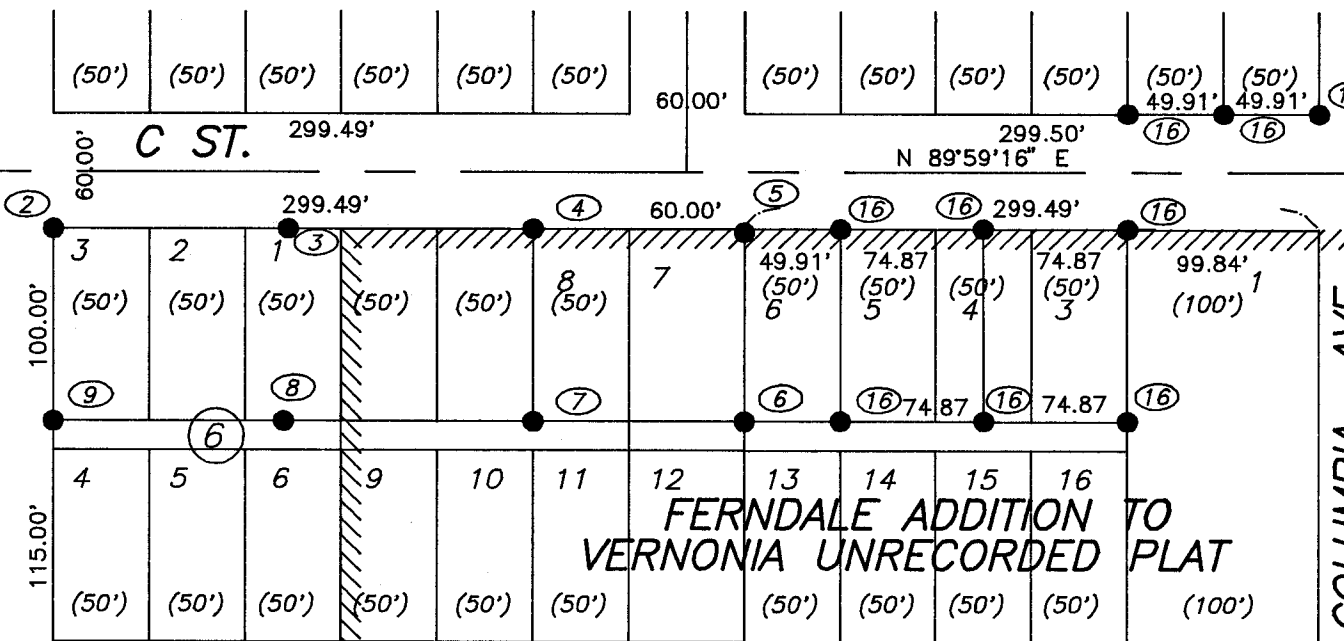
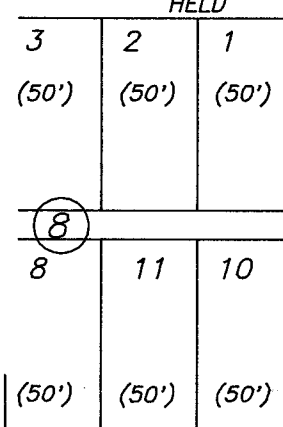
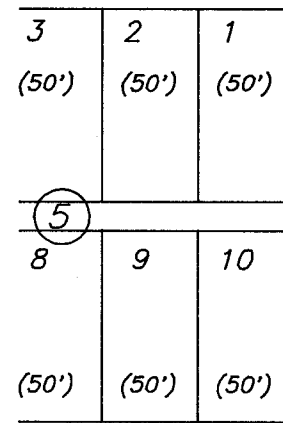


DETAIL
SCALE 1" = 50'

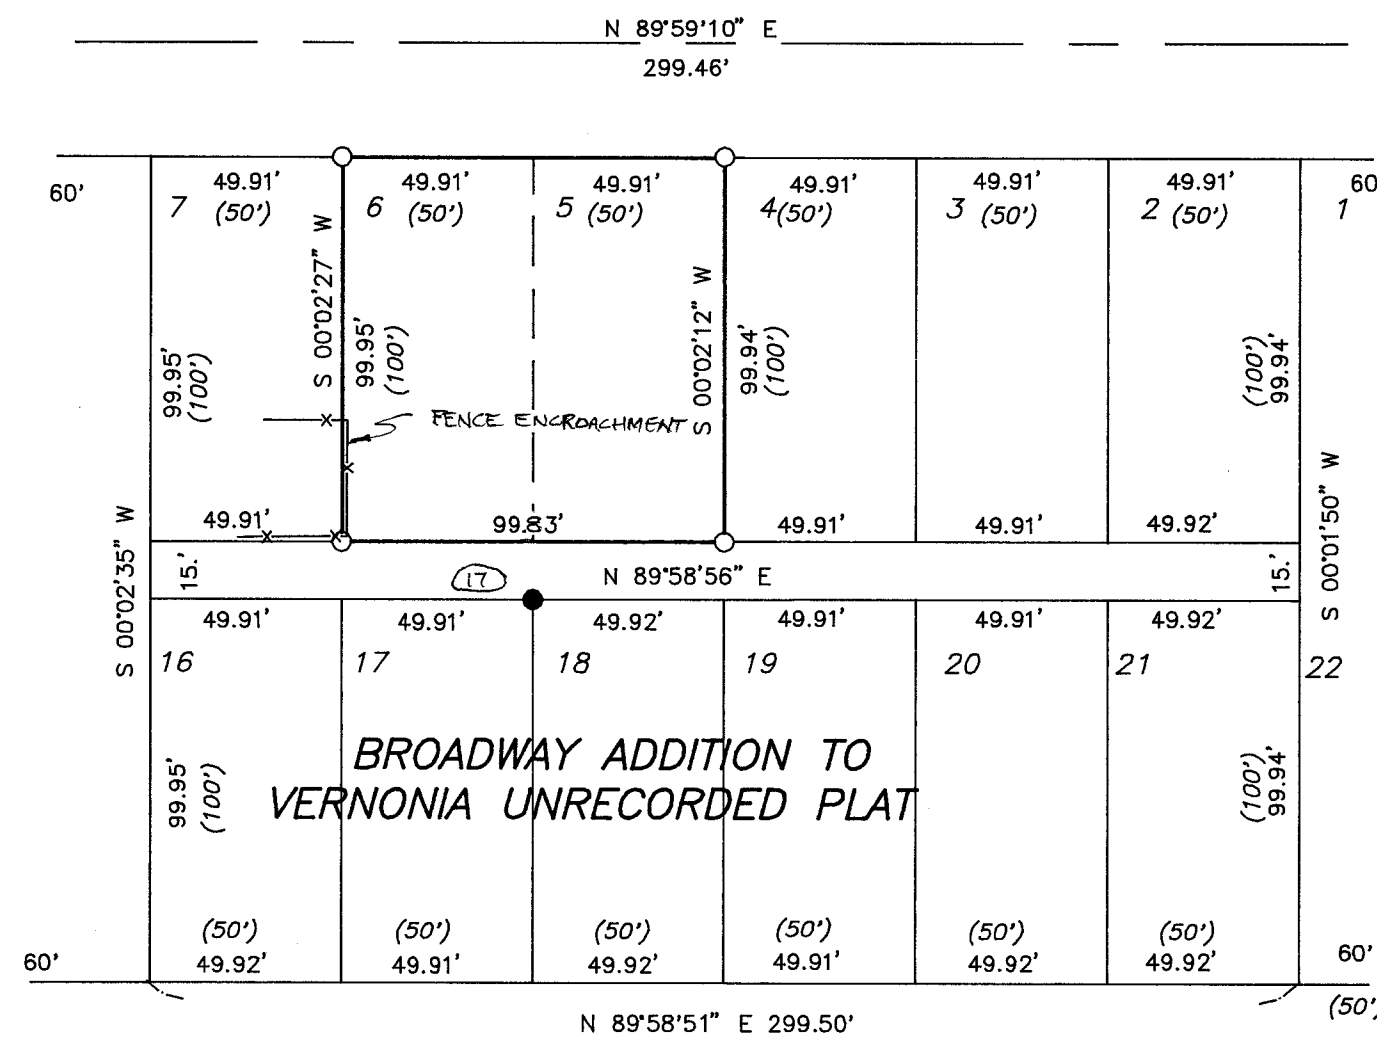

CORNER NOTES

- 5/8" IRON ROD WITH A Y.P.C. MARKED "KEENON LAND SERVICES INC." PER CS No. 3908.
- 5/8" IRON ROD WITH A Y.P.C. MARKED "KEENON LS 1080" PER CS No. L-2118.
- 5/8" IRON ROD WITH A Y.P.C. MARKED "KEENON LS 1080" PER CS No. L-2118. S 0.21' E 0.20'.
- 1/2" IRON ROD ORIGIN UNKNOWN S 0.34' W 0.18'.
- 5/8" IRON ROD WITH A Y.P.C. MARKED "KEENON LS 1080" PER CS No. B-82. S 0.49' E 0.53'.
- 5/8" IRON ROD WITH A Y.P.C. MARKED "KEENON LS 1080" PER CS No. B-82. S 0.55' E 0.52'.
- 5/8" IRON ROD WITH A Y.P.C. MARKED "KEENON LS 1080" PER CS No. B-82. S 0.36' E 0.41'.
- 5/8" IRON ROD WITH A Y.P.C. MARKED "KEENON LS 1080" PER CS No. L-2118. S 0.19' E 0.17'.
- 5/8" IRON ROD WITH A Y.P.C. MARKED "KEENON LS 1080" PER CS No. 3908. E 0.40' S 0.06'.
- 5/8" IRON ROD WITH A Y.P.C. MARKED "KEENON LS 1080" PER CS No. 3908. E 0.04'.
- 5/8" IRON ROD WITH A Y.P.C. MARKED "KEENON LS 1080" PER CS No. 3908.
- 5/8" IRON ROD PER CS No. L-556. S 0.20' E 0.46'.
- 5/8" IRON ROD N 0.68' W 1.41'.
- 5/8" IRON ROD PER CS No. L-1207. S 0.40' W 0.06'.
- 5/8" IRON ROD PER CS No. L-1207. S 0.29' W 0.03'.
- 5/8" IRON ROD WITH A Y.P.C. MARKED "KEENON LS 1080" PER CS No. 4094.
- 5/8" IRON ROD WITH A Y.P.C. MARKED "DEWEY SURVEYING INC" PER CS No. 3945.

NARRATIVE:

THIS SURVEY WAS ACCOMPLISHED AT THE REQUEST OF DOROTHY HASS TO MONUMENT LOTS 5 & 6, IN BROADWAY ADDITION AND UNRECORDED PLAT TO VERNONIA. THE BASIS OF BEARINGS IS FROM CS 3908. FOR CONTROL I HELD THE MONUMENTS AS SHOWN AND PROPORTIONED BETWEEN THE HELD MONUMENTS TO ESTABLISH THE PROPERTY CORNERS SET.

A NEWLY CONSTRUCTED FENCE ENCROACHES INTO LOT 6, FROM LOT 7, APPROXIMATELY 18" (SEE DETAIL).



LEGEND

- = MONUMENT FOUND AS NOTED
- = 1/2" IRON PIPE, ORIGIN UNKNOWN HELD
- = SET A 5/8" X 30" IRON ROD WITH A Y.P.C. MARKED "KEENON LAND SERVICES INC."
- () = RECORD PLAT DATA
- CS = RECORD SURVEY NO.
- Y.P.C. = YELLOW PLASTIC CAP

1 1/2" IRON PIPE
INITIAL POINT TO WEST'S
ADDITION TO VERNONIA
(HELD)

5/8" IRON ROD WITH A
Y.P.C. MARKED "SUMMERS
LS 1085' PER SN L-1042.
(HELD)

5/8" IRON ROD WITH A
Y.P.C. MARKED "SUMMERS
LS 1085' PER SN L-1042.
(HELD)

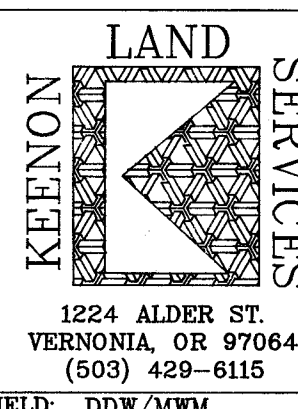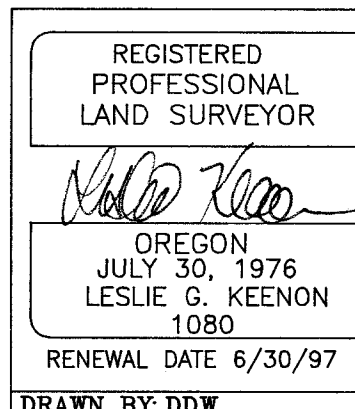

SURVEY FOR
DOROTHY HASS
IN BROADWAY ADDITION TO VERNONIA
IN THE NW 1/4 OF SECTION 4,
T4N, R4W, W.M.
COLUMBIA COUNTY, COLUMBIA COUNTY
SCALE 1" = 100 MAY 12, 1997

COLUMBIA COUNTY
SURVEYORS OFFICE
RECEIVED 6-3-97
ACCEPTED 7-23-97
CHECK # 175

DRAWN BY: DDW

FIELD: DDW/MWM

EQUIPMENT: GTS300/TDS48

JOB No. 97-074

PROJECT No. 96-102

REVISED:

4320