


PROPERTY SURVEY FOR
WALTER & JEAN WORKMAN
in the SW 1/4 NW 1/4, & NW 1/4 SW 1/4 of
SECTION 8, TWP 4N, RGE 4W, W.M.
COLUMBIA COUNTY, OREGON

DATE OF COMPLETION
4-7-84
SCALE 1" = 200'

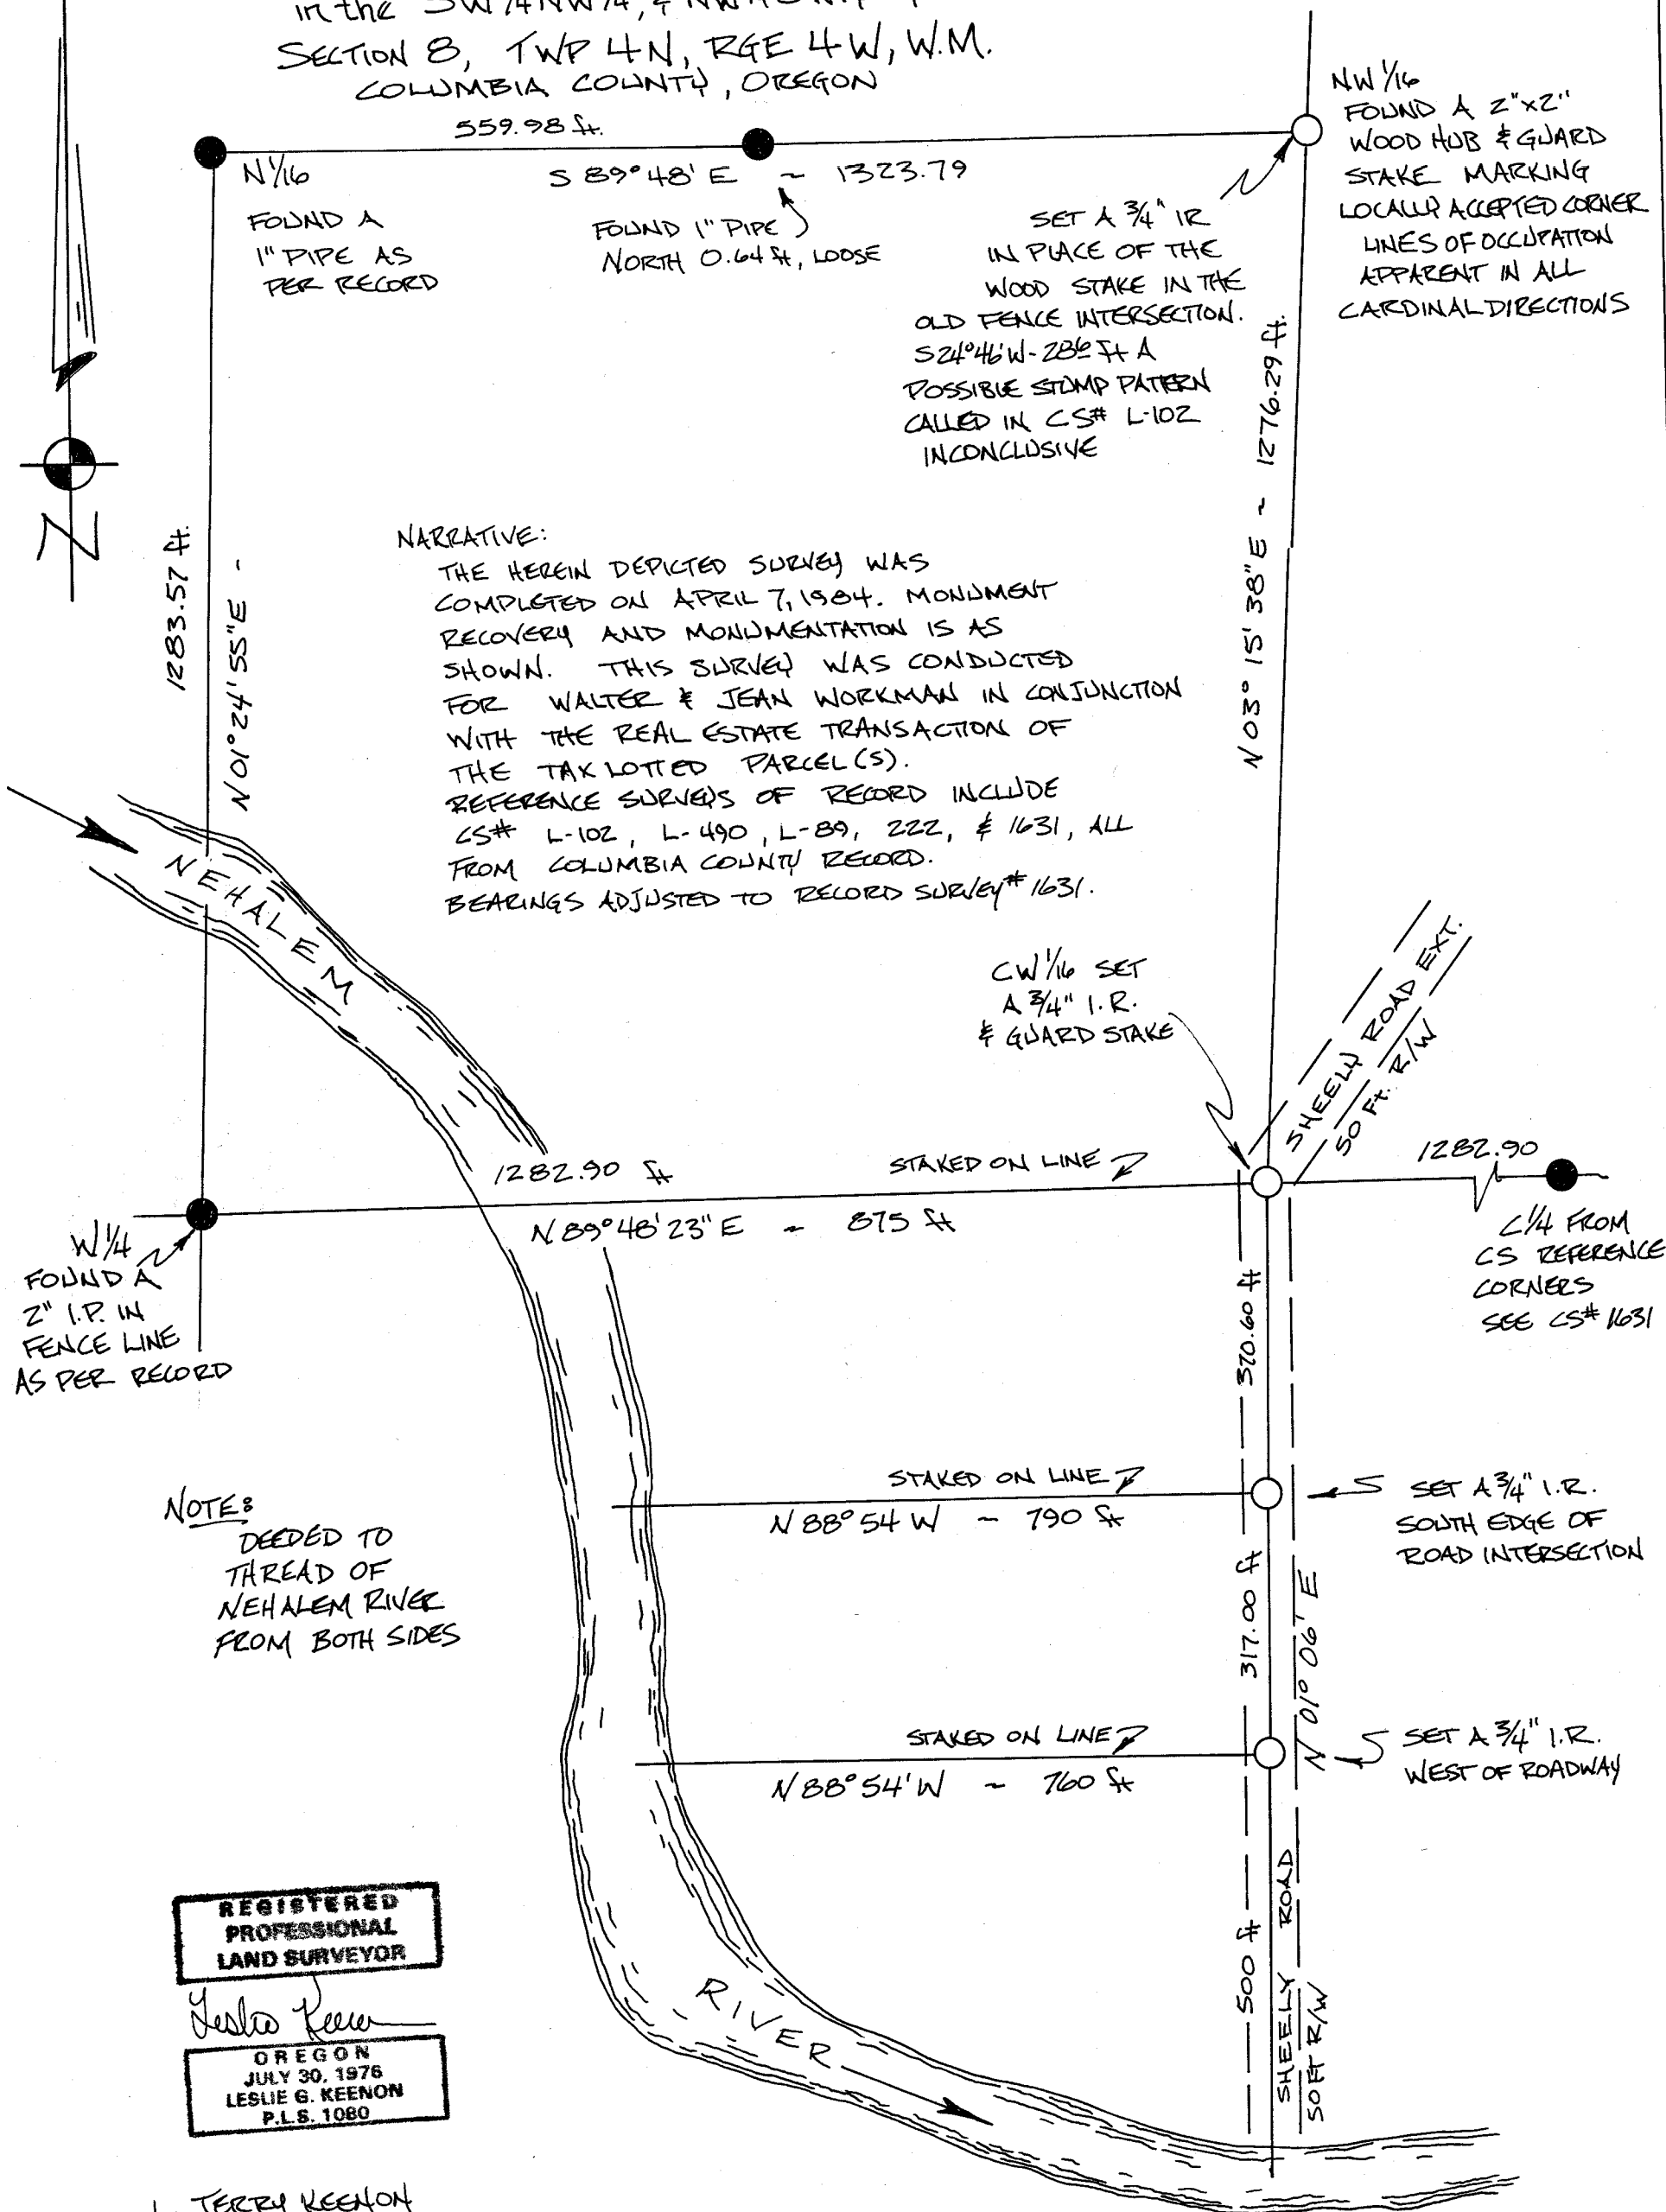

NARRATIVE:

THE HEREIN DEPICTED SURVEY WAS COMPLETED ON APRIL 7, 1984. MONUMENT RECOVERY AND MONUMENTATION IS AS SHOWN. THIS SURVEY WAS CONDUCTED FOR WALTER & JEAN WORKMAN IN CONJUNCTION WITH THE REAL ESTATE TRANSACTION OF THE TAX LOTTED PARCEL(S). REFERENCE SURVEYS OF RECORD INCLUDE CS# L-102, L-490, L-89, 222, & 1631, ALL FROM COLUMBIA COUNTY RECORD. BEARINGS ADJUSTED TO RECORD SURVEY# 1631.

NOTE:

DEEDED TO
THREAD OF
NEHALEM RIVER
FROM BOTH SIDES

REGISTERED
PROFESSIONAL
LAND SURVEYOR

Leslie Keenon
OREGON
JULY 30, 1976
LESLIE G. KEENON
P.L.S. 1080

L. JERRY KEENON
1311 E. ALDER
VERNONIA, OREGON
97064

COUNTY SURVEYOR

RECEIVED 7-18-84
FILED 7-18-84