

191-8

B-161

# RECORD OF SURVEY for HOLCE LOGGING CO. IN THE NW 1/4 OF THE SE 1/4 OF SEC. 5, T4N, R4W, WM. COLUMBIA COUNTY, OREGON SCALE 1"=200' AUG. 17, 1992


NARRATIVE: THE PURPOSE OF THIS SURVEY WAS TO MARK AND MONUMENT THAT PARCEL AS DESCRIBED IN DOCUMENT NO. 91000288.

PROCEDURE

1. FOR CONTROL I HELD RS NO. L-1903
2. I RESET THE CE 1/16 AT THE RECORD LOCATION AS PER RS NO. 3054 AND L-1903.


- LEGEND
- — MONUMENT FOUND AS NOTED
  - — FOUND 5/8" IRON ROD WITH CAP AS PER RS NO. L-1903
  - — SET A 5/8"X30" IRON ROD WITH A YELLOW PLASTIC CAP MARKED "KEENON LS 1080"
  - IR — IRON ROD
  - IP — IRON PIPE
  - RS — RECORD SURVEY NO.
  - ( ) — RECORD DATA 1= RS NO. L-1903, 2= RS NO. 3054

L JERRY KEENON  
1311 ALDER ST.  
VERNONIA, OREGON 97064  
PH # 429-6115

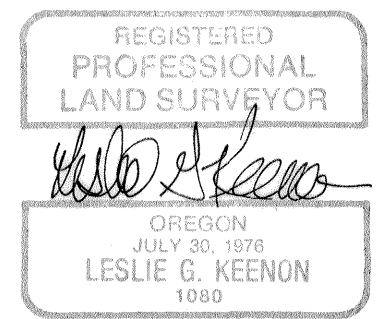

COUNTY SURVEYOR  
RECEIVED 9/25/92  
FILED 10-21-92

DRAWN BY: DON WALLACE

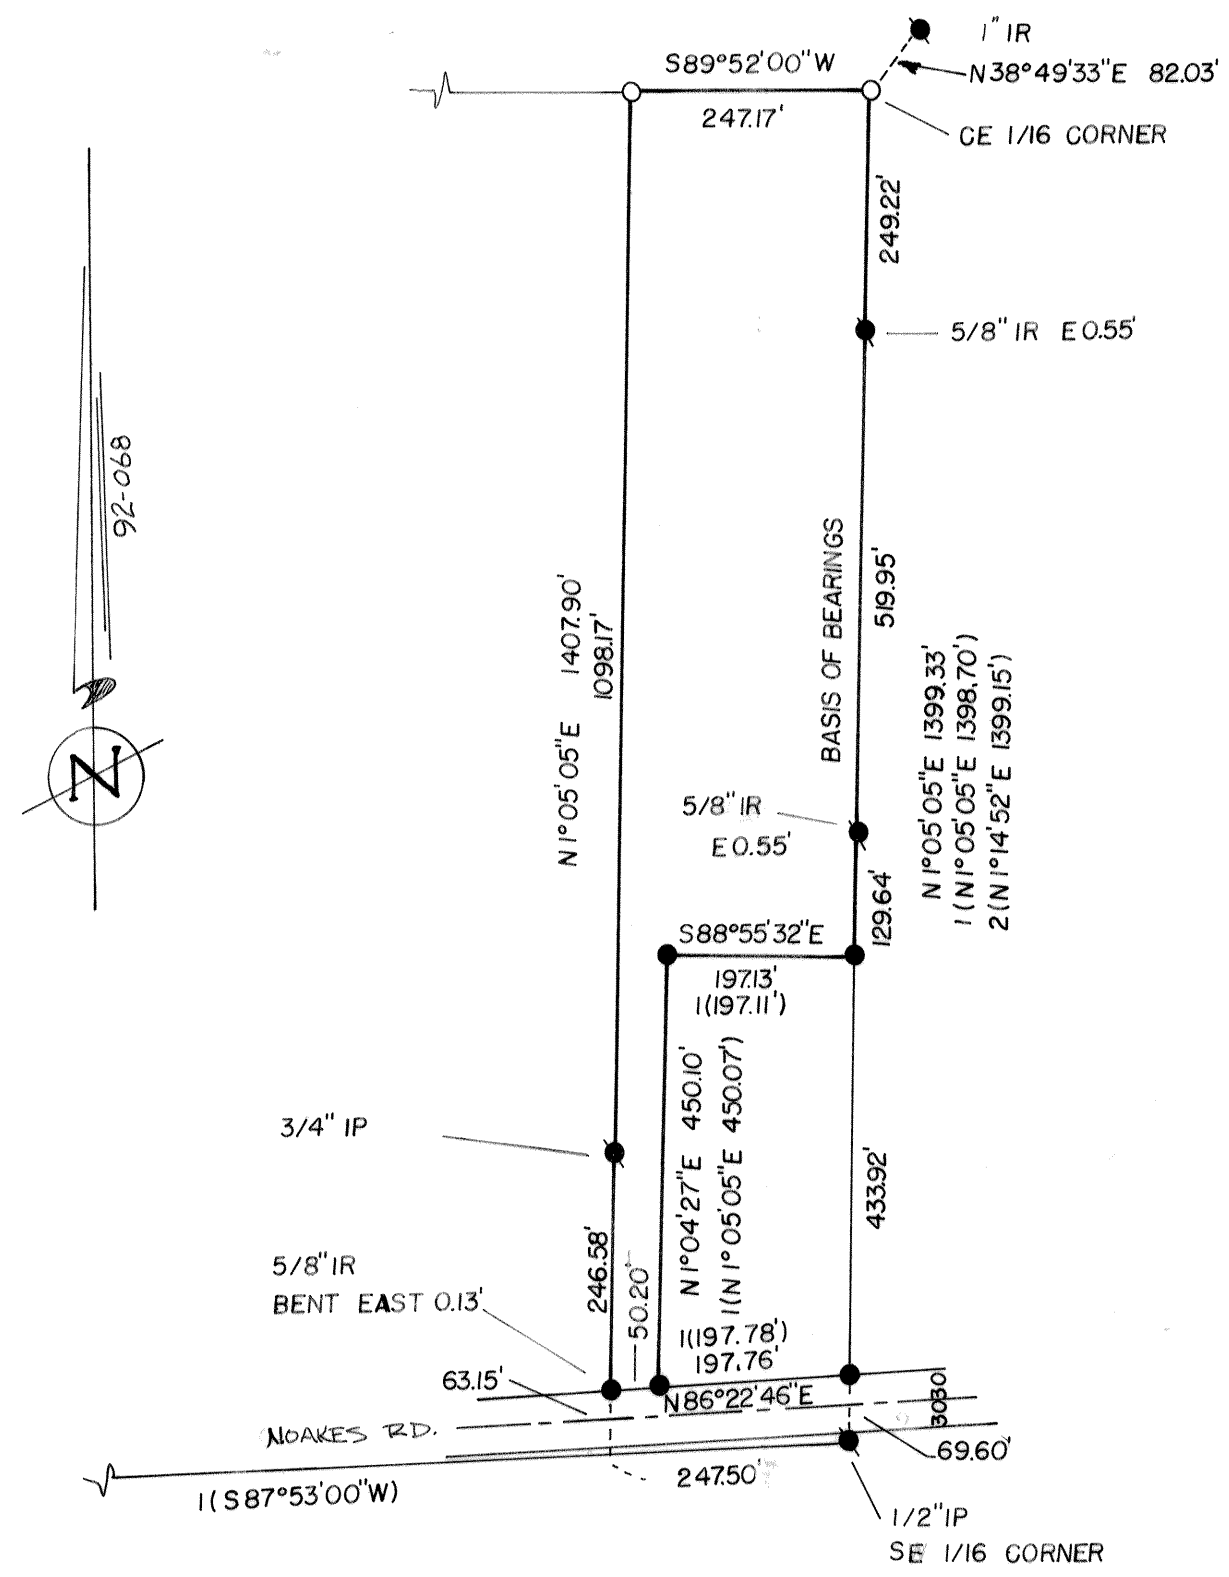

B-161

B-161