

NARRATIVE:


--THIS SURVEY WAS ACCOMPLISHED AT THE REQUEST OF JULIA COLEMAN AND DICK TITUS TO MONUMENT LOTS 1-3 & 10-12, BLOCK 5 AND LOT 3 & 4, BLOCK 13 IN SECOND ADDITION TO VERNONIA.

--THE BASIS OF BEARINGS IS FROM CS No. 4322.

--FOR CONTROL I HELD THE RECOVERED MONUMENTATION AND RECORD DATA PER CS No. 4322.

LEGEND

- = FOUND A 5/8" x 30" IRON ROD WITH A Y.P.C. MARKED "KEENON LS 1080" PER CS No. 4577.
- = FOUND A 5/8" x 30" IRON ROD WITH A Y.P.C. MARKED "KEENON LS 1080" PER CS No. 4322
- = MONUMENT FOUND AS NOTED
- = SET A 5/8" x 30" IRON ROD WITH A Y.P.C. MARKED "KEENON LAND SERVICES INC."
- () = RECORD SURVEY DATA
- CS = RECORD SURVEY No.
- Y.P.C. = YELLOW PLASTIC CAP

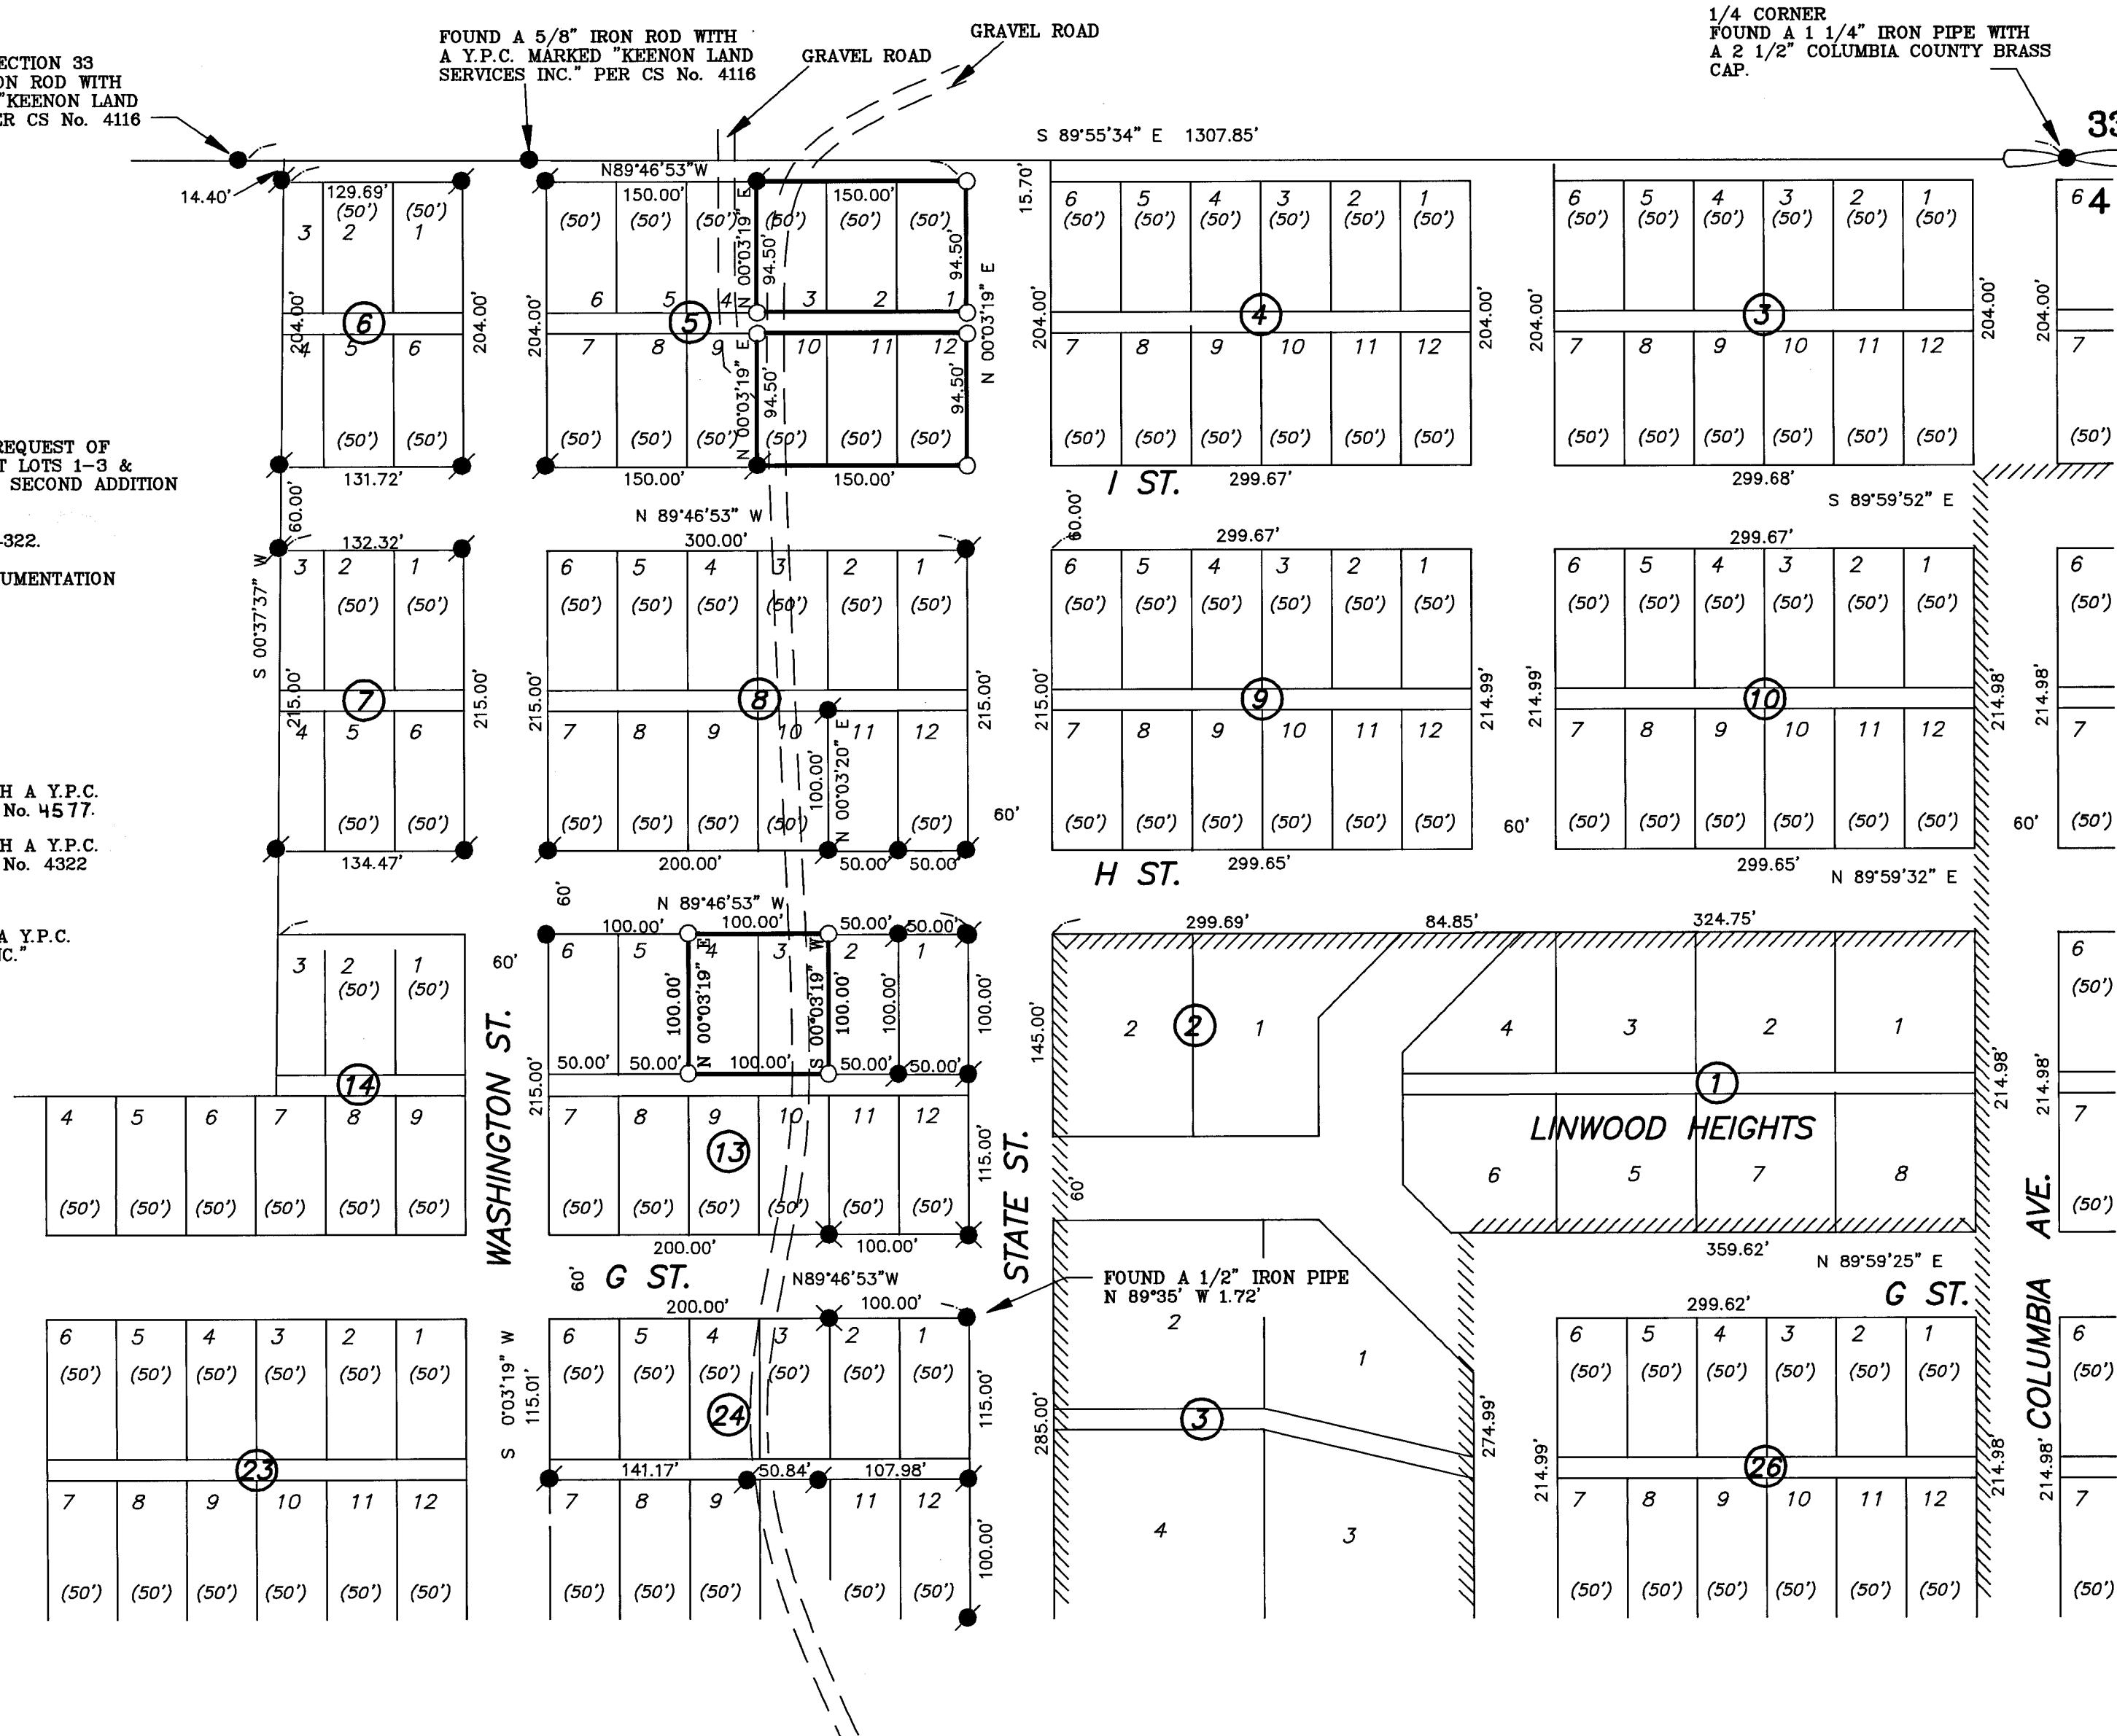

REGISTERED
PROFESSIONAL
LAND SURVEYOR
Leslie G. Keenon
OREGON
JULY 30, 1976
LESLIE G. KEENON
1080
RENEWAL DATE 6/30/99

LAND
SERVICES
KEENON
1224 ALDER ST.
VERNONIA, OR 97064
(503) 429-6115

SURVEY FOR
DICK TITUS AND JULIA COLEMAN
IN SECOND ADDITION TO VERNONIA
IN THE NW 1/4 OF SECTION 4,
T4N, R4W, W.M.
COLUMBIA COUNTY, OREGON
SCALE 1" = 100' JUNE 24, 1999

COLUMBIA COUNTY
SURVEYORS OFFICE
RECEIVED _____
ACCEPTED _____
CHECK # 380

DRAWN BY: DDW

FIELD: VSS/CM

EQUIPMENT: GTS300/TDS48

JOB No. 99-083

PROJECT No. VERNONIA

REVISED: 6/24/99