


7887

4280

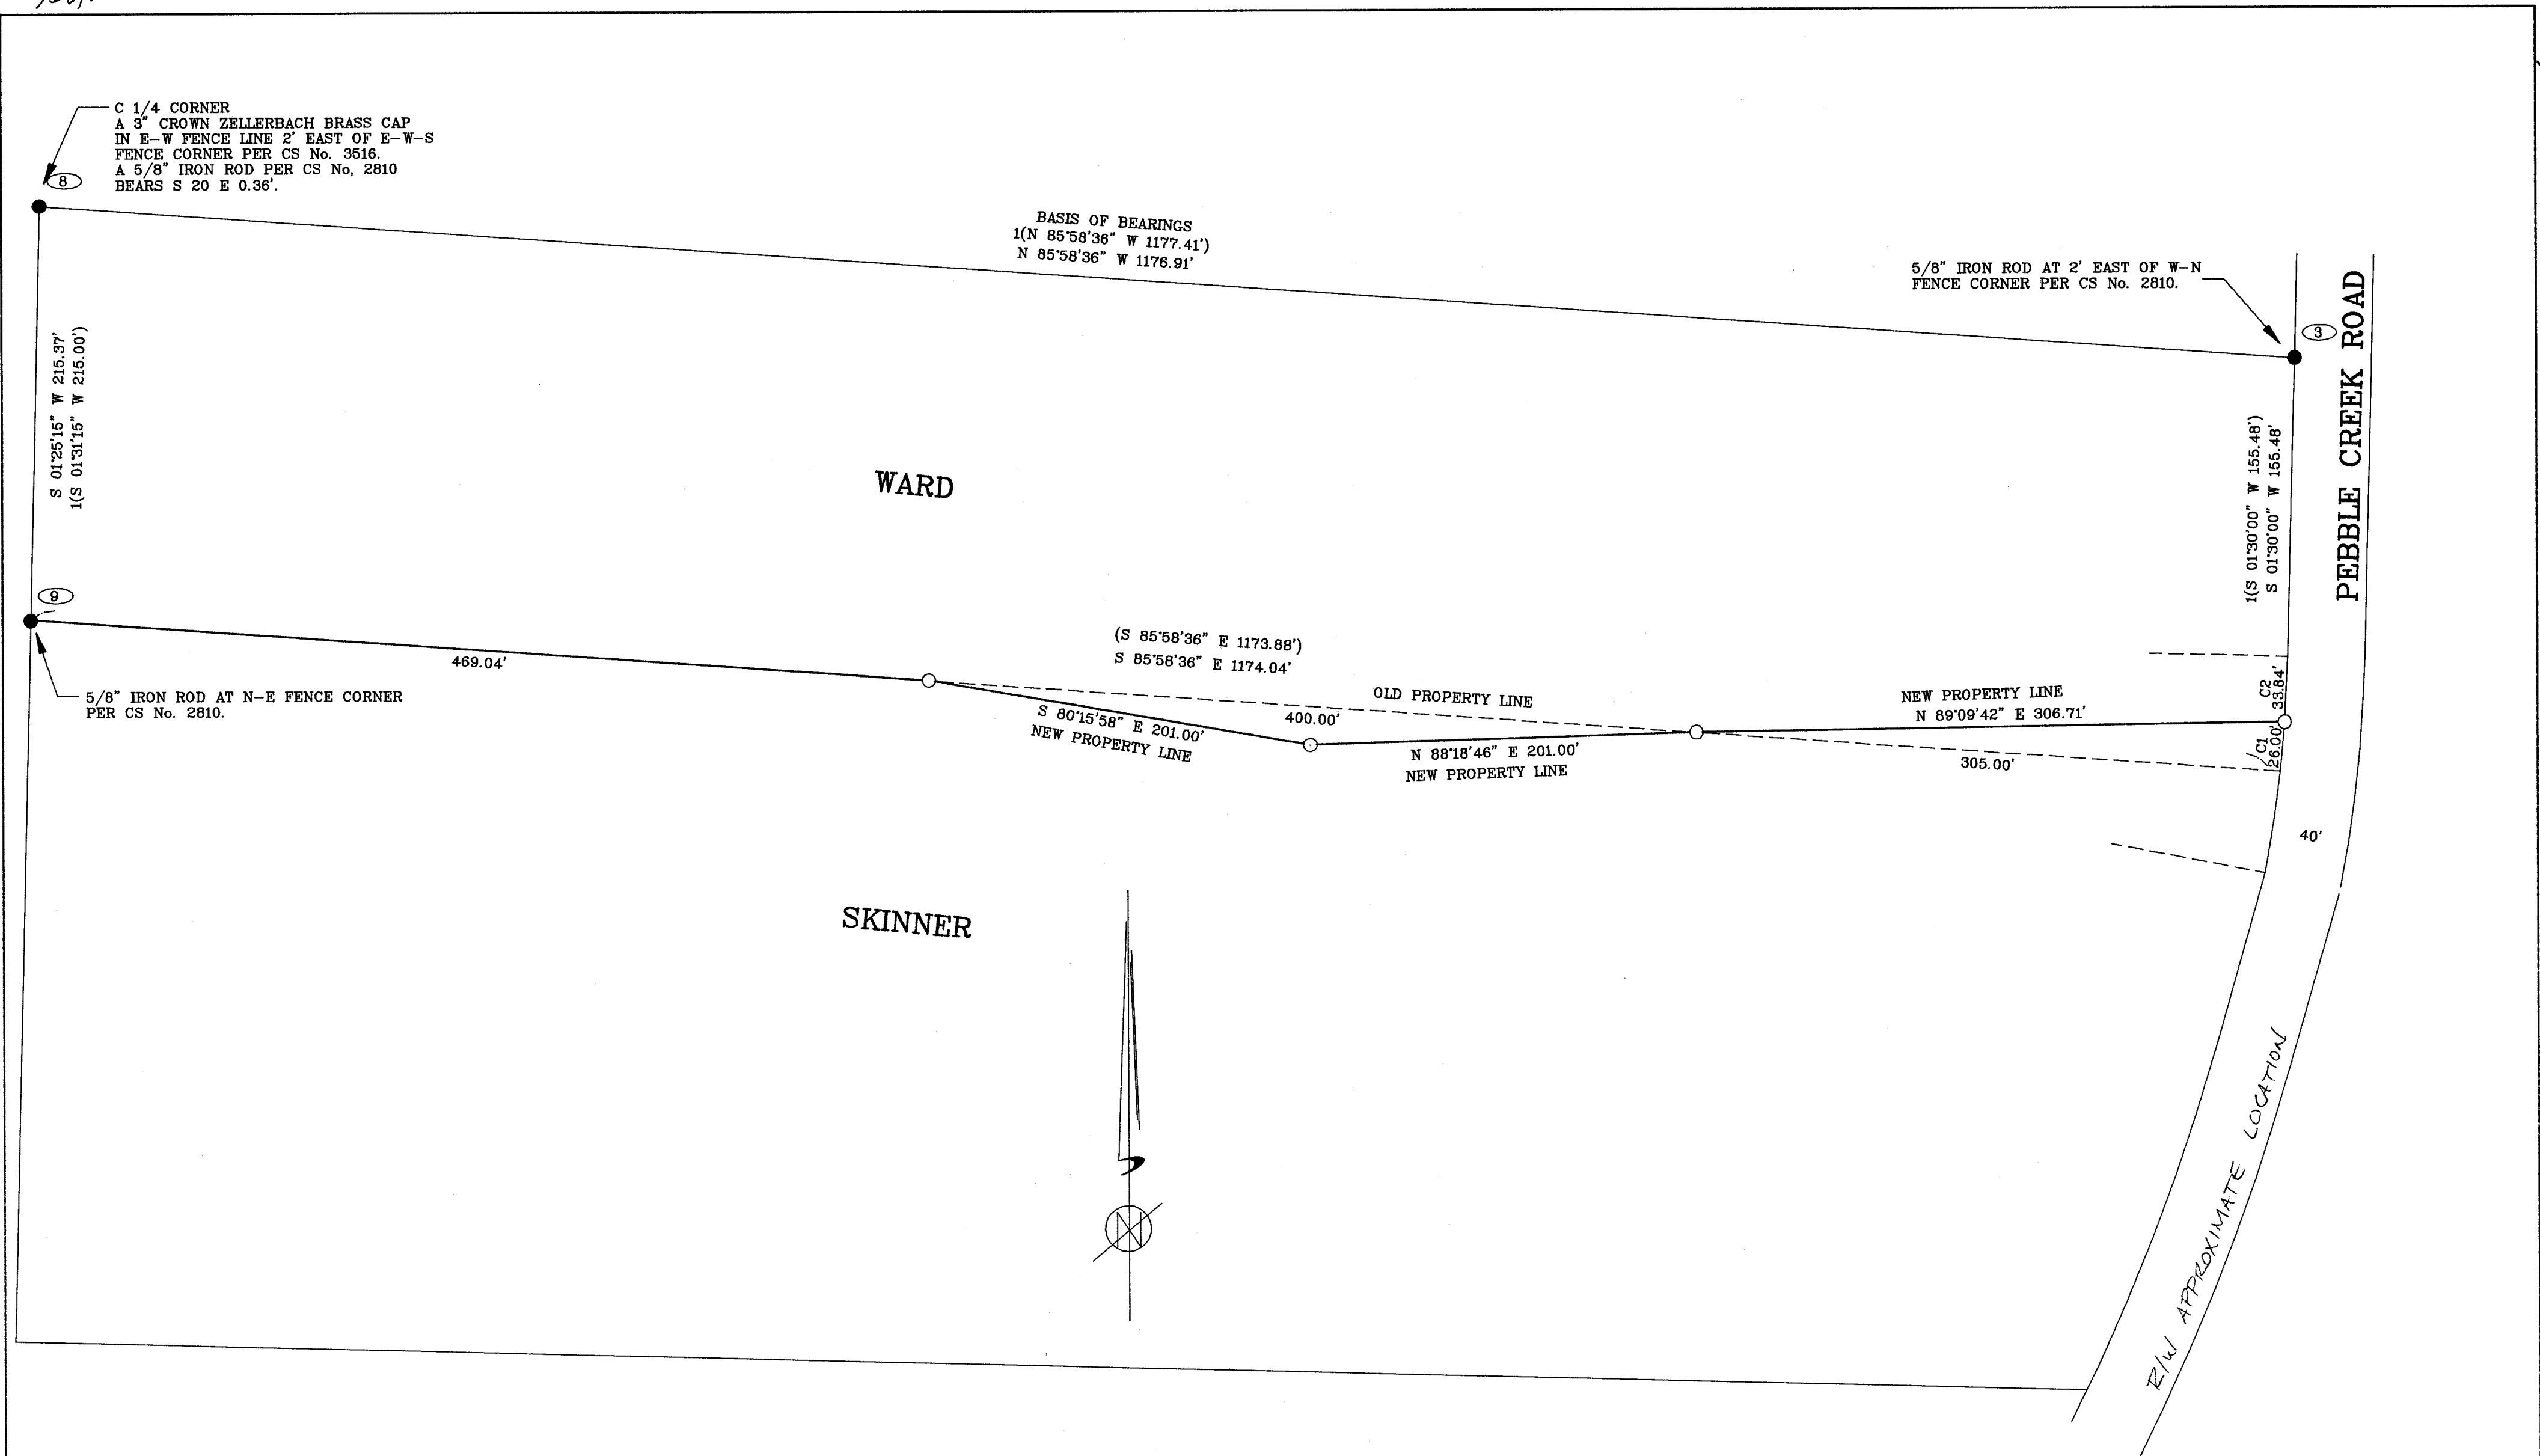

LEGEND

- = MONUMENT FOUND AS NOTED
- = SET, A 5/8"x30" IRON ROD WITH A.Y.P.C. MARKED "KEENON LAND SERVICES, INC." AND WITH A 3/4" Y.P.C. = YELLOW PLASTIC CAP
- () = RECORD SURVEY DATA
- CS = RECORD SURVEY No.
- = CONTROL POINT No.

NARRATIVE:

--THE PURPOSE OF THIS SURVEY WAS TO MONUMENT A PROPERTY LINE ADJUSTMENT BETWEEN REGGIE AND CATHERINE WARD AND DON AND NONA SKINNER.
--THE BASIS OF BEARINGS IS FROM CS No. 2810.
--CONTROL IS FROM SURVEY MONUMENTS RECOVERED AS NOTED IN CS 2810.
--THE TRIANGULAR PIECES WERE COMPUTED TO CREATE EQUAL AREAS AND THE REQUIRED SETBACK FOR THE WARD'S HOUSE.

<p>REGISTERED PROFESSIONAL LAND SURVEYOR</p> <p><i>Leslie G. Keenon</i></p> <p>OREGON JULY 30, 1976 LESLIE G. KEENON 1080 RENEWAL DATE 6/30/97</p>	<p>KEENON LAND SERVICES</p> <p>1224 ALDER ST. VERNONIA, OR 97064 (503) 429-6115</p>	<p>PROPERTY LINE ADJUSTMENT REGGIE AND CATHERINE WARD AND DON AND NONA SKINNER IN THE SE 1/4 OF SECTION 9, T4N, R4W, W.M. COLUMBIA COUNTY, OREGON SCALE 1" = 60' APRIL 21, 1997</p>	<p>COLUMBIA COUNTY SURVEYORS OFFICE RECEIVED 5-7-97 ACCEPTED 5-16-97 CHECK #</p>		
DRAWN BY: DDW	FIELD: DDW/MM	EQUIPMENT: GTS300/TDS48	JOB No. 97-010	PROJECT No. 97-010	REVISED:

4286

4286