

1-1845


LOT SURVEY in the
SW 1/4 NW 1/4, SEC 4, T4N, R4W, W. M.
for SCOTT & HOLLY SWORD
COLUMBIA COUNTY, OREGON
SCALE 1"=50' JAN 11, 1986

COUNTY SURVEYOR

RECEIVED 1-13-86

FILED 1-13-86 J.L.

NARRATIVE: THIS SURVEY WAS TO
MARK AND MONUMENT THE BOUNDARY
OF THE SWORD TRACT AS INDICATED. THE
SURVEY IS BASED ON RECOVERY OF
THE NICE-WELLER RECORD SURVEY DATED
9/20/79. MONUMENTS AS SHOWN.
BASE OF BEARINGS FROM CS # 129
AND L-138, OF COLUMBIA COUNTY RECORDS

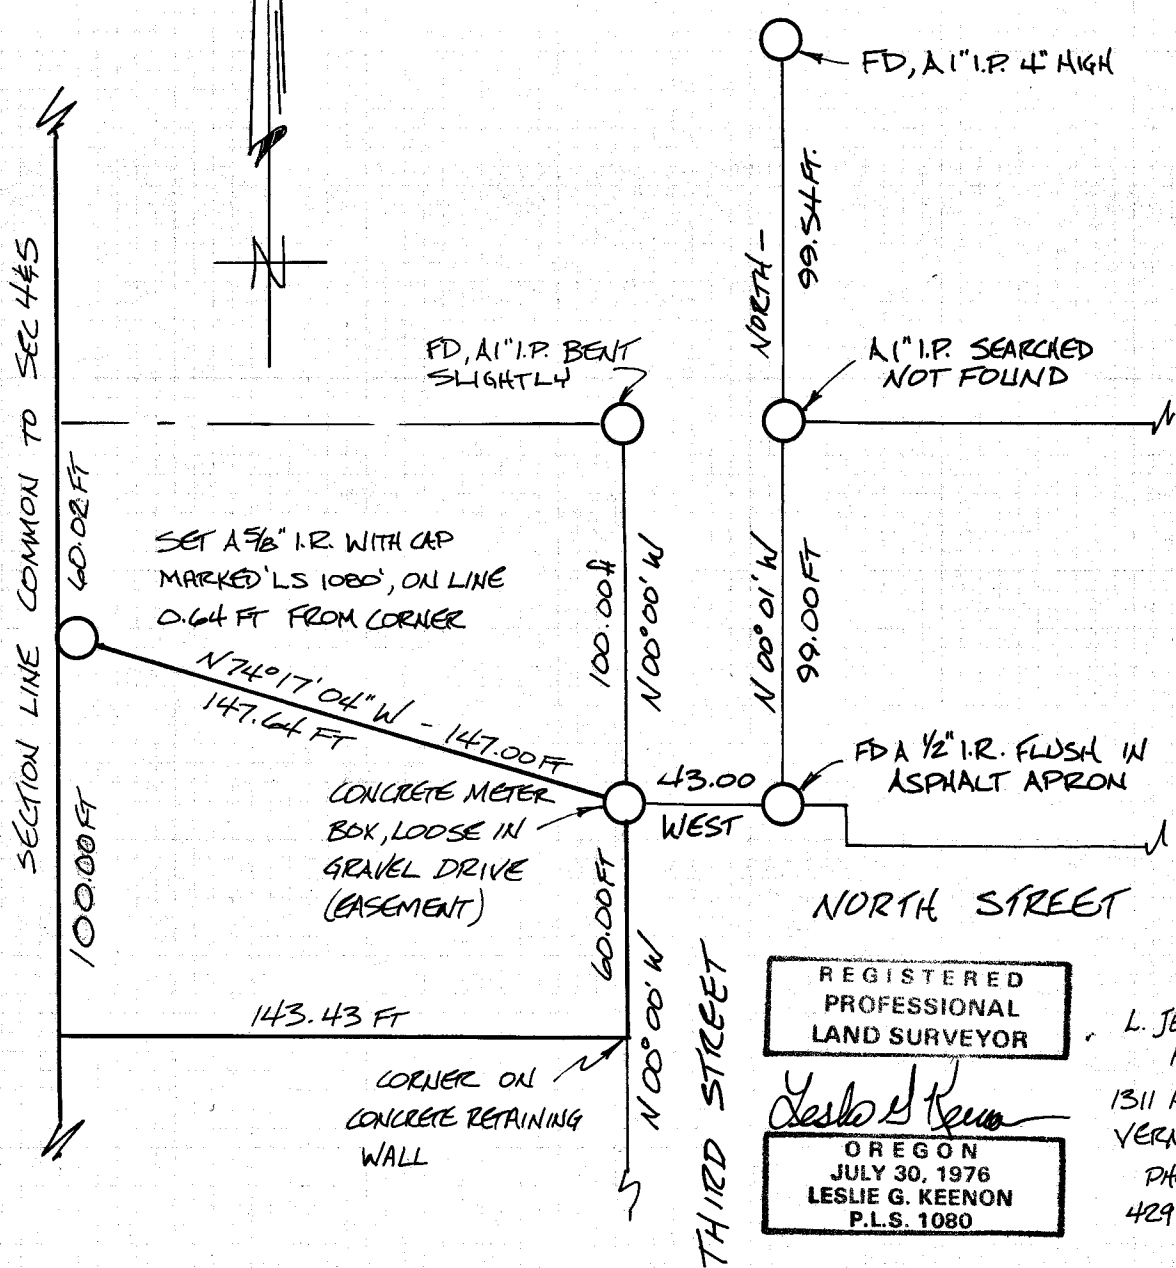

REGISTERED
PROFESSIONAL
LAND SURVEYOR

OREGON
JULY 30, 1976
LESLIE G. KEENON
P.L.S. 1080

L. JERRY
KEENON
1311 ALDER ST.
VERNONIA, ORE.
PHONE
429-6115