


h257

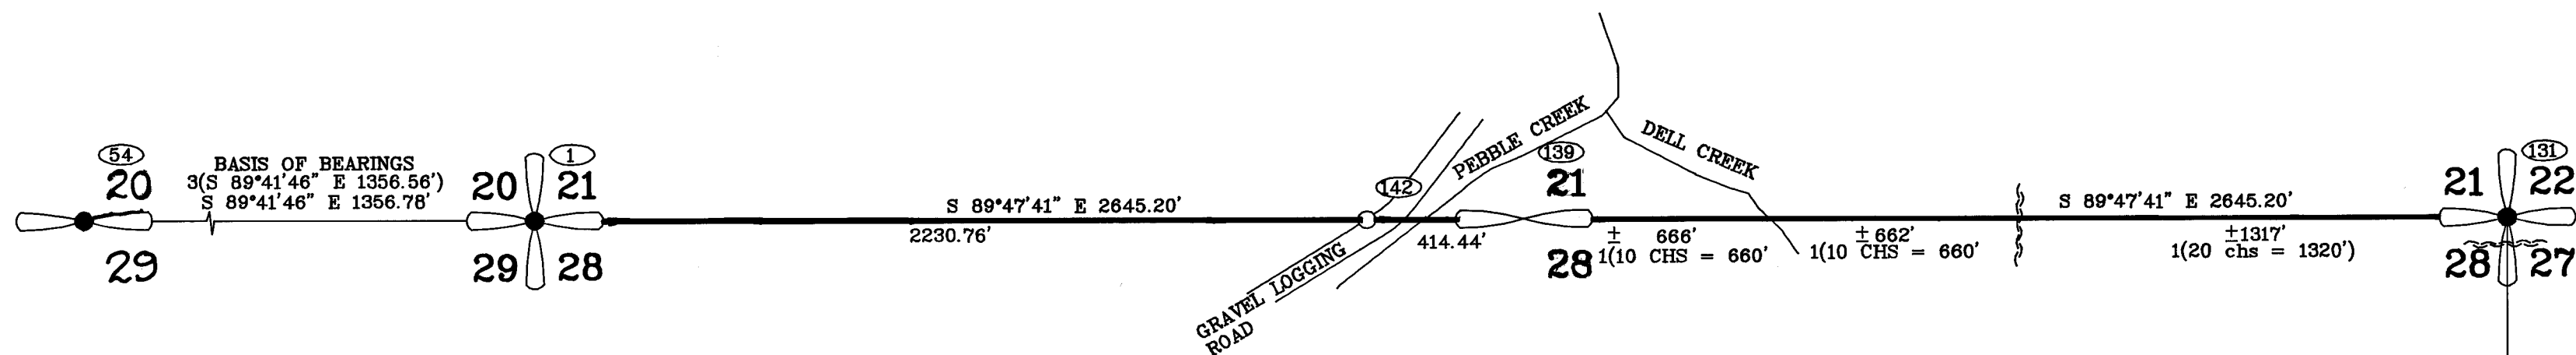

# NARRATIVE:

---THIS SURVEY WAS ACCOMPLISHED AT THE REQUEST OF OLYMPIC RESOURCE MANAGEMENT INC. TO MARK THE NORTH LINE OF SECTION 28, T4N, R4W, W.M. AS SHOWN.

---THE BASIS OF BEARINGS IS FROM CS No. 3563.

-----ALL REFERENCES WERE MEASURED WITH A HAND COMPASS SET AT DECLINATION 21° EAST AND A STEEL TAPE. ALL NEW BEARING TREES WERE MEASURED TO THE HEAD OF A 3" TRACK SPIKE SET IN THE BASE BLAZE BETWEEN THE "B" AND THE "T". BEARING TREE TAGS WERE PLACED AT SHOULDER HEIGHT ABOVE THE BLAZES.

---THE LINES WERE MARKED WITH RED AND WHITE RIBBON AND METAL BOUNDARY REFERENCE TAGS PLACED IN A SLICE AT LOWEST PART OF ROOT CROWN.

## LEGEND

- = MONUMENT FOUND AS NOTED
- = SET A 5/8" x 30" IRON ROD WITH A Y.P.C. MARKED "KEENON LAND SERVICES INC."
- ( ) = RECORD SURVEY DATA
- [ ] = RECORD DEED DATA
- CS No. = RECORD SURVEY No.
- Y.P.C. = YELLOW PLASTIC CAP
- = CONTROL POINT No.
- ~~~~~ = RIDGE

## REFERENCE SURVEYS

- 1 = G.L.O.
- 2 = CS No. 2859
- 3 = CS No. 3563

## MONUMENT NOTES:

- ① SECTION CORNER COMMON TO SECTIONS 20, 21, 28 & 29  
FOUND A 1" IRON PIPE  
REFERENCES FOUND:  
A 25" FIR N 88° W 25.64' TO SPIKE  
A 20" FIR N 16° W 11.90' TO SPIKE  
A 7" FIR N 29° E 13.10' TO SPIKE  
A 21" FIR S 35° E 28.00' TO SPIKE  
A 40" FIR STUMP S 85° W 46' TO CENTER, BURNT FACE.  
A WHITE FIBERGLASS FENCE POST NORTH 1'
- ⑤4 E 1/16 CORNER COMMON TO SECTIONS 20 & 29  
FOUND A 5/8" IRON ROD UP 0.3'
- ①25 1/4 CORNER COMMON TO SECTIONS 27 & 28  
FOUND A 1" IRON PIPE WITH A BABBITT FILLED CAP UP 6" PER CS No. 2859.  
REFERENCES FOUND:  
A 40" FIR STUMP N 76° W 20.9' TO FACE SCRIBED "CS 1/4"  
A 27" FIR STUMP N 63° E 6.2' TO FACE SCRIBED "CS 1/4 S"  
AN UPROOT HOLE N 40° W 22'  
THE DECAYED REMAINS OF A FIR STUMP S 82° E 8.5'  
A 15" FIR N 40° W 8.3' TO HEALED FACE  
A 9" DEAD FIR N 84° E 23.3' TO HEALED FACE  
A 17" FIR S 9° W 18.9' TO HEALED FACE  
AN OLD LOGGING ROAD WEST 30' COURSE NW. SE
- ①31 SECTION CORNER COMMON TO SECTIONS 21, 22, 27 & 28  
SET A 5/8" IRON ROD FROM REMAINS OF ORIGINAL BEARING TREE STUMPS.  
REFERENCES FOUND:  
A 30 FIR 30° E 7.92 TO CENTER  
THE ROTTED AND BURNED SHELL OF A 24 FIR STUMP S 20° E 3.96 TO CENTER.  
AN UPROOT HOLE BEARS S 80° W 13.2  
REFERENCES SET:  
A 15" FIR N 26° E 9.61' TO SPIKE  
A 17" FIR N 89° W 42.53' TO SPIKE  
A 14" FIR S 51° W 13.67' TO SPIKE  
A 16" FIR N 88° E 23.32' TO SPIKE  
A 6" WHITE FIBERGLASS POST EAST 1'
- ①42 SET A 5/8" IRON ROD WITH A Y.P.C. MARKED "KEENON LAND SERVICES INC." 30' WEST OF THE CENTERLINE OF A GRAVEL LOGGING ROAD.  
REFERENCES SET:  
A 13" ALDER N 01° E 28.96' TO SPIKE, BARK SCRIBED "PC BT"  
A 6" STEEL "T" POST WITH LOCATION TAG NORTH 1'

<p>REGISTERED PROFESSIONAL LAND SURVEYOR</p> <p><i>Leslie G. Keenon</i></p> <p>OREGON JULY 30, 1976 LESLIE G. KEENON 1080</p>	<p>LAND SERVICES</p> <p>KEENON</p> <p>1224 ALDER ST. VERNONIA, OR 97064 (503) 429-6115</p>	<p>SURVEY FOR</p> <p>OLYMPIC RESOURCE MANAGEMENT INC. THE NORTH LINE OF SECTION 28, T4N, R4W, W.M. COLUMBIA COUNTY, OREGON SCALE 1" = 400 JULY 3, 1998</p>	<p>COLUMBIA COUNTY</p> <p>COUNTY SURVEYOR RECEIVED <u>8-11-98</u> FILED <u>10-28-98</u></p>	
DRAWN BY: DDW	FIELD: MWM/VSS/RT/DDW	EQUIPMENT: GTS300/TDS48	JOB No. 98-045	PROJECT No. 98-045
REVISED: 7/7/98				