


2887

4283

STATE HWY No. 47
N 17°33'43" E 4.01'

DETAIL
SCALE 1" = 50'

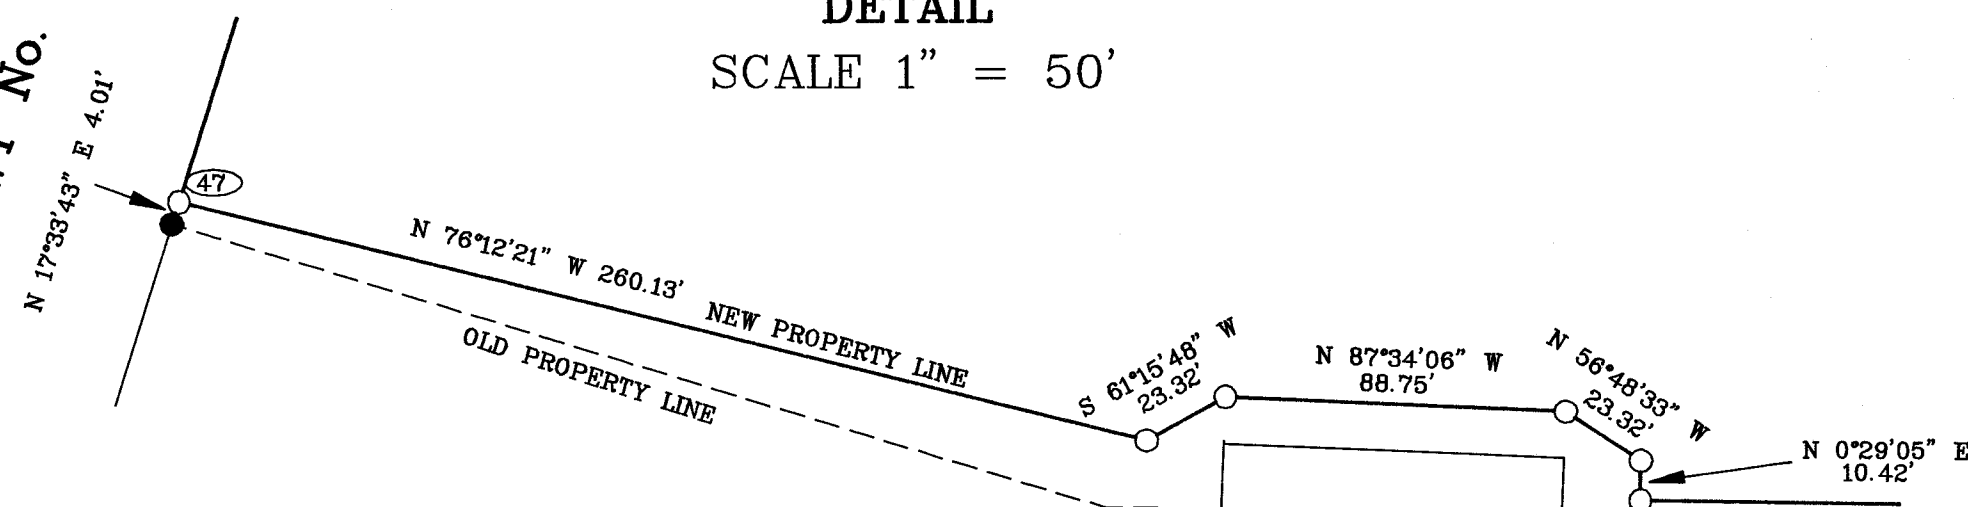

BARN



NW CORNER OF PARCEL 1
A 5/8" IRON ROD WITH A Y.P.C.
MARKED "KEENON LAND
SERVICES INC." PER PARTITION
PLAT 1995-051.

STATE HWY No. 47

BOOK 63, PAGE 41

PARCEL 2

SE CORNER OF PARCEL 2
A 5/8" IRON ROD WITH A Y.P.C.
MARKED "KEENON LAND
SERVICES INC." PER PARTITION
PLAT 1995-051.

PARCEL 1


SE CORNER OF PARCEL 1
A 5/8" IRON ROD WITH A Y.P.C.
MARKED "KEENON LAND
SERVICES INC." PER PARTITION
PLAT 1995-051.

NARRATIVE:

--THIS SURVEY WAS ACCOMPLISHED AT THE REQUEST OF ED BARTHOLEMY TO MONUMENT AND DESCRIBED A PROPERTY LINE ADJUSTMENT ALONG THE SOUTH LINE OF PARCEL 1, PARTITION PLAT 1995-51.
--THE BASIS OF BEARINGS IS FROM PARTITION PLAT 1995-51.
--CONTROL IS FROM PARTITION PLAT 1995-51. THE ADJUSTED PROPERTY LINE WAS ESTABLISHED AT THE LOCATION AGREED UPON BY ED BARTHOLEMY, HAROLD UNEY, ADMINISTRATIVE SERVICES, MELVIN RANDALL AND JOSEPH CURL.

LEGEND

- = MONUMENT FOUND AS NOTED
- = SET A 5/8" x 30" IRON ROD WITH A Y.P.C. MARKED "KEENON LAND SERVICES INC."
- () = RECORD SURVEY DATA PER PARTITION PLAT 1995-51
- [] = RECORD DEED DATA
- CS No. = RECORD SURVEY No.
- Y.P.C. = YELLOW PLASTIC CAP
- = CONTROL POINT No.

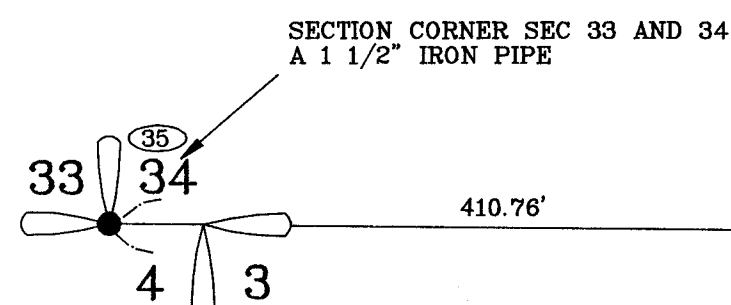

SEE DETAIL

N 76°12'21" W 260.13'

N 89°06'49" W 445.23'

BARN

(125.00')
(125.00')

(180.00')
(180.00')

W 1/16 CORNER SEC 34
A 5/8" IRON BAR 14" DOWN

S 89°29'00" E 1316.80'
(S 89°29'00" E 1316.80')
BASIS OF BEARINGS

KENOWSKE COUNTY ROAD No. 96
(KIOTT ST.)

<p>REGISTERED PROFESSIONAL LAND SURVEYOR</p> <p><i>Leslie G. Keenon</i></p> <p>OREGON JULY 30, 1976 LESLIE G. KEENON 1080 RENEWAL DATE 6/30/97</p>	<p>LAND SERVICES</p> <p>KEENON</p> <p>1224 ALDER ST. VERNONIA, OR 97064 (503) 429-6115</p>	<p>PROPERTY LINE ADJUSTMENT FOR ED BARTHOLEMY PARCEL 1, PARTITION PLAT No. 1995-51 IN THE SW 1/4 OF SECTION 34, T5N, R4W, W.M. COLUMBIA COUNTY, OREGON SCALE 1" = 100 APRIL 7, 1997</p>	<p>COLUMBIA COUNTY SURVEYORS OFFICE RECEIVED 4-23-97 ACCEPTED 5-16-97 CHECK # 110</p>
<p>DRAWN BY: DDW</p>	<p>FIELD: VSS/NS</p>	<p>EQUIPMENT: GTS300/TDS48 JOB No. 97-061 PROJECT No. 95-139</p>	<p>REVISED:</p>

4283

4283