


8-242

RECORD OF SURVEY
FOR WALLY VAUGHN AND PETE PLUMMER
IN THE NW 1/4 OF SEC. 3 AND THE NE 1/4 OF SEC. 4
T4N, R4W, W.M.
COLUMBIA, COUNTY, OREGON
SCALE 1"=70' OCT. 12, 1993

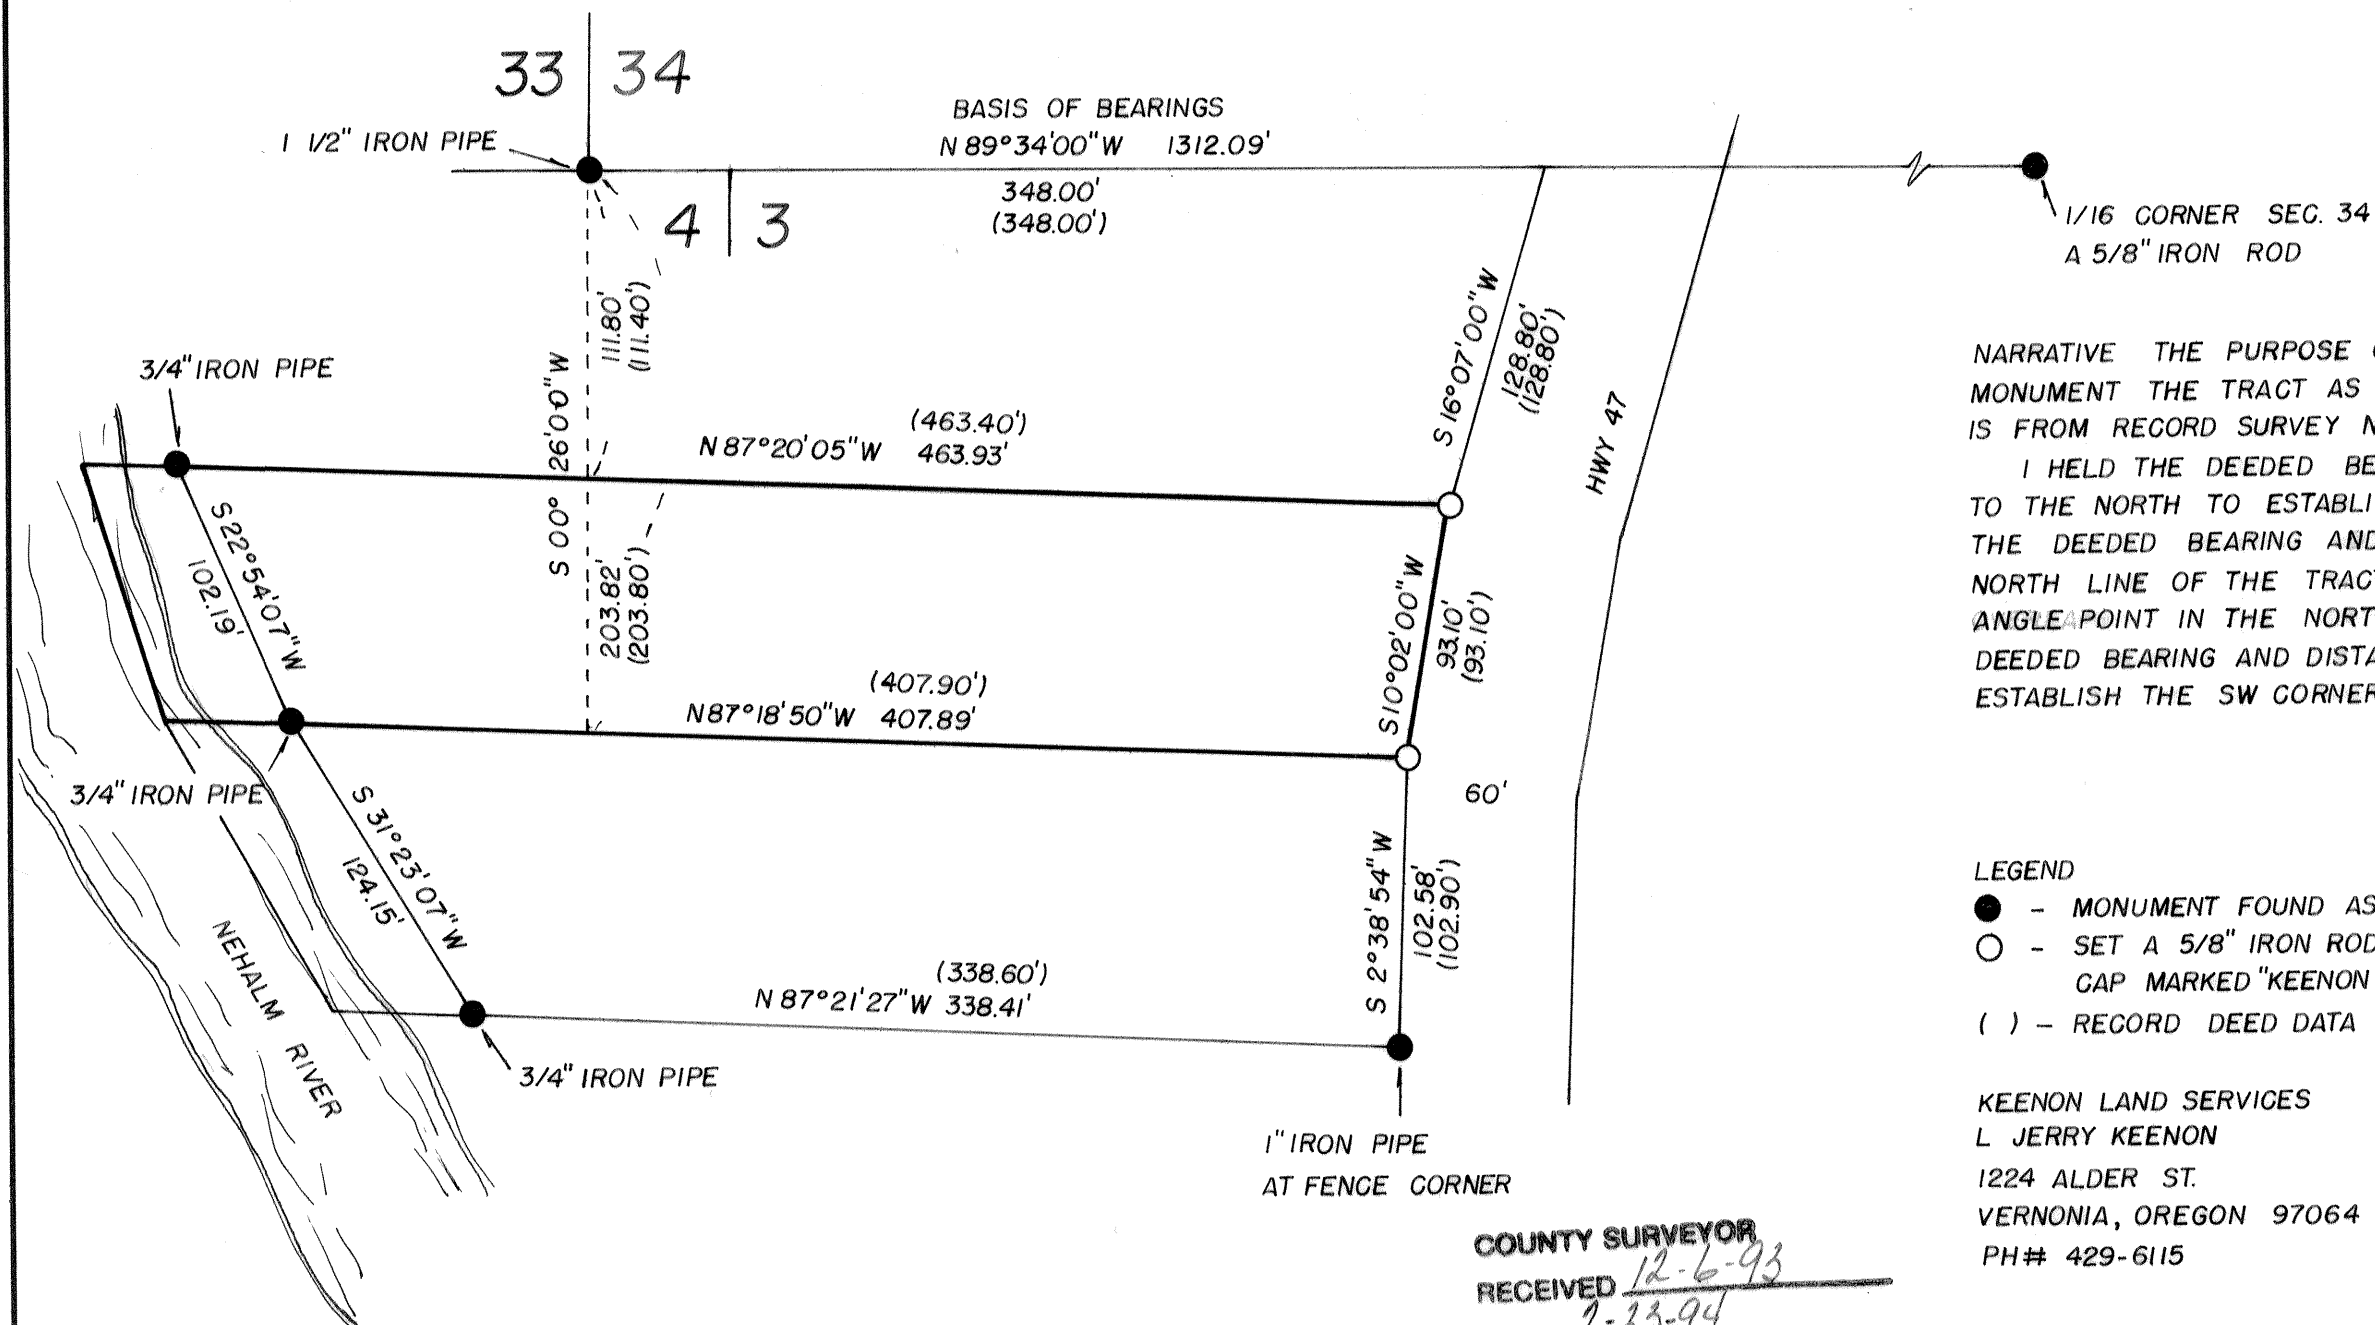

NARRATIVE THE PURPOSE OF THIS SURVEY WAS TO MARK AND MONUMENT THE TRACT AS SHOWN. THE BASIS OF BEARINGS IS FROM RECORD SURVEY No. 224.

I HELD THE DEEDED BEARINGS AND DISTANCES OF THE TRACT TO THE NORTH TO ESTABLISH THE NE CORNER. I DID NOT HOLD THE DEEDED BEARING AND DISTANCE (S 00° 26' W 111.40') TO THE NORTH LINE OF THE TRACT AS IT WOULD HAVE CREATED AN ANGLE POINT IN THE NORTH LINE OF THE TRACT. I HELD THE DEEDED BEARING AND DISTANCE FROM THE NE CORNER TO ESTABLISH THE SW CORNER.

LEGEND

- - MONUMENT FOUND AS NOTED
- - SET A 5/8" IRON ROD WITH A YELLOW PLASTIC CAP MARKED "KEENON LS 1080", 30" LONG
- () - RECORD DEED DATA

KEENON LAND SERVICES
L JERRY KEENON
1224 ALDER ST.
VERNONIA, OREGON 97064
PH# 429-6115

REGISTERED
PROFESSIONAL
LAND SURVEYOR

OREGON
JULY 30, 1978
LESLIE G. KEENON
1080

COUNTY SURVEYOR

RECEIVED 12-6-93

FILED 2-23-94

EXP 12/31/93

B-242