
RECORD OF SURVEY


FOR BILL VANLEER AND STEVE MINGER

IN THE S I/2 OF SEC. 7, T4N, R4W, W.M.

COLUMBIA COUNTY, OREGON

SCALE I"= 400' NOV. 12, 1993

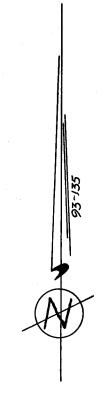

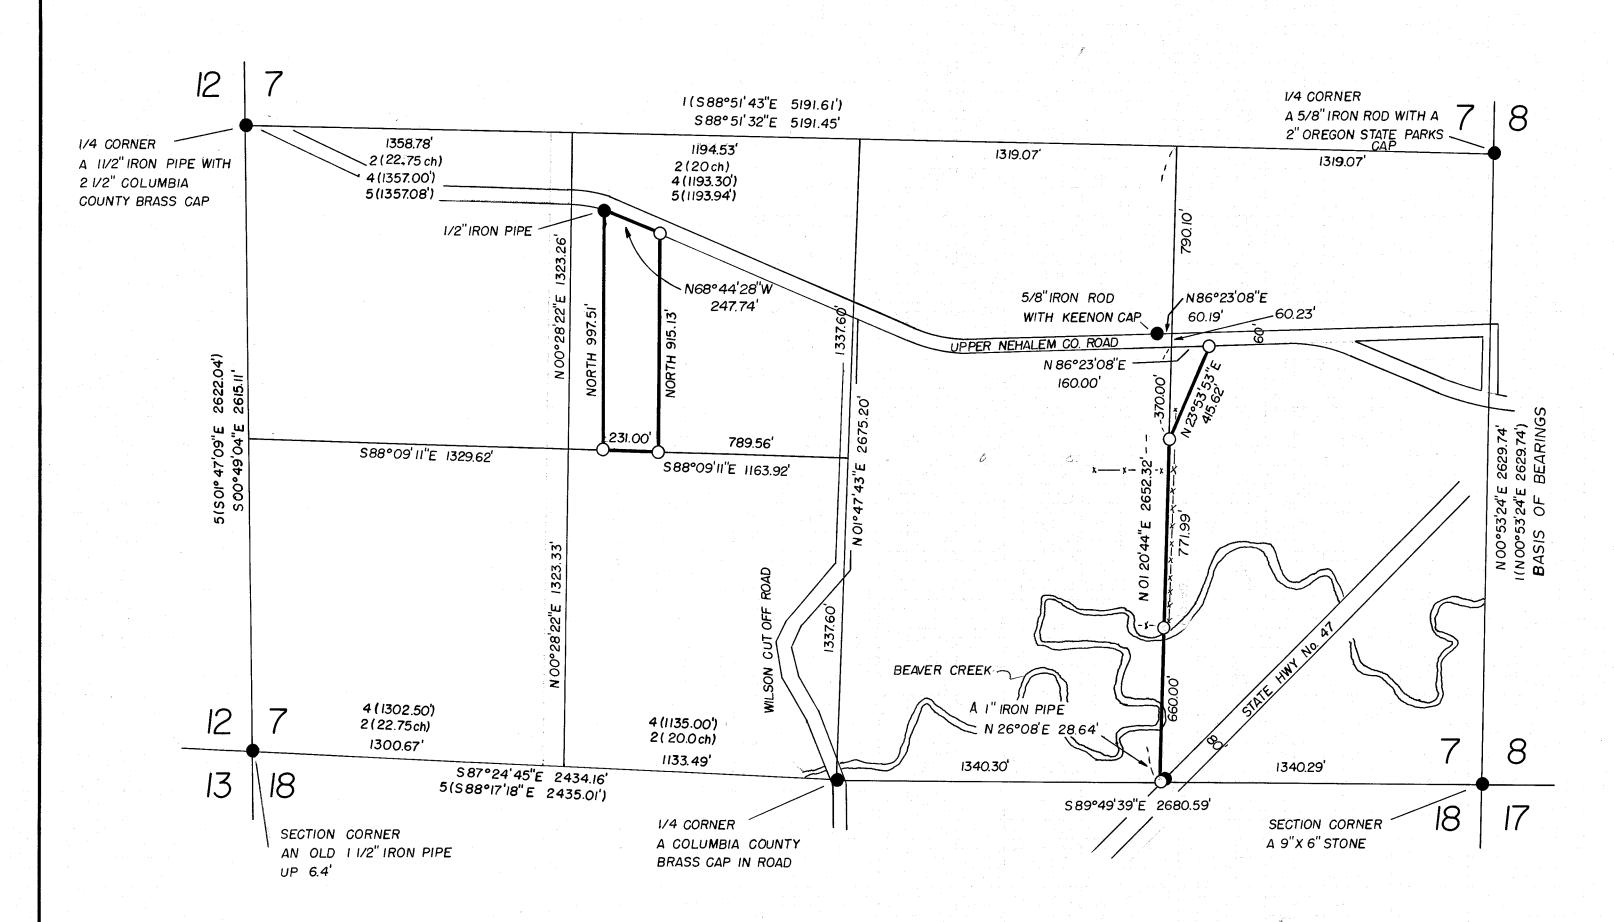

NARRATIVE: THE PURPOSE OF THIS SURVEY WAS TO MARK AND MONUMENT THE LINES AS SHOWN. CONTROL IS FROM RECOVERED MONUMENTS AS SHOWN. I COMPUTED THE C 1/4 POSITION BY PROPORTION BASED ON RS 3805. THE BASIS OF BEARINGS IS FROM RS 3805.

- I. FOR THE PARCEL IN THE SW 1/4 I HELD THE 1/2" IRON PIPE FOR THE NW CORNER.
- 2. FOR THE WEST LINE I HELD THE DEEDED BEARING (SOUTH) FROM THE 1/2" IRON PIPE TO THE 1/16 LINE.
- 3. FOR THE SOUTH LINE I HELD THE DEEDED DISTANCE (231.00') FROM THE SW CORNER ALONG THE 1/16 LINE TO THE SE CORNER.
- 4. FROM THE SE CORNER I HELD THE DEEDED BEARING (NORTH)
 TO THE SOUTH LINE OF THE COUNTY ROAD.
- 5. FOR THE PARCEL IN THE SE 1/4 I SET THE NORTH CORNER ON THE SOUTH LINE OF THE COUNTY ROAD 160.00' FROM THE 1/16 LINE AS PER DEED CALLS.
- 6 THE SOUTHERLY NORTH CORNER WAS SET ON THE 1/16 LINE 370.00' FROM THE SOUTH LINE OF THE COUNTY ROAD AS PER DEED CALLS.

LEGEN

● - MONUMENT FOUND AS NOTED

O - SET A 5/8"X30" IRON ROD WITH A YELLOW PLASTIC CAP MARKED "KEENON LS 1080"

RS - RECORD SURVEY No.

() - RECORD DATA I= RS 3805

2= GLO 3=RS 3693 4=RS 2004

5=RS 2980

-x- FENCE LINE

KEENON LAND SERVICES
L JERRY KEENON
1224 ALDER ST.
VERNONIA, OREGON 97064
PH # 429-6115

REGISTERED
PROFESSIONAL
LAND SURVEYOR

OREGON
JULY 30, 1976
LESLIE G. KEENON
1080

COUNTY SURVEYOR
RECEIVED 12-6-93
FILED 2-23-94
389

DRAWN BY: DON WALLACE