

NARRATIVE:



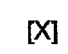
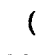

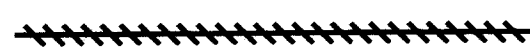
--THE PURPOSE OF THIS SURVEY IS TO MARK THE PROPERTY LINES AS SHOWN AT THE REQUEST OF WEYERHAEUSER COPR.

--THE BEARINGS ARE GEODETIC AND WERE BASED ON GPS OBSERVATIONS TAKEN AT MONUMENT NUMBER 1, HAVING A LATITUDE OF 45°52'27.307" NORTH, AND A LONGITUDE -123°12'58.521" WEST. THE CONVERGENCE ANGLE (FROM OREGON STATE PLANE COORDINATE SYSTEM NORTH ZONE) AT SAID POINT IS -1°55'35". DISTANCES SHOWN ARE GROUND DISTANCES.

--FOR CONTROL I HELD THE MONUMENTS AS NOTED IN THE MONUMENT NOTES PER COUNTY SURVEY NUMBER 3508.

--THE BOUNDARY LINES SHOWN AS HATCHED WERE MARKED WITH WHITE 1/2" X 6' FIBER GLASS POST EVERY 100' +/- WITH RED AND WHITE RIBBON ON TRUE LINE, LINE TREES WHERE MARKED WITH BLUE PAINT AND BLAZED WITHIN 10' +/- OF LINE.

LEGEND

-  1/4 CORNER
-  FOUND MONUMENT AS NOTED
-  MONUMENT POINT NO
-  RECORD SURVEY DATA
-  SURVEY NUMBER, COLUMBIA COUNTY SURVEY RECORDS
-  MARKED LINE AS NOTED

JOHN HANCOCK
MUTUAL LIFE INSURANCE COMPANY
INST NO. 97-04299

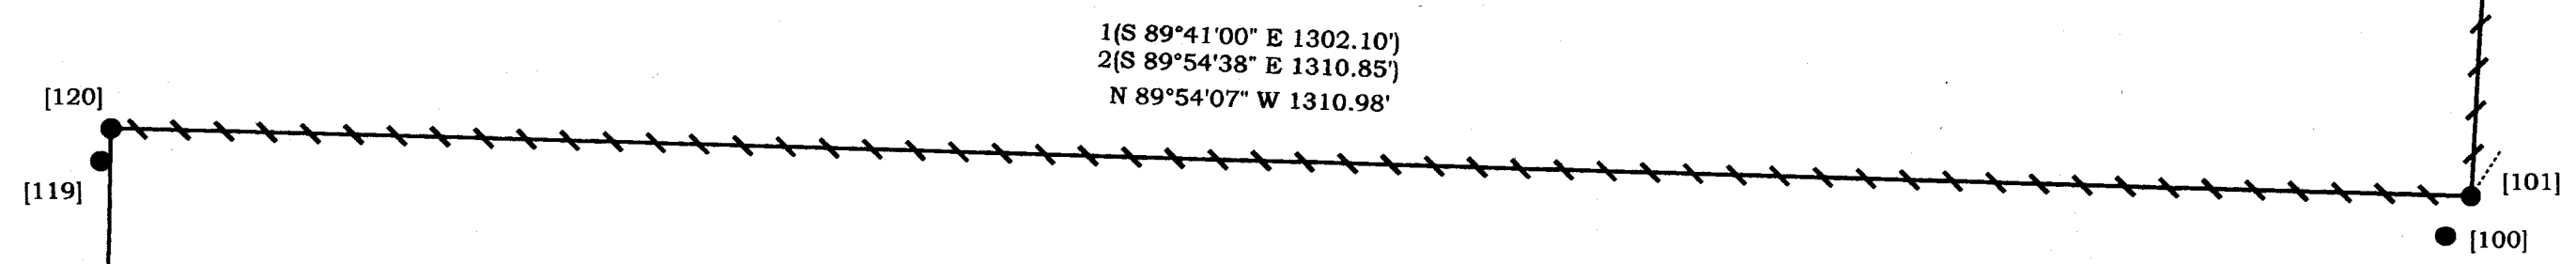
MONUMENT NOTES:

- [1]
1/4 CORNER COMMON TO SECTIONS 31 & 32
FOUND 2" GALVANIZED IRON PIPE WITH 3" BRASS CAP MARKED "CROWN ZELLERBACH 1/4 S31.S32 1985 LS 707" PER CS NO. 3508 (HELD).
- [100]
FOUND 1 1/4" STAINLESS STEEL IRON PIPE WITH 2" BRASS CAP PER CS NO. 2822. BEARS S 33°03'17" W 26.29' FROM MONUMENT NO. 101. RECORD CS 3508 (S 30°57' W 26.25')
REFERENCES FOUND:
23" FIR STUMP N 14° W 41.20' TO HEALED FACE.
- [101]
S 1/16 CORNER COMMON TO SECTIONS 31 & 32
FOUND 2" GALVANIZED IRON PIPE WITH 3" BRASS CAP MARKED "CROWN ZELLERBACH S 1/16 S31.S32 1985 LS 707" PER CS NO. 3508 (HELD).
REFERENCES FOUND:
20" CEDAR STUMP N 66° W 26.30' TO HEALED FACE.
REFERENCES ADDED:
16" FIR S 29° W 20.95' TO SPIKE IN SCRIBED FACE "1/16 S 31 BT".
- [119]
FOUND 1 1/4" STAINLESS STEEL IRON PIPE WITH 2" BRASS CAP, UP 1.35' PER CS NO. 2822. BEARS, S 17°57'16" W 18.95' FROM MONUMENT NO. 120. RECORD CS 3508 (S 15° 59' W 18.87')
REFERENCES FOUND:
19" HEMLOCK S 9° W 19.95' TO NAIL IN HEALED FACE.
16" HEMLOCK S 30° W 19.65' TO HEALED FACE.
- [120]
SE 1/16 CORNER
FOUND 2" GALVANIZED IRON PIPE WITH 3" BRASS CAP MARKED "CROWN ZELLERBACH SE 1/16.S31 1985 LS 707" PER CS NO. 3508 (HELD).
REFERENCES FOUND:
13" FIR STUMP S 38° W 22.30' SIDE CENTER.
FIBER GLASS T-POST 1' SOUTH.
REFERENCES ADDED:
10" HEMLOCK S 38° E 14.86' TO SPIKE IN SCRIBED FACE " SE 1/16 S32 BT".
6" HEMLOCK S 45° W 17.95' TO SPIKE IN SCRIBED FACE "X BT".



REFERENCES:

- SURVEYS:
1 = CS NO. 2822
2 = CS NO. 3508
- DEEDS:
INST NO. 2007-007273
INST NO. 97-04299

LONGVIEW TIMBERLANDS, LLC
INST NO. 2007-007273



LONGVIEW TIMBERLANDS, LLC
INST NO. 2007-007273

<p>REGISTERED PROFESSIONAL LAND SURVEYOR</p>  <p>OREGON JANUARY 19, 1993 DONALD D. WALLACE, JR. 2601 RENEWS 6/30/20</p>	 <p>K.L.S. SURVEYING INC. 1224 ALDER STREET VERNONIA, OREGON 97064 (503) 429-6115</p>	<p>RECORD OF SURVEY FOR WEYERHAEUSER IN THE SE 1/4 OF SECTION 31, T5N, R4W, W.M., COLUMBIA COUNTY, OREGON JANUARY 2, 2020</p>		DRAWN BY: JDT
				FIELD: SWM JR / DJL
				EQUIPMENT: GTP301/RECON
				JOB No. 15-097
				DRAWING NAME: 20-003 ROS
REVISED: 4-27-2020				