


CURVE TABLE						RECORD DATA		
CURVE	DELTA	LENGTH	RADIUS	BEARING	CHORD	DELTA	LENGTH	RADIUS
C1	44°13'12"	254.17'	329.33'	S 29°34'03" W	247.91'	44°13'08"		329.33'
C2	46°45'00"	110.56'	135.50'	S 28°18'09" W	107.52'	46°44'53"		135.50'
C3	5°12'26"	27.66'	304.33'	S 10°03'40" W	27.65'	5°12'	27.62'	304.33'
C4	19°30'47"	103.65'	304.33'	S 22°25'17" W	103.15'	19°31'	103.66'	304.33'
C5	19°29'58"	103.57'	304.33'	S 41°55'40" W	103.07'	19°30'08"	103.59'	304.33'
C6	23°41'52"	66.38'	160.50'	S 39°49'43" W	65.91'	23°42'12"	66.40'	160.50'
C7	23°03'08"	64.58'	160.50'	S 16°27'13" W	64.14'	23°02'41"	64.55'	160.50'
C8	82°21'30"	158.84'	110.50'	S 46°06'24" W	145.51'	82°18'45"	158.75'	110.50'
C9	2°01'15"	3.90'	110.50'	S 88°17'47" W	3.90'	2°04'	3.99'	110.50'

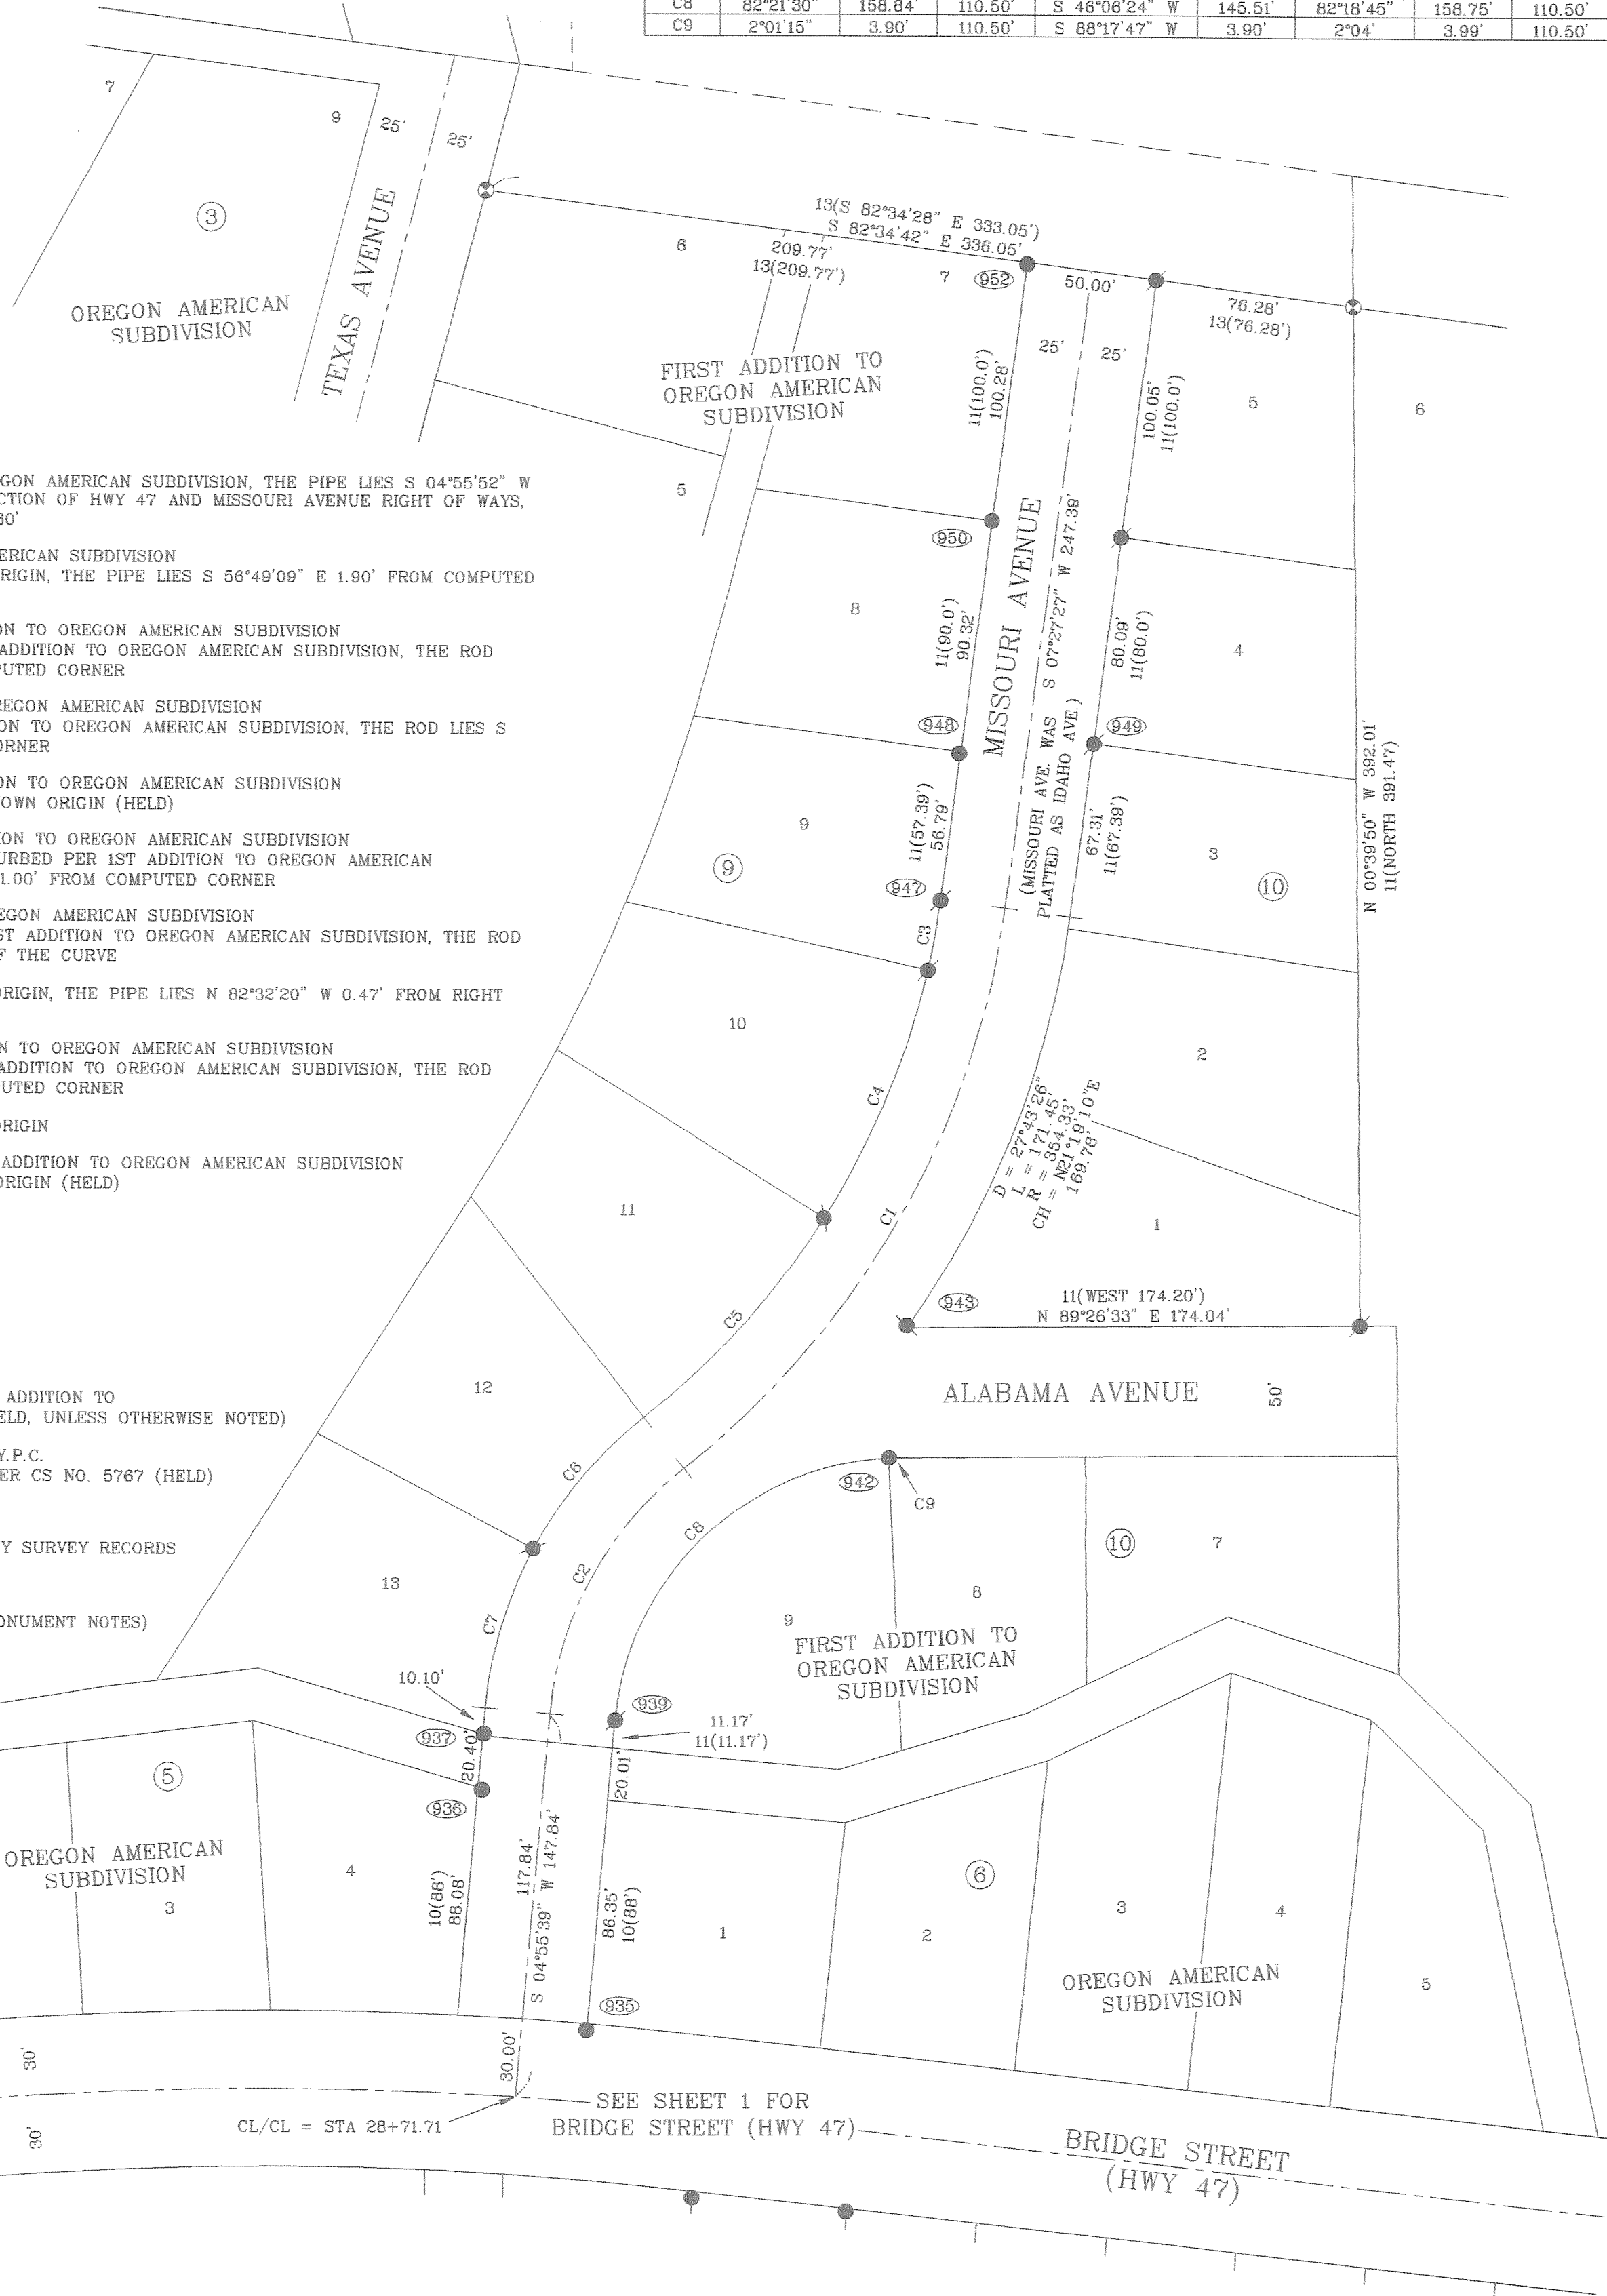

MONUMENT NOTES:

- 935 FOUND A BENT 1/2" IRON PIPE, PER OREGON AMERICAN SUBDIVISION, THE PIPE LIES S 04°55'52" W 2.36 FEET FROM THE COMPUTED INTERSECTION OF HWY 47 AND MISSOURI AVENUE RIGHT OF WAYS, AND AT STATION 28+96.79 AND LEFT 27.60'
- 936 NE CORNER LOT 4, BLOCK 5, OREGON AMERICAN SUBDIVISION FOUND A 1/2" IRON PIPE OF UNKNOWN ORIGIN, THE PIPE LIES S 56°49'09" E 1.90' FROM COMPUTED CORNER
- 937 SE CORNER LOT 13, BLOCK 9, 1ST ADDITION TO OREGON AMERICAN SUBDIVISION FOUND BENT A 5/8" IRON ROD PER 1ST ADDITION TO OREGON AMERICAN SUBDIVISION, THE ROD LIES N 59°13'50" E 0.48' FROM THE COMPUTED CORNER
- 939 PT LOT 9, BLOCK 10, 1ST ADDITION TO OREGON AMERICAN SUBDIVISION FOUND A 5/8" IRON ROD PER 1ST ADDITION TO OREGON AMERICAN SUBDIVISION, THE ROD LIES S 16°14'39" E 0.14' FROM THE COMPUTED CORNER
- 942 NE CORNER LOT 9, BLOCK 10, 1ST ADDITION TO OREGON AMERICAN SUBDIVISION FOUND A 1" IRON PIPE UP 0.7', OF UNKNOWN ORIGIN (HELD)
- 943 SW CORNER LOT 1, BLOCK 10, 1ST ADDITION TO OREGON AMERICAN SUBDIVISION FOUND A 5/8" IRON ROD BENT AND DISTURBED PER 1ST ADDITION TO OREGON AMERICAN SUBDIVISION, THE ROD LIES N 06°11'53" W 1.00' FROM COMPUTED CORNER
- 947 PC LOT 9, BLOCK 9, 1ST ADDITION TO OREGON AMERICAN SUBDIVISION FOUND DISTURBED 5/8" IRON ROD PER 1ST ADDITION TO OREGON AMERICAN SUBDIVISION, THE ROD LIES S 16°59'59" E 0.33' FROM THE PC OF THE CURVE
- 948 FOUND A 1/2" IRON PIPE, OF UNKNOWN ORIGIN, THE PIPE LIES N 82°32'20" W 0.47' FROM RIGHT OF WAY
- 949 SW CORNER LOT 4, BLOCK 9, 1ST ADDITION TO OREGON AMERICAN SUBDIVISION FOUND BENT A 5/8" IRON ROD PER 1ST ADDITION TO OREGON AMERICAN SUBDIVISION, THE ROD LIES S 82°34'58" E 0.22' FROM THE COMPUTED CORNER
- 950 FOUND A 1/2" IRON PIPE, OF UNKNOWN ORIGIN
- 952 NORTHEAST CORNER LOT 7 BLOCK 9, 1ST ADDITION TO OREGON AMERICAN SUBDIVISION FOUND A 3/4" IRON PIPE, OF UNKNOWN ORIGIN (HELD)

LEGEND:

- = MONUMENT FOUND AS NOTED
- = FOUND A 5/8" IRON ROD PER 1ST ADDITION TO OREGON AMERICAN SUBDIVISION (HELD, UNLESS OTHERWISE NOTED)
- = FOUND A 5/8" IRON ROD WITH A Y.P.C. MARKED "K.L.S. SURVEYING INC", PER CS NO. 5767 (HELD)
- () = RECORD SURVEY DATA
- CS NO. = SURVEY NUMBER, COLUMBIA COUNTY SURVEY RECORDS
- Y.P.C. = YELLOW PLASTIC CAP
- = MONUMENT POINT NUMBER (SEE MONUMENT NOTES)

REFERENCE SURVEYS:

- 1 = CS NO. L-140
- 2 = CS NO. L-2002
- 3 = CS NO. 1471
- 4 = CS NO. 3413
- 5 = CS NO. 4039
- 6 = CS NO. 4166
- 7 = CS NO. 4201
- 8 = CS NO. 5024
- 9 = PARTITION PLAT NO. 1997-26
- 10 = OREGON AMERICAN SUBDIVISION (PLAT BOOK 3, PAGE 1)
- 11 = 1ST ADDITION TO OREGON AMERICAN SUBDIVISION (PLAT BOOK 3, PAGE 15)
- 12 = BEARING TREE BOOK D, PAGE 34
- 13 = CS NO. 5787

<p>REGISTERED PROFESSIONAL LAND SURVEYOR</p> <p>OREGON</p> <p>JANUARY 19, 1993</p> <p>DONALD D. WALLACE JR.</p> <p>2601</p> <p>RENEWAL DATE 6/30/12</p>	<p>K.L.S. SURVEYING INC.</p> <p>1224 ALDER STREET</p> <p>VERNONIA, OR 97064</p> <p>(503) 429-6115</p>	<p>BOUNDARY SURVEY</p> <p>VERNONIA SCHOOL DISTRICT 47J</p> <p>IN THE NE 1/4 OF SECTION 4,</p> <p>T4N, R4W, W.M.,</p> <p>CITY OF VERNONIA,</p> <p>COLUMBIA COUNTY, OREGON</p> <p>SCALE 1" = 100' FEBRUARY 17, 2011</p>	<p>SHEET 2 OF 2</p> <p>Columbia County Surveyor</p> <p>Received 5/2/11</p> <p>Filed 5/4/11</p> <p>CS# 5783</p>
DRAWN BY: DDW/BTF	FIELD: SND/BTF/TEB/DDW	EQUIPMENT: HYPER GA	<p>JOB No. 09-058 ODOT</p> <p>PROJECT No. 09-058 ODOT</p> <p>REVISED: 3/7/2011</p>