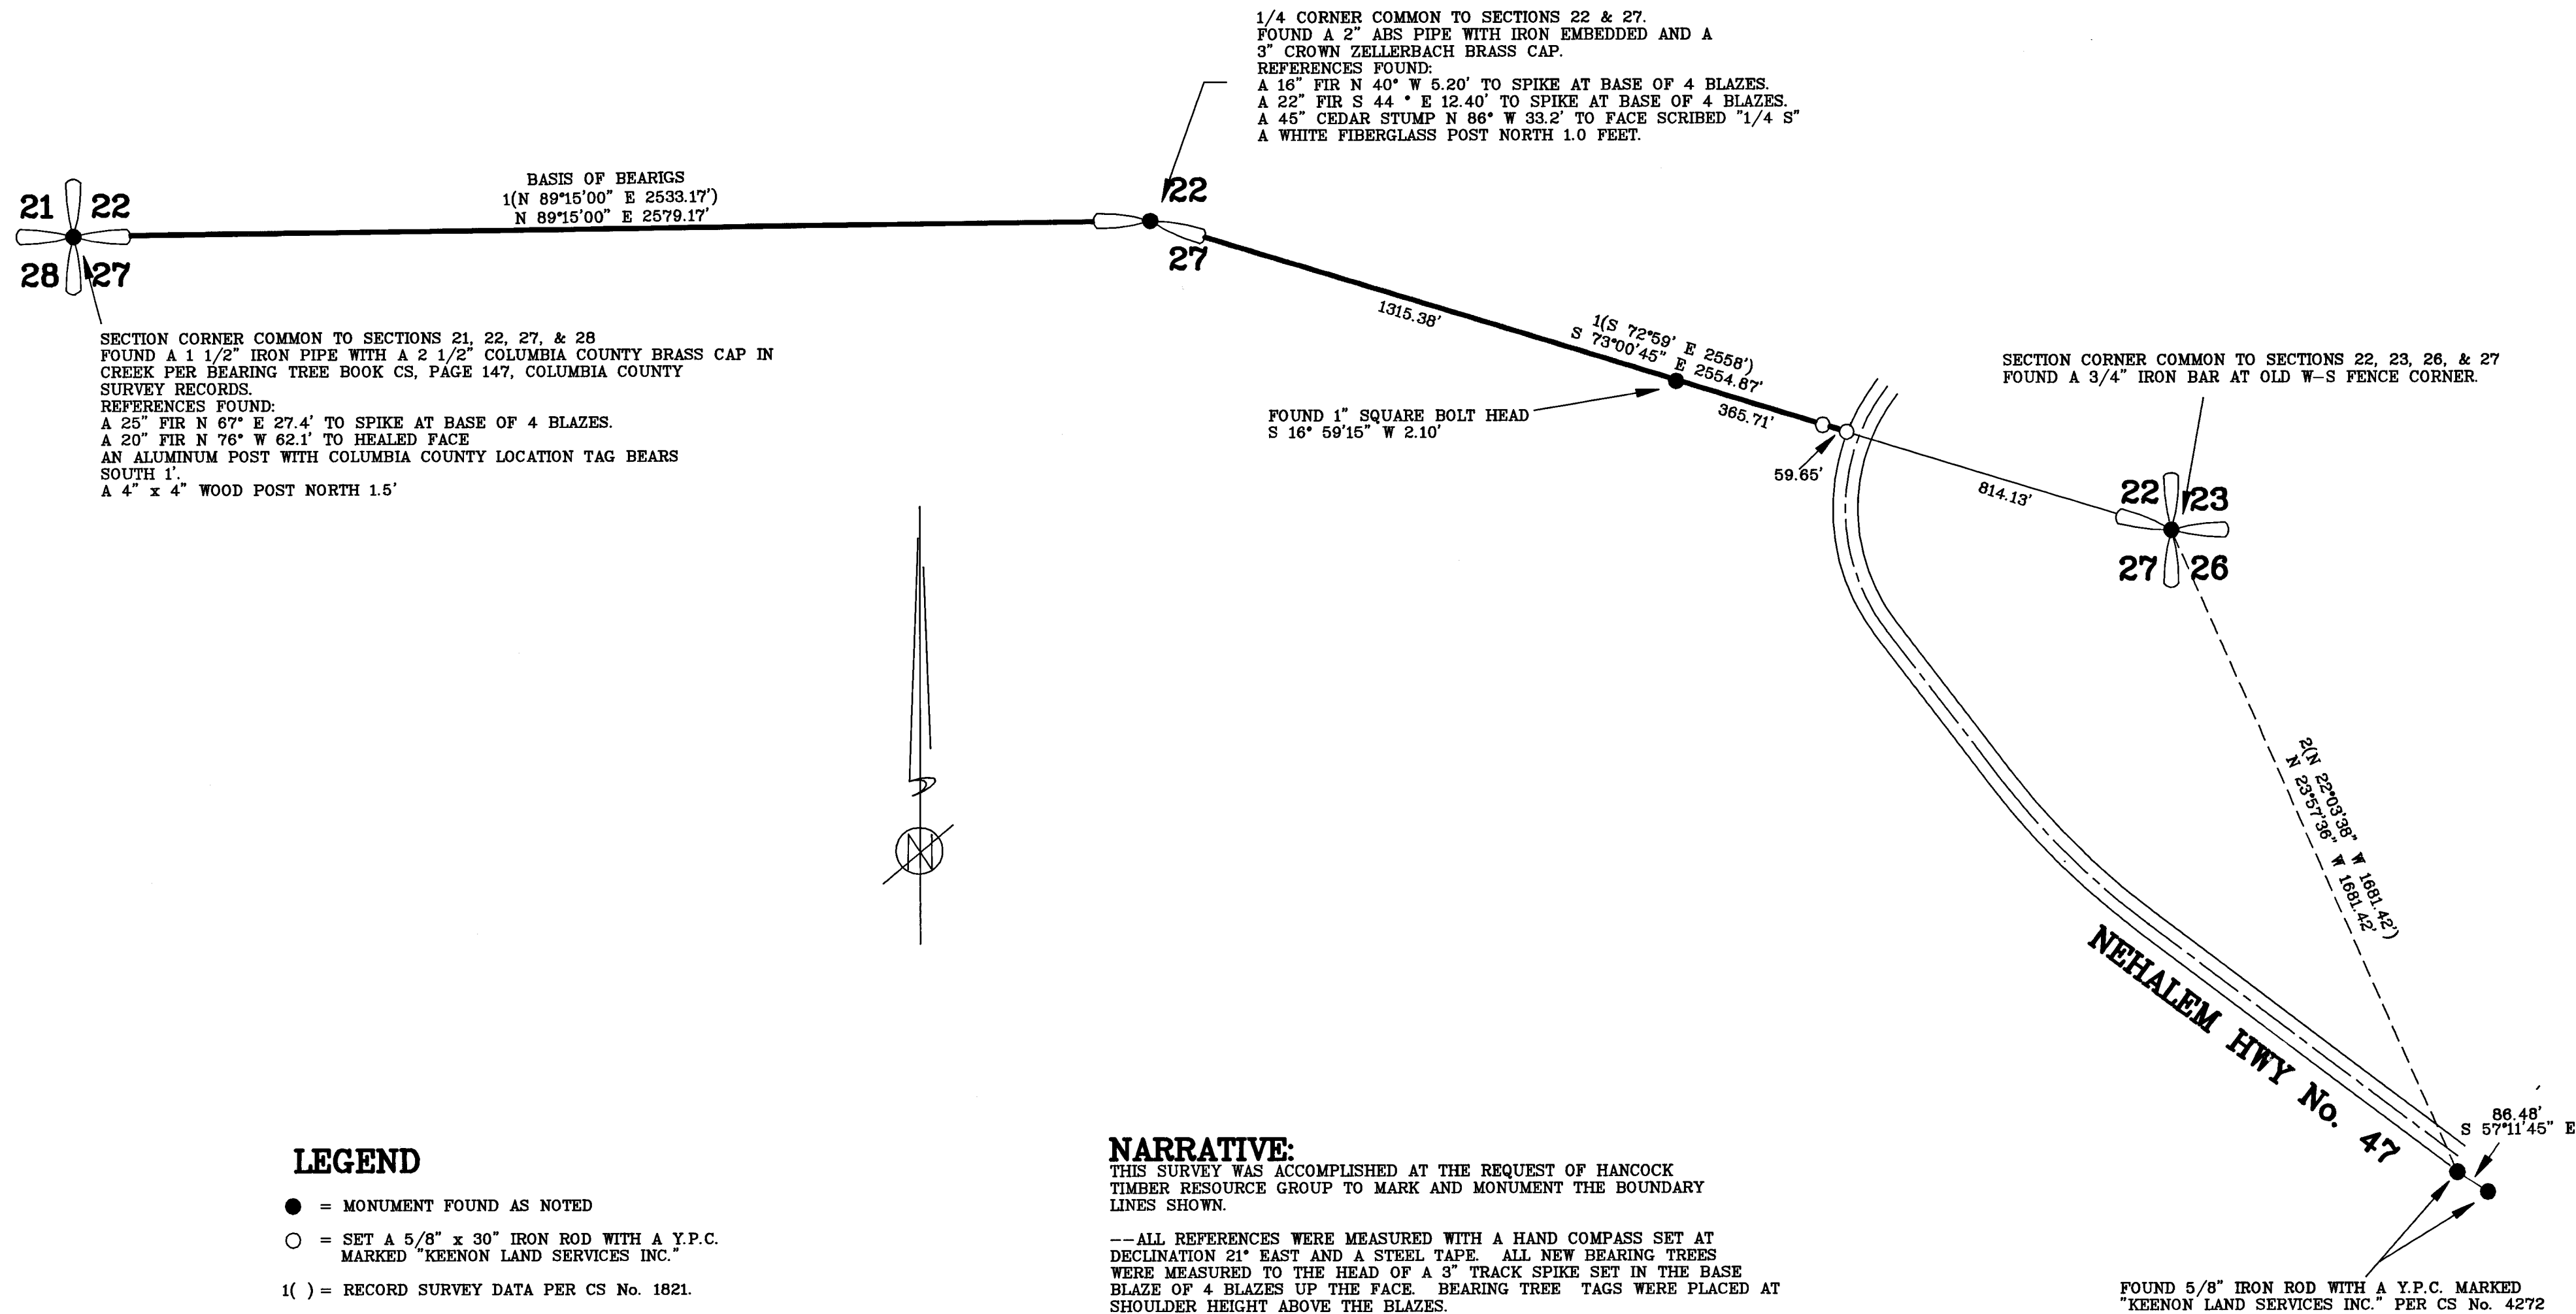


4585

4585

**LEGEND**

- = MONUMENT FOUND AS NOTED
- = SET A 5/8" x 30" IRON ROD WITH A Y.P.C. MARKED "KEENON LAND SERVICES INC."
- 1() = RECORD SURVEY DATA PER CS No. 1821.
- 2() = RECORD SURVEY DATA PER CS No. 4272
- CS = RECORD SURVEY No.
- Y.P.C. = YELLOW PLASTIC CAP

NARRATIVE:

THIS SURVEY WAS ACCOMPLISHED AT THE REQUEST OF HANCOCK TIMBER RESOURCE GROUP TO MARK AND MONUMENT THE BOUNDARY LINES SHOWN.

--ALL REFERENCES WERE MEASURED WITH A HAND COMPASS SET AT DECLINATION 21° EAST AND A STEEL TAPE. ALL NEW BEARING TREES WERE MEASURED TO THE HEAD OF A 3" TRACK SPIKE SET IN THE BASE BLAZE OF 4 BLAZES UP THE FACE. BEARING TREE TAGS WERE PLACED AT SHOULDER HEIGHT ABOVE THE BLAZES.

--THE LINES WERE MARKED WITH RED AND WHITE RIBBON, METAL BOUNDARY REFERENCE TAGS PLACED IN A SLICE AT LOWEST PART OF ROOT CROWN AT APPROXIMATELY 50' INTERVALS. TREES WITHIN 8' OF LINE WERE BLAZED AT CHEST HEIGHT. TREES LOCATED ON THE BOUNDARY LINE WERE MARKED WITH TWO BLAZES ON THE BOUNDARY LINE ON BOTH SIDES OF THE TREE.

REGISTERED PROFESSIONAL LAND SURVEYOR OREGON JULY 30, 1976 LESLIE G. KEENON 1080 RENEWAL DATE 6/30/99	LAND SERVICES KEENON 1224 ALDER ST. VERNONIA, OR 97064 (503) 429-6115	SURVEY FOR HANCOCK TIMBER RESOURCE GROUP THE SOUTH LINE OF SECTION 22, T5N, R4W, W.M. COLUMBIA COUNTY, OREGON SCALE 1" = 300' JAN. 28, 1999	COLUMBIA COUNTY SURVEYORS OFFICE RECEIVED <u>3-4-99</u> ACCEPTED <u>3-30-99</u> CHECK # <u>339</u>
DRAWN BY: DDW	FIELD: MWM/TH	EQUIPMENT: GTSS300/TDS48 JOB No. 98-142A PROJECT No. 98-142A	REVISED: 1/29/99

4585