


PROPERTY LINE ADJUSTMENT
FOR BILL AND CAROL OSTRANDER
AND LONGVIEW FIBRE COMPANY
IN THE N 1/2 OF SEC 30, T4N, R4W, W.M.
COLUMBIA COUNTY, OREGON
SCALE 1" = 200' NOV 23, 1994

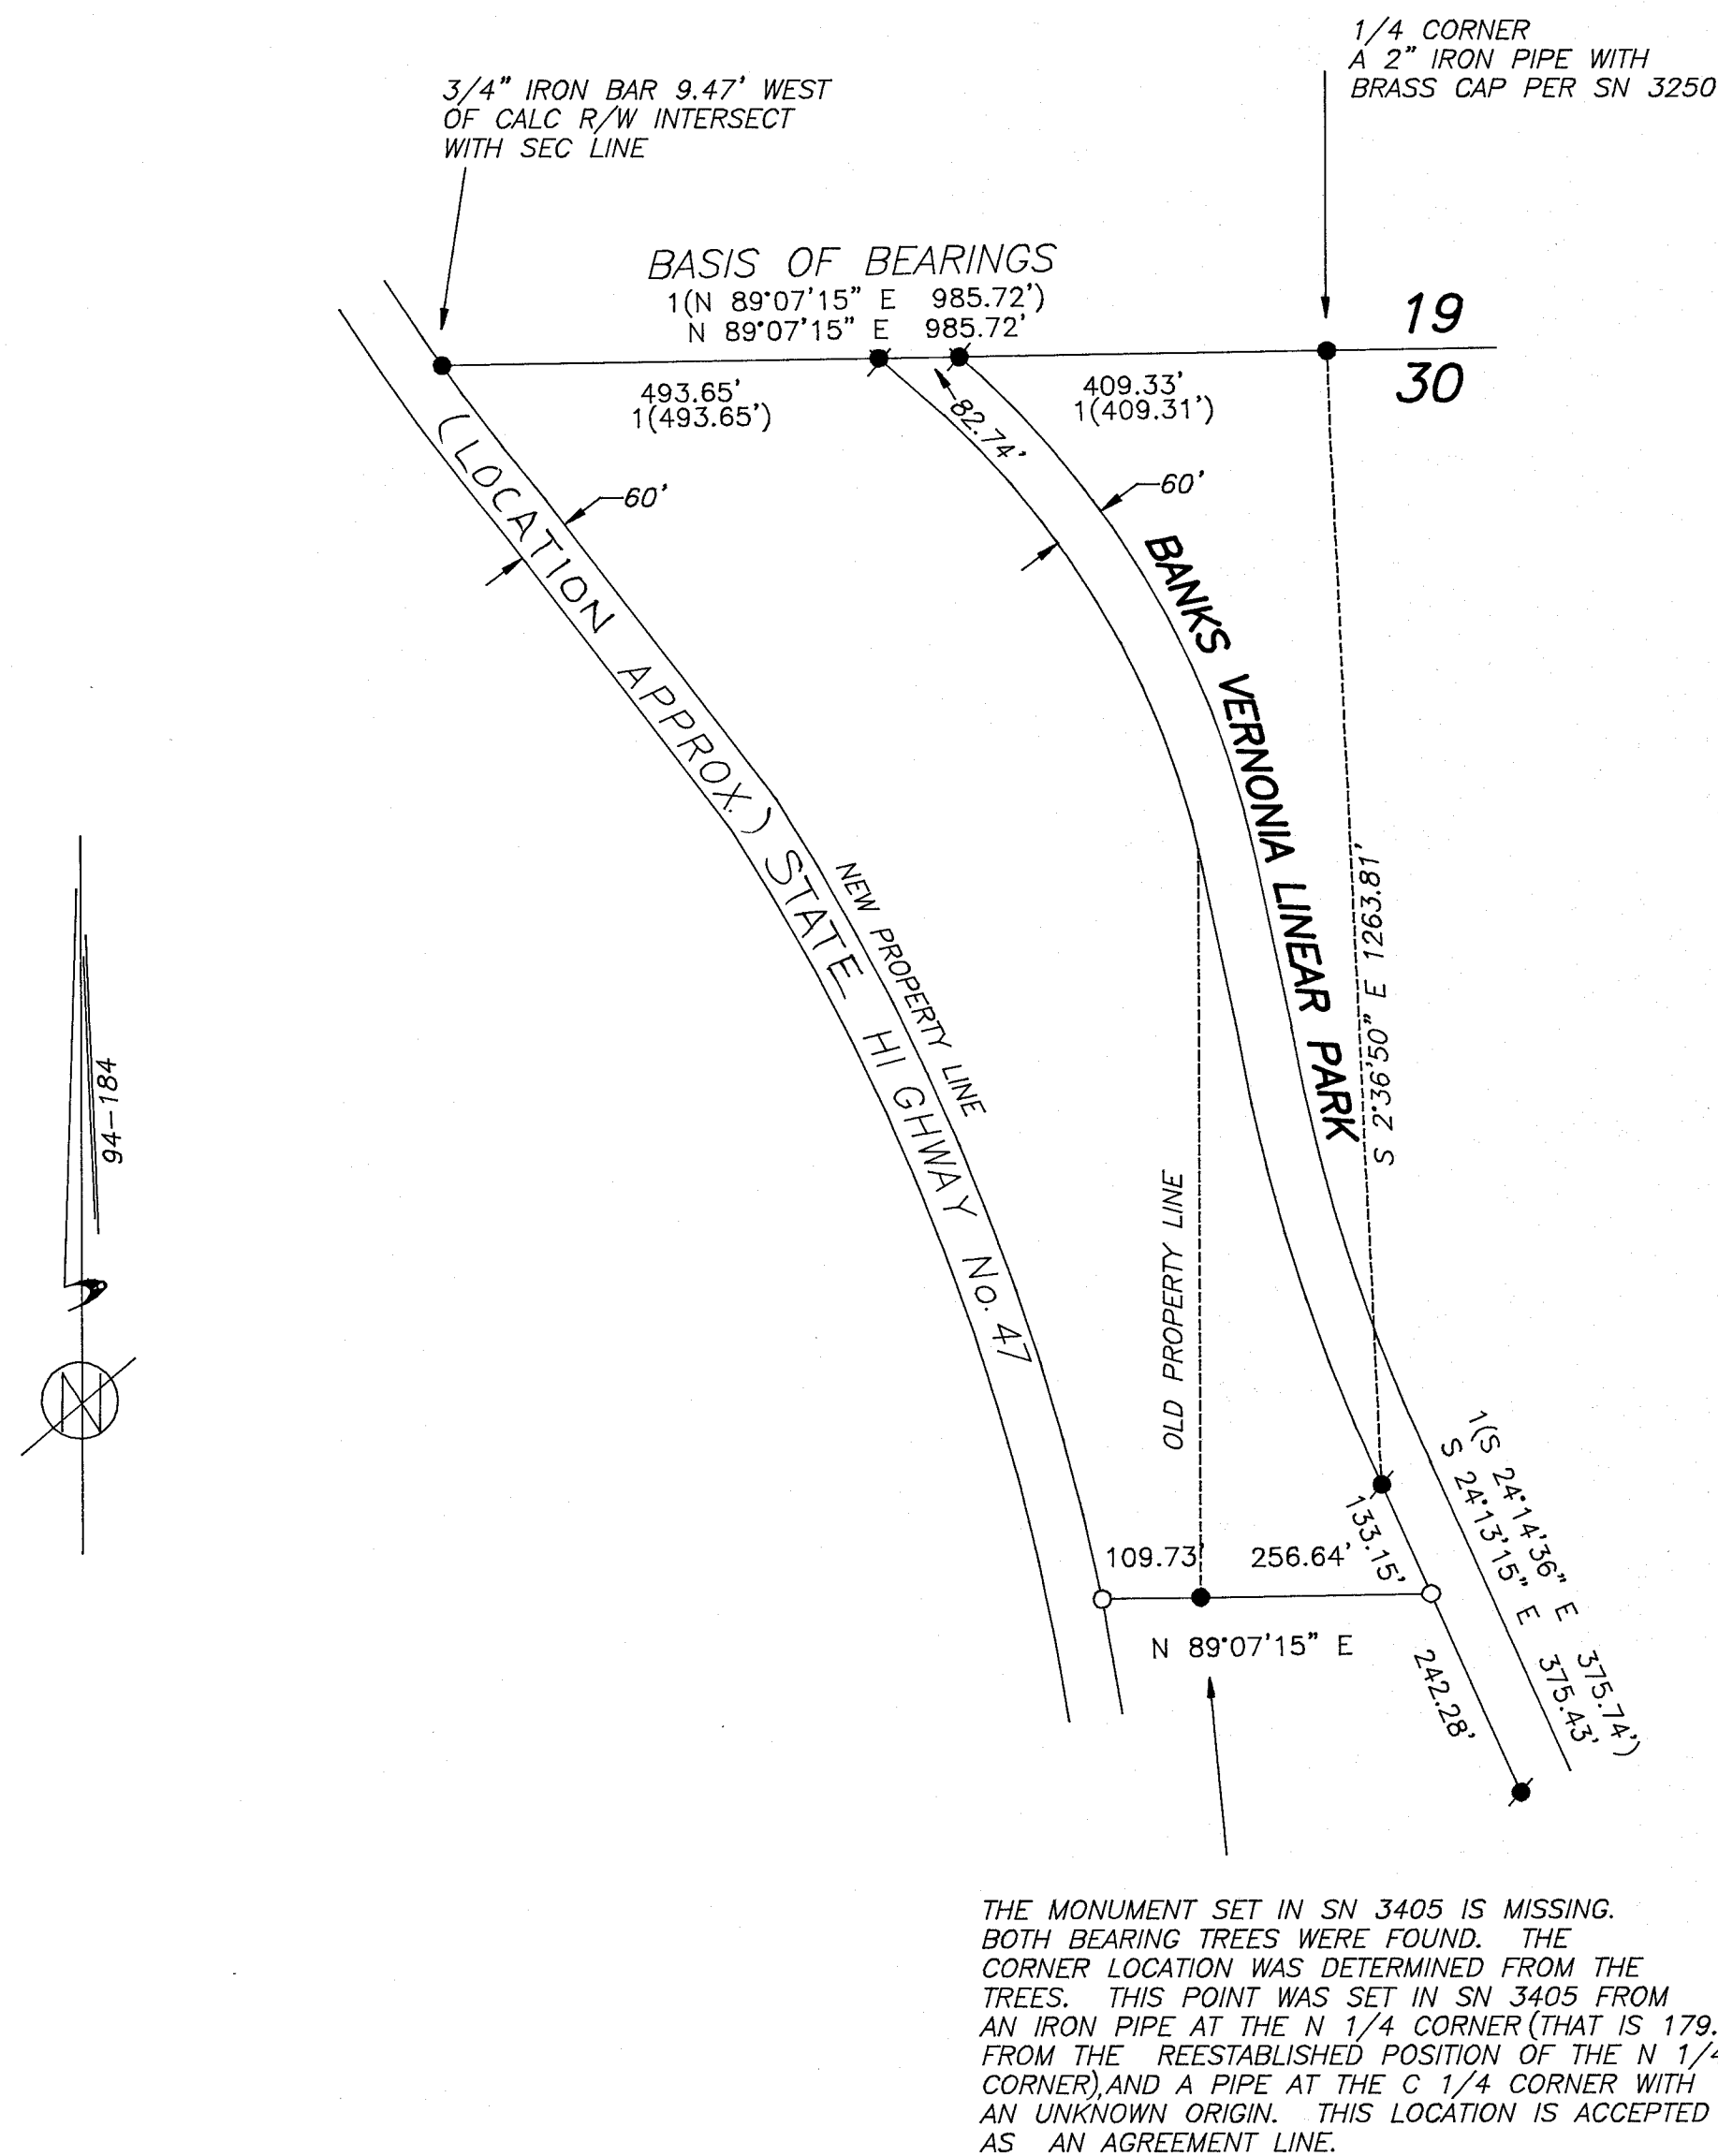

NARRATIVE:

THIS SURVEY WAS ACCOMPLISHED AT THE REQUEST OF BILL AND CAROL OSTRANDER TO MONUMENT A PROPERTY LINE ADJUSTMENT. THE OLD PROPERTY LINE WAS THE N-S CENTER LINE OF THE SECTION. THE NEW PROPERTY LINE IS THE EAST RIGHT-OF-WAY LINE OF STATE HIGHWAY No. 47. THE SOUTH LINE OF THE PROPERTY IS DEEDED AT 1200' NORTH OF AND PARALLEL TO THE E-W CENTER LINE OF THE SECTION. FOR THE SOUTH LINE WE HELD THE LOCATION OF THE MONUMENT SET IN SURVEY No. 3405 BY LONGVIEW FIBRE CO. I HELD A LINE THROUGH THIS POINT AND PARALLEL TO THE NORTH LINE OF THE NW 1/4 AS REQUESTED BY THE OSTRANDERS AND LONGVIEW FIBRE CO. FOR AN AGREEMENT LINE.


LEGEND

- = 5/8" IRON ROD WITH A Y.P.C. MARKED "OREGON STATE PARKS" PER SN 3841
- = MONUMENT FOUND AS NOTED
- = SET A 5/8" X 30" IRON ROD WITH A YELLOW PLASTIC CAP MARKED "KEENON LAND SERVICES INC."
- () = RECORD DATA 1 = RS 3841
- SN = RECORD SURVEY NO.

REGISTERED
PROFESSIONAL
LAND SURVEYOR

Leslie G. Keenon

OREGON
JULY 30, 1976
LESLIE G. KEENON
1080
RENEWAL DATE 6/30/95

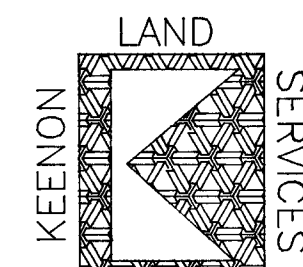

1224 ALDER ST.
VERNONIA, OR
97064
(503) 429-6115

COLUMBIA COUNTY SURVEYORS OFFICE
RECIEVED 11-13-94
ACCEPTED FOR FILING 12-28-94