
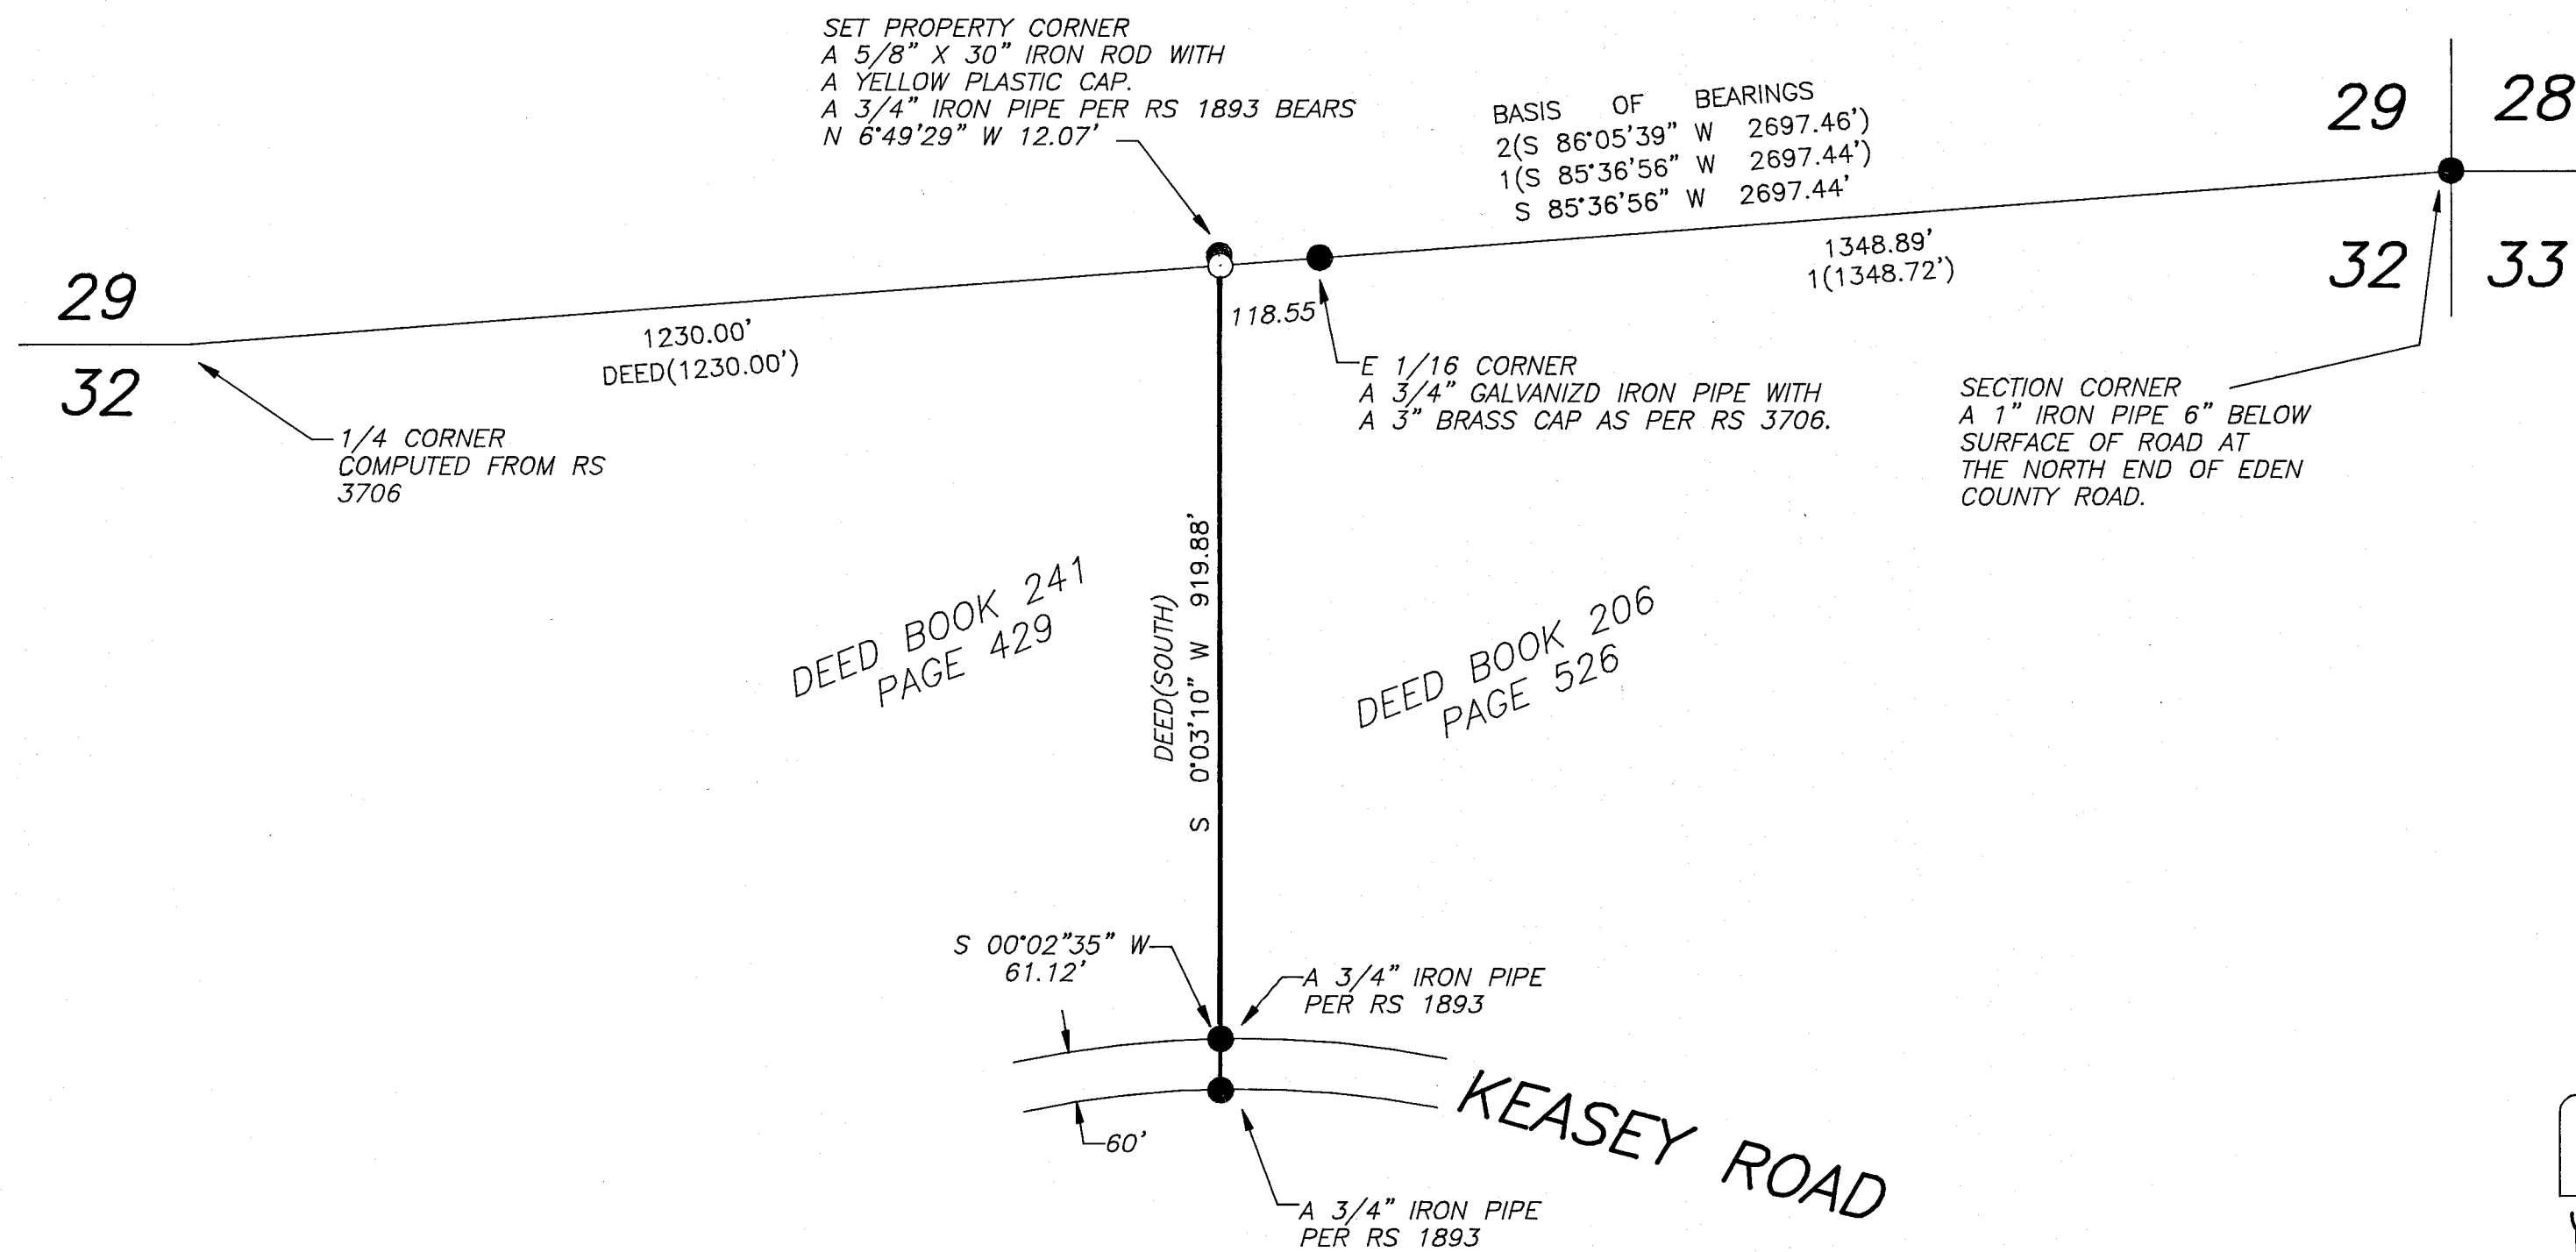


RECORD OF SURVEY  
FOR EVELYN HOLCE AND JACK FINZEL  
IN THE NE 1/4 OF SEC 28, T5N, R4W, W.M.  
COLUMBIA COUNTY, OREGON  
SCALE 1" = 200'      AUG 10, 1994

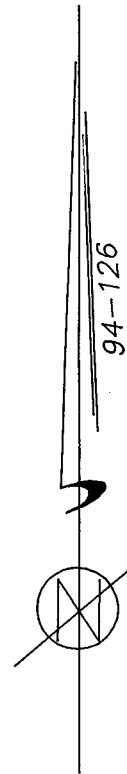

NARRATIVE  
THE PURPOSE OF THIS SURVEY WAS TO MARK AND MONUMENT THE LINE AS SHOWN.  
THE BASIS OF BEARINGS IS THE NORTH LINE OF THE NE 1/4 OF NE 1/4 FROM RS 3706.

PROCEDURE

1. I HELD THE 1" IRON PIPE FOR THE SECTION CORNER.
2. I HELD THE 3/4" IRON PIPE WITH A 3" BRASS CAP FOR THE E 1/16 CORNER AS PER RS 3706.
3. I COMPUTED THE 1/4 CORNER HOLDING THE RECORD DISTANCE FROM THE SECTION CORNER AS PER RS 3706.
4. I HELD THE 3/4" IRON PIPES ON THE NORTH AND SOUTH EDGES OF KEASEY ROAD AS PER RS 1893.
5. I ESTABLISHED THE NW CORNER OF THE TRACT AT THE DEEDED DISTANCE FROM THE 1/4 CORNER.


LEGEND

- = MONUMENT FOUND AS NOTED
- = SET A 5/8" X 30" IRON ROD WITH A YELLOW PLASTIC CAP MARKED "KEENON LS 1080"
- ( ) = RECORD DATA 1 = RS 3706  
2 = RS 1893
- RS = RECORD SURVEY NO.

REGISTERED  
PROFESSIONAL  
LAND SURVEYOR

*Leslie G. Keenon*

OREGON  
JULY 30, 1976  
LESLIE G. KEENON  
1080  
RENEWAL DATE 6/30/95

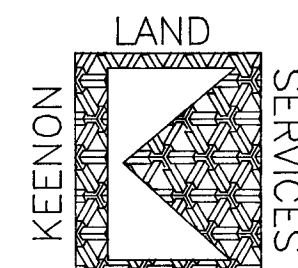

1224 ALDER ST.  
VERNONIA, OR  
97064  
(503) 429-6115

COLUMBIA COUNTY SURVEYORS OFFICE  
RECEIVED 9-28-94  
ACCEPTED FOR FILING 10-4-94